


PARENT PARCEL: 07-00-028-101-017

CHILD PARCEL:

STARTING POINT: NORTHEAST CORNER OF LAND CONVEYED TO MAGARITE C. & ELLIS B. CAWOOD (DV 292/83)

19-04014-A

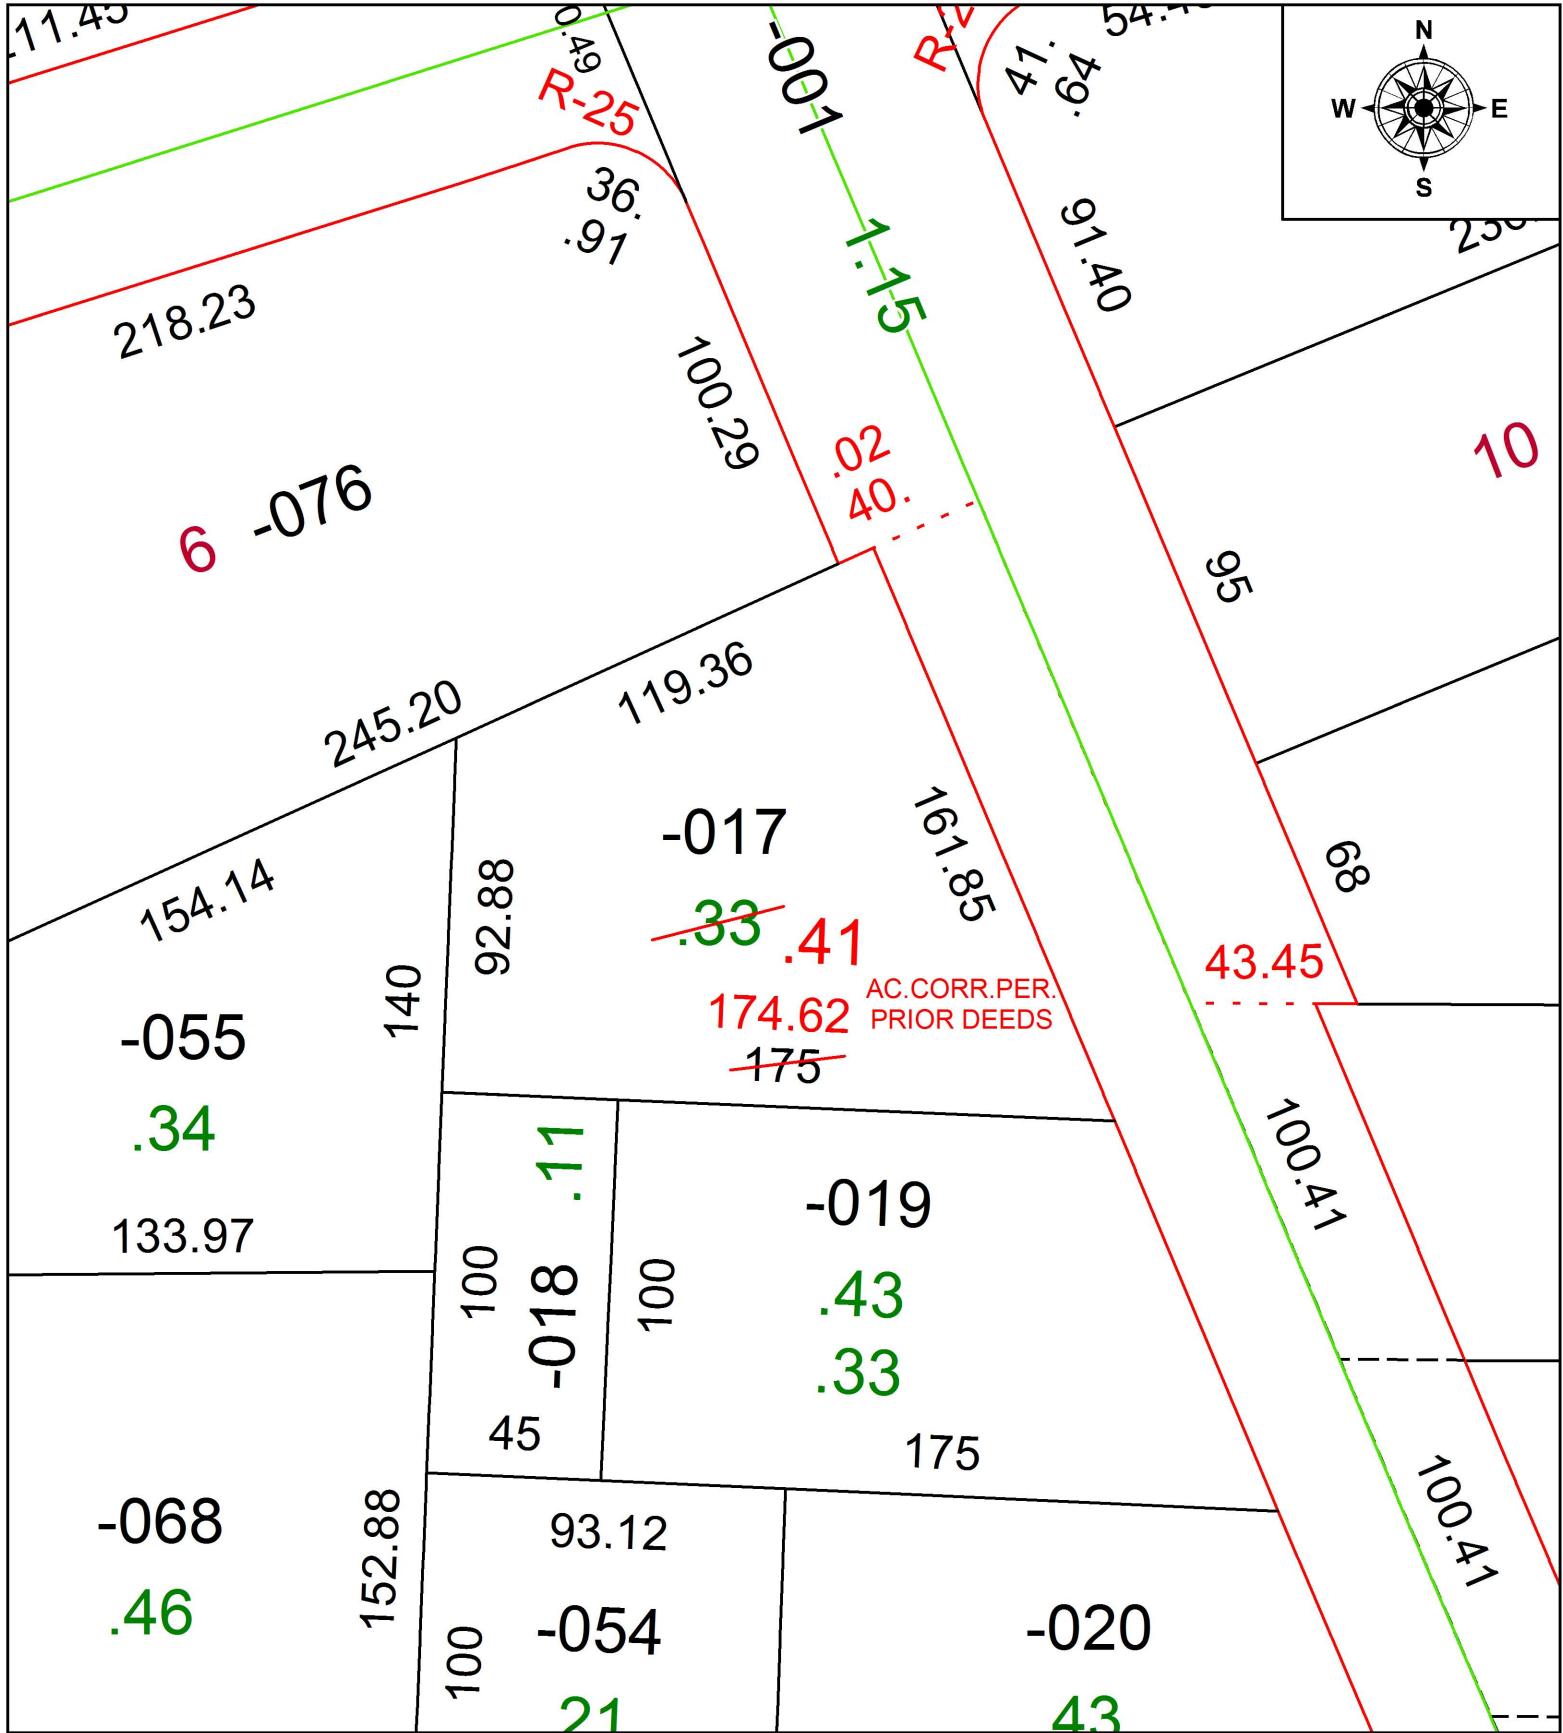

SPLITS/DEEDS PROCESSED
 LORAIN COUNTY TAX MAP DEPARTMENT
 226 MIDDLE AVE. ELYRIA, OH

SURVEYED BY: _____ N/A
 CLOSURE: _____ 1: 24,181
 MAP PAGE(S): _____ 7-00-028
 APPROVED BY: _____ RRM DATE: _____ 1-4-19
 SCALE: _____ 1" = 50 _____ PRIOR INSTRUMENT: _____ 20180699687