


PARENT PARCEL: 06-21-003-101-008

CHILD PARCEL:


STARTING POINT:

INTERSECTION OF C/L OF NORTH RIDGE RD, AND C/L OF LAKE AVE.

19-04015-D

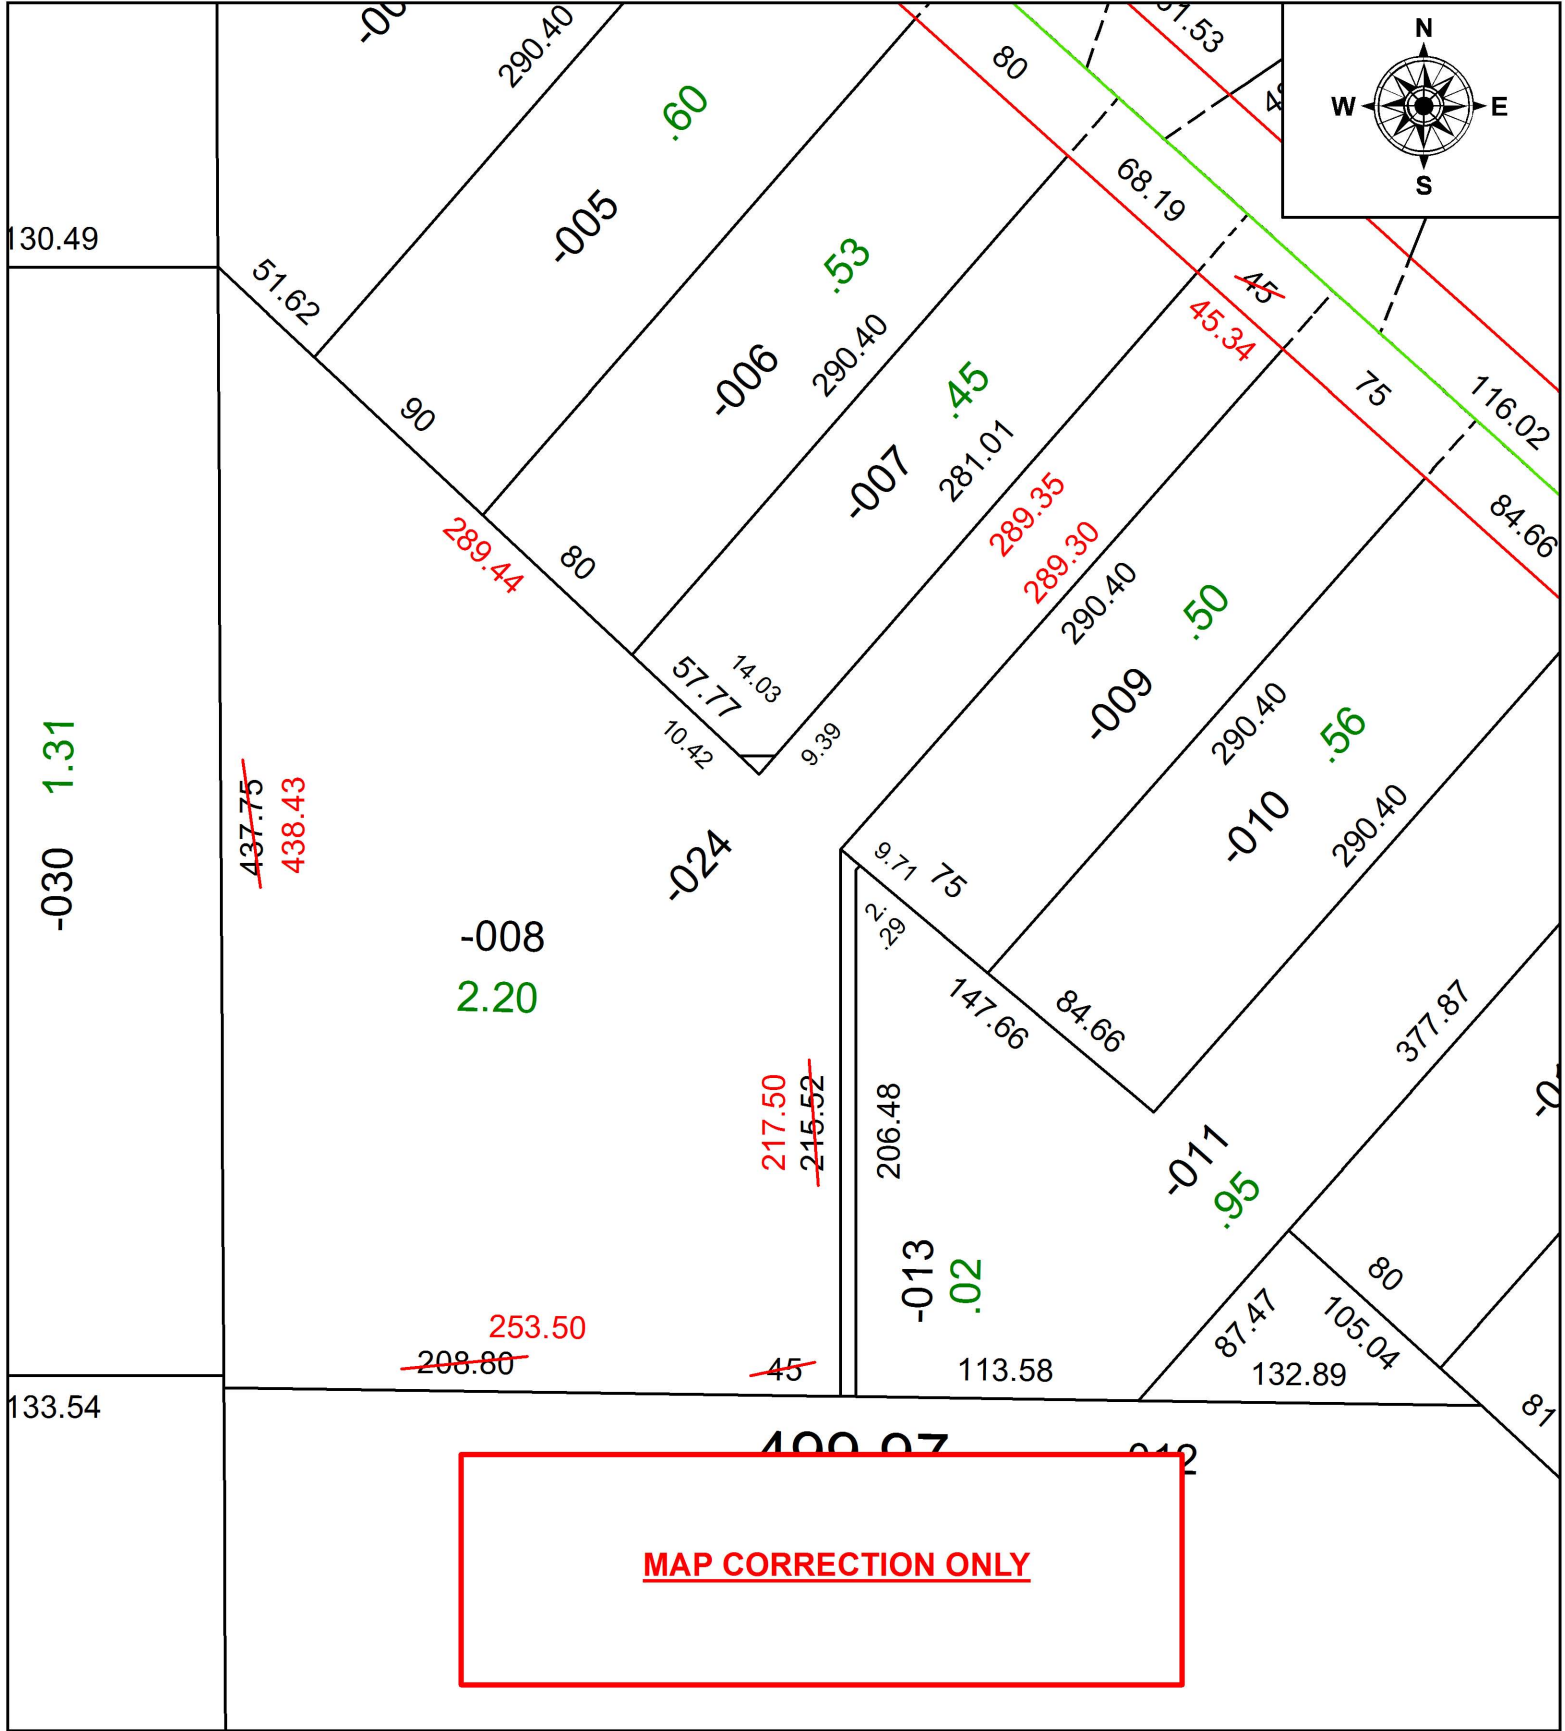

**MAP CORRECTION ONLY**

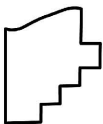

**SPLITS/DEEDS PROCESSED**  
LORAIN COUNTY TAX MAP DEPARTMENT  
226 MIDDLE AVE. ELYRIA, OH

SURVEYED BY:	THOMAS A. SIMON
CLOSURE:	1: 181,852
MAP PAGE(S):	6-21-003
APPROVED BY:	RRM DATE: 1-7-19
SCALE:	1" = 75' PRIOR INSTRUMENT: 20070199433