


PARENT PARCEL: 19-01-025-000-010

CHILD PARCEL:

STARTING POINT: SOUTHEAST CORNER OF LAND CONVEYED TO JOHN CHRISTY (DV 49/428)

19-04016-A

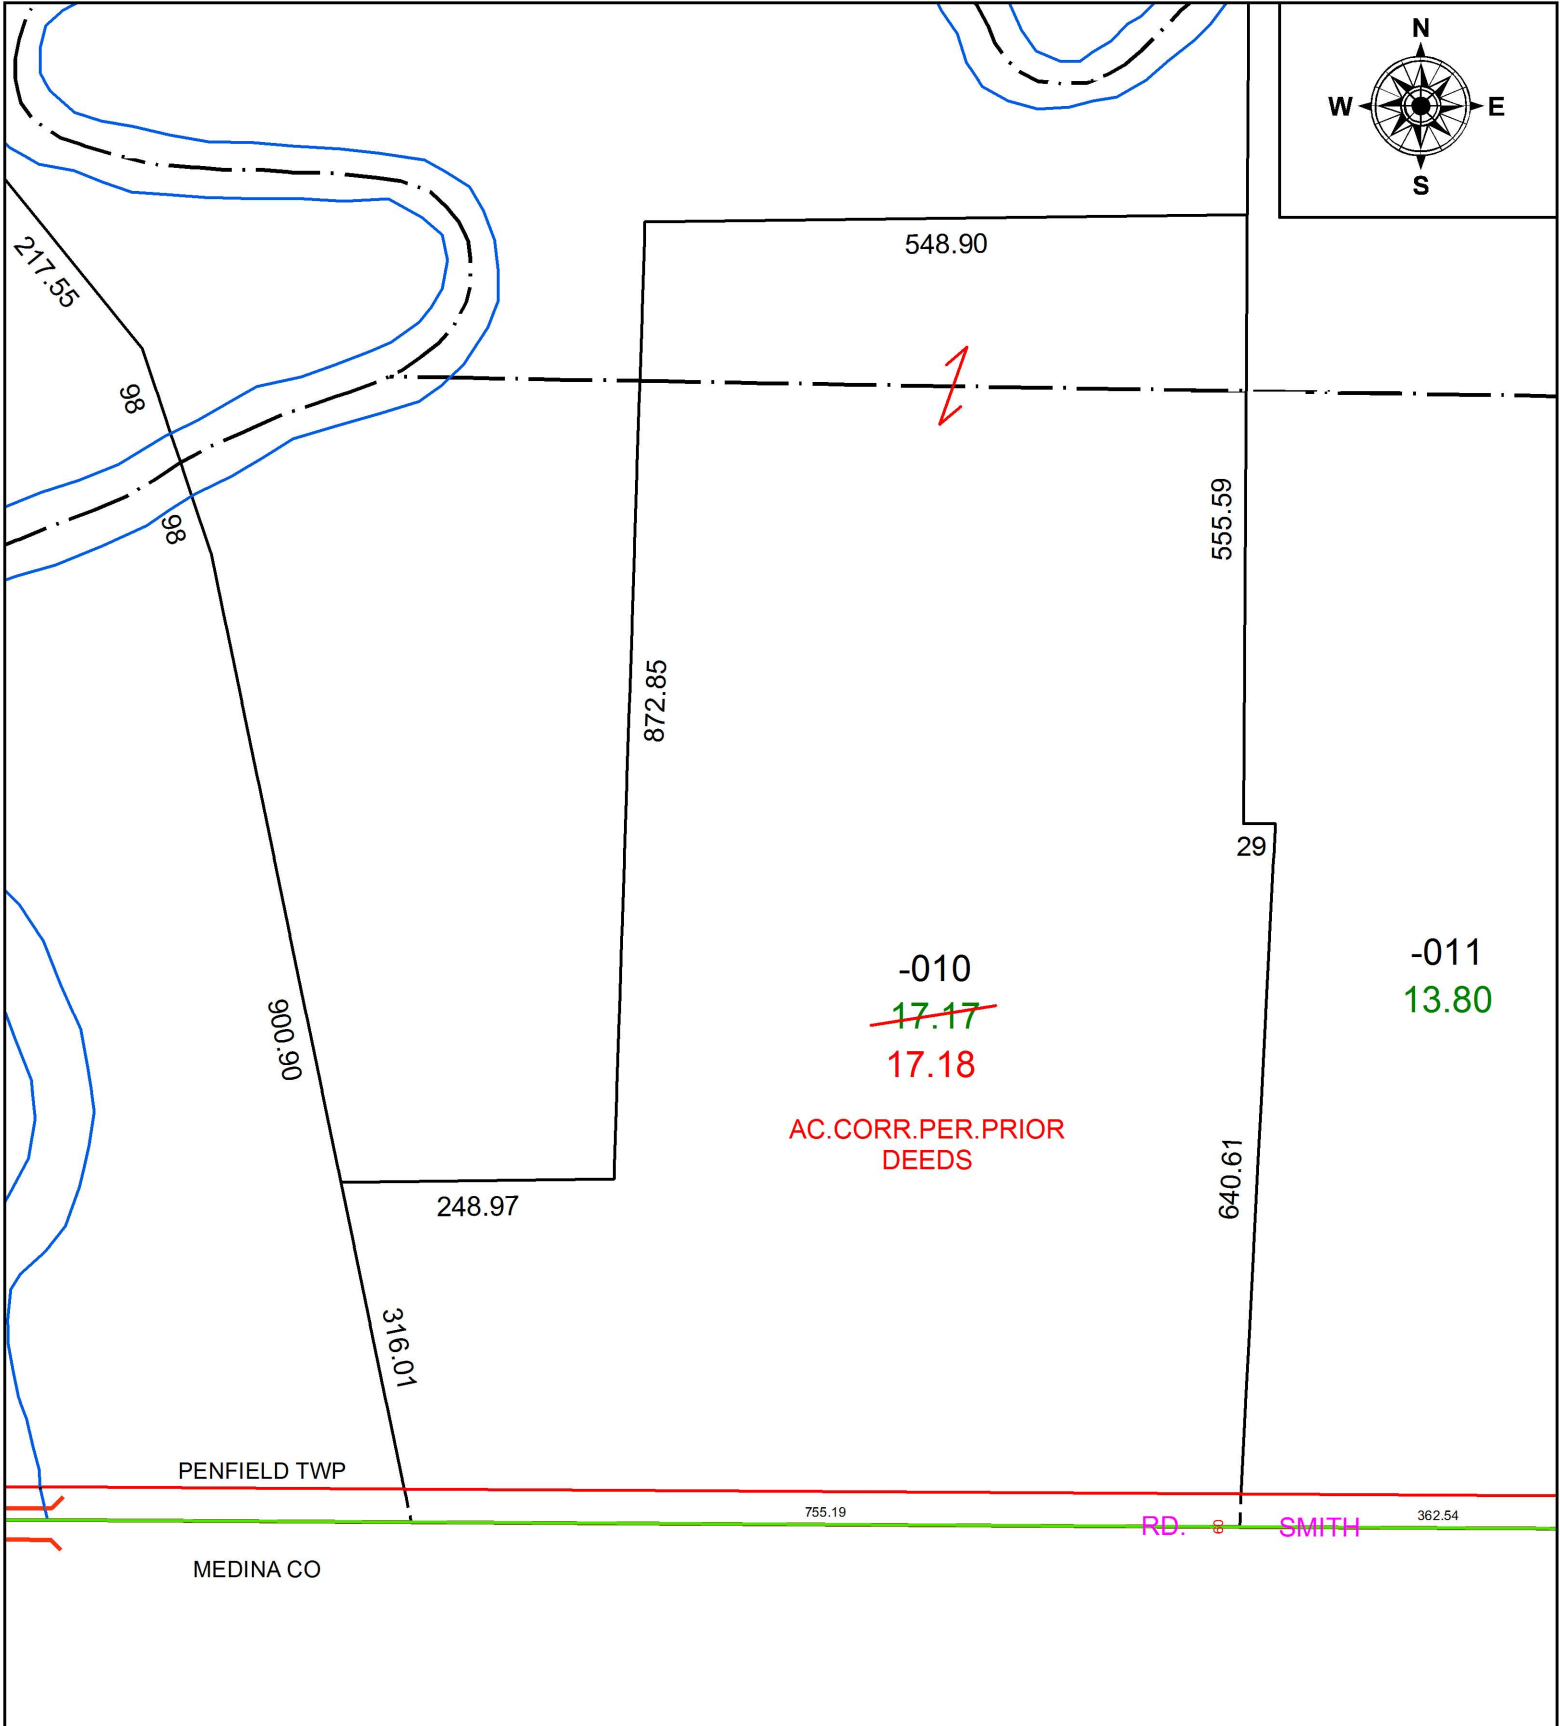


-010
~~17.17~~
 17.18
 AC.CORR.PER.PRIOR
 DEEDS

-011
 13.80

PENFIELD TWP

MEDINA CO

RD. SMITH

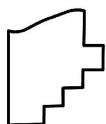

SPLITS/DEEDS PROCESSED
 LORAIN COUNTY TAX MAP DEPARTMENT
 226 MIDDLE AVE. ELYRIA, OH

SURVEYED BY: N/A
 CLOSURE: 1: 18,202
 MAP PAGE(S): 19-01-025
 APPROVED BY: RRM DATE: 1-7-19
 SCALE: 1" = 175 PRIOR INSTRUMENT: 20160575542