
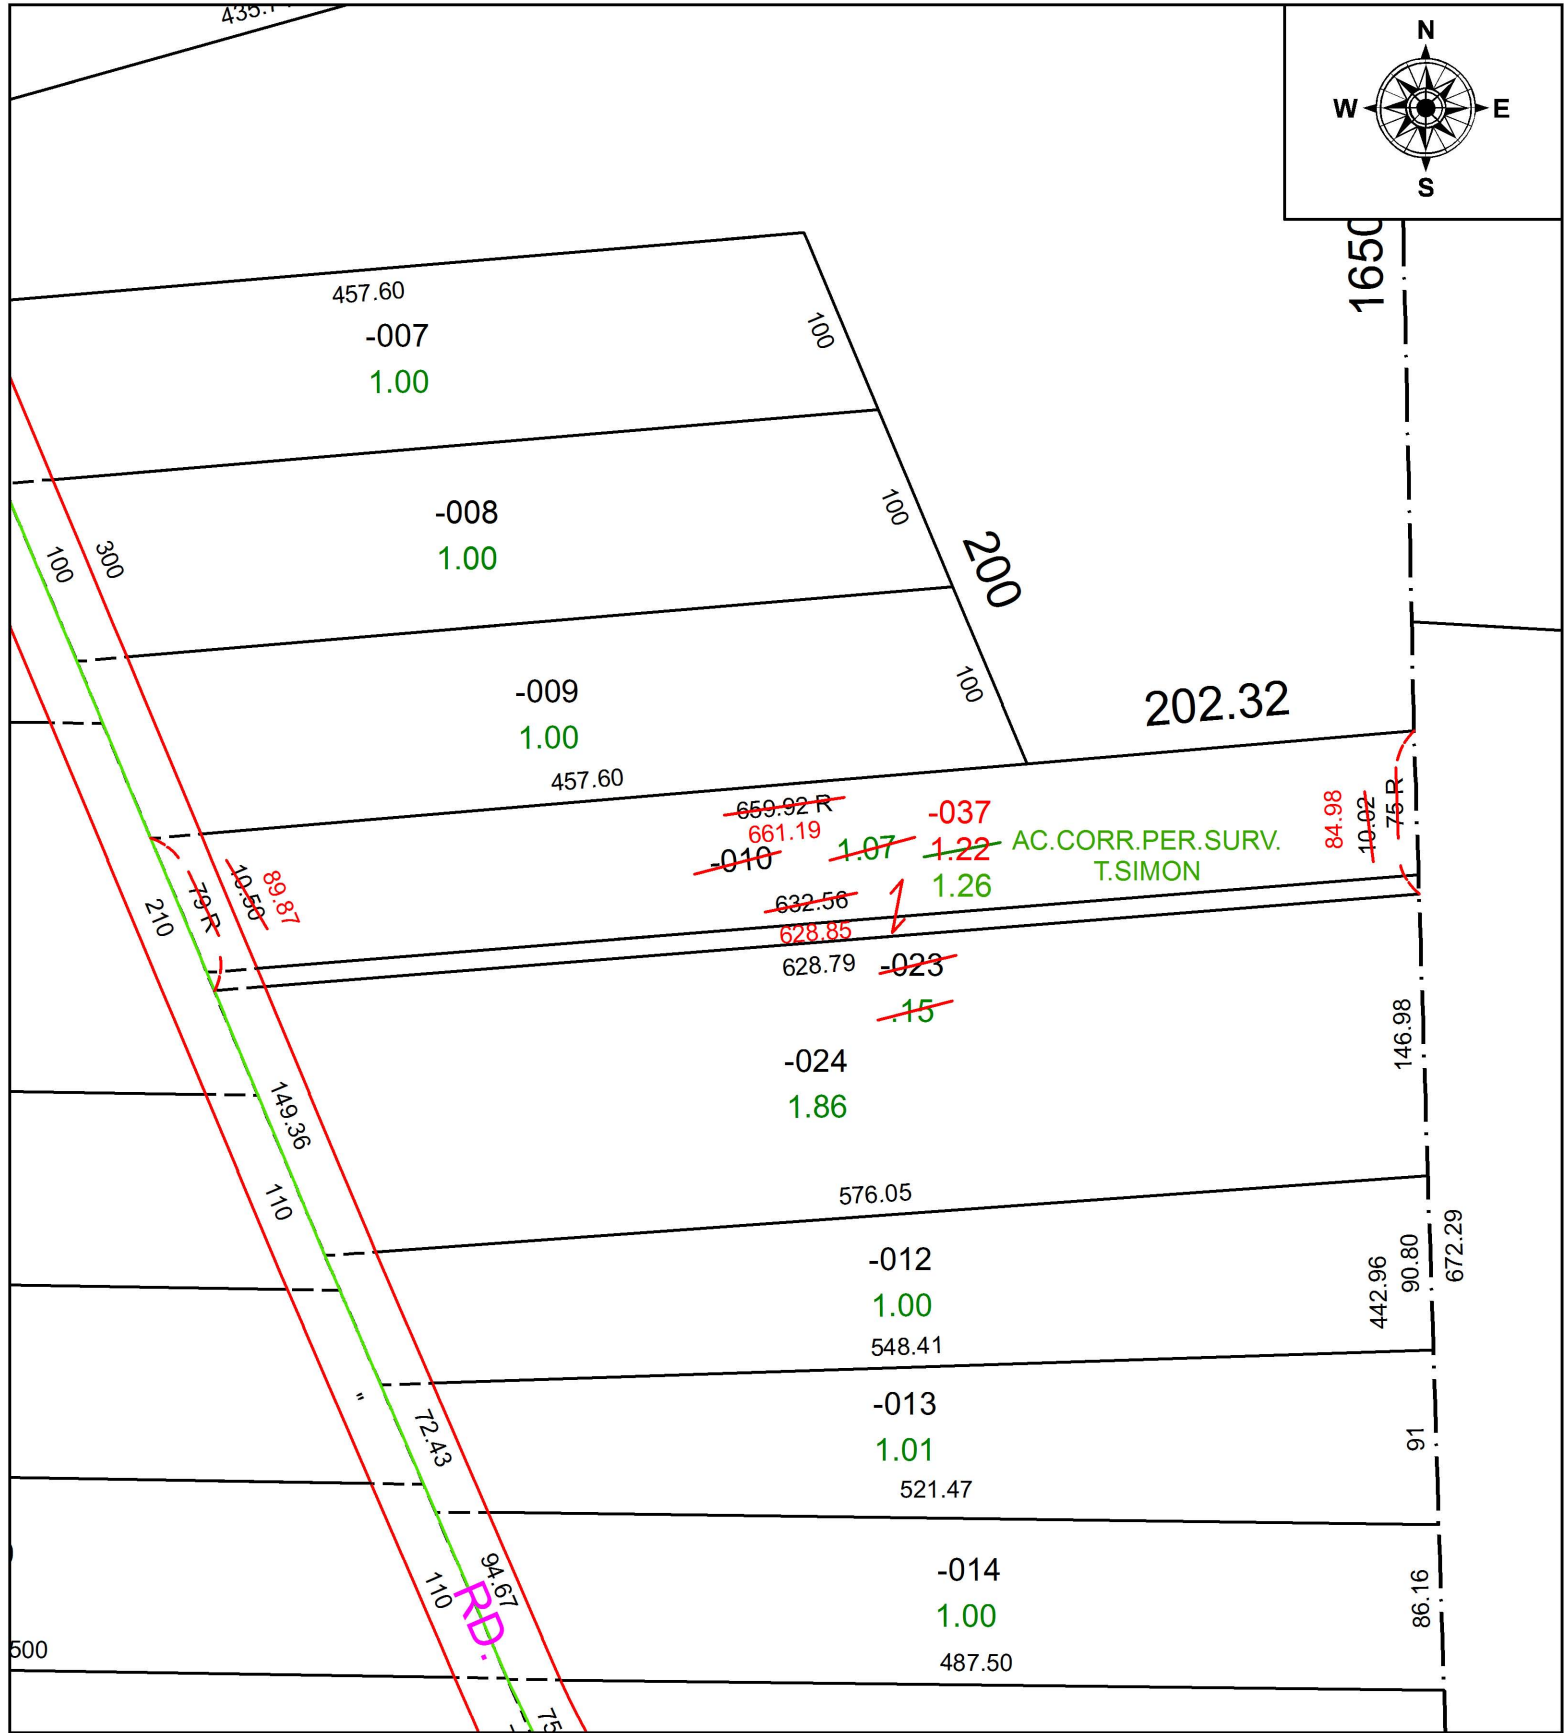


PARENT PARCEL: 01-00-037-103-010, -023

CHILD PARCEL: 01-00-037-103-037

STARTING POINT: INTERSECTION OF C/L OF NORTH RIDGE RD, AND C/L OF CLAUS RD.

19-04020

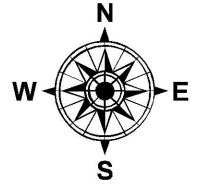

SPLITS/DEEDS PROCESSED
 LORAIN COUNTY TAX MAP DEPARTMENT
 226 MIDDLE AVE. ELYRIA, OH

SURVEYED BY: THOMAS A. SIMON

CLOSURE: 1:710,075

MAP PAGE(S): 1-00-037

APPROVED BY: RRM DATE: 9-16-19

SCALE: 1" = 100 PRIOR INSTRUMENT: 20170625904