


PARENT PARCEL: 12-00-069-000-020

CHILD PARCEL:

STARTING POINT: NORTHEAST CORNER OF O.L.69

19-04022-A

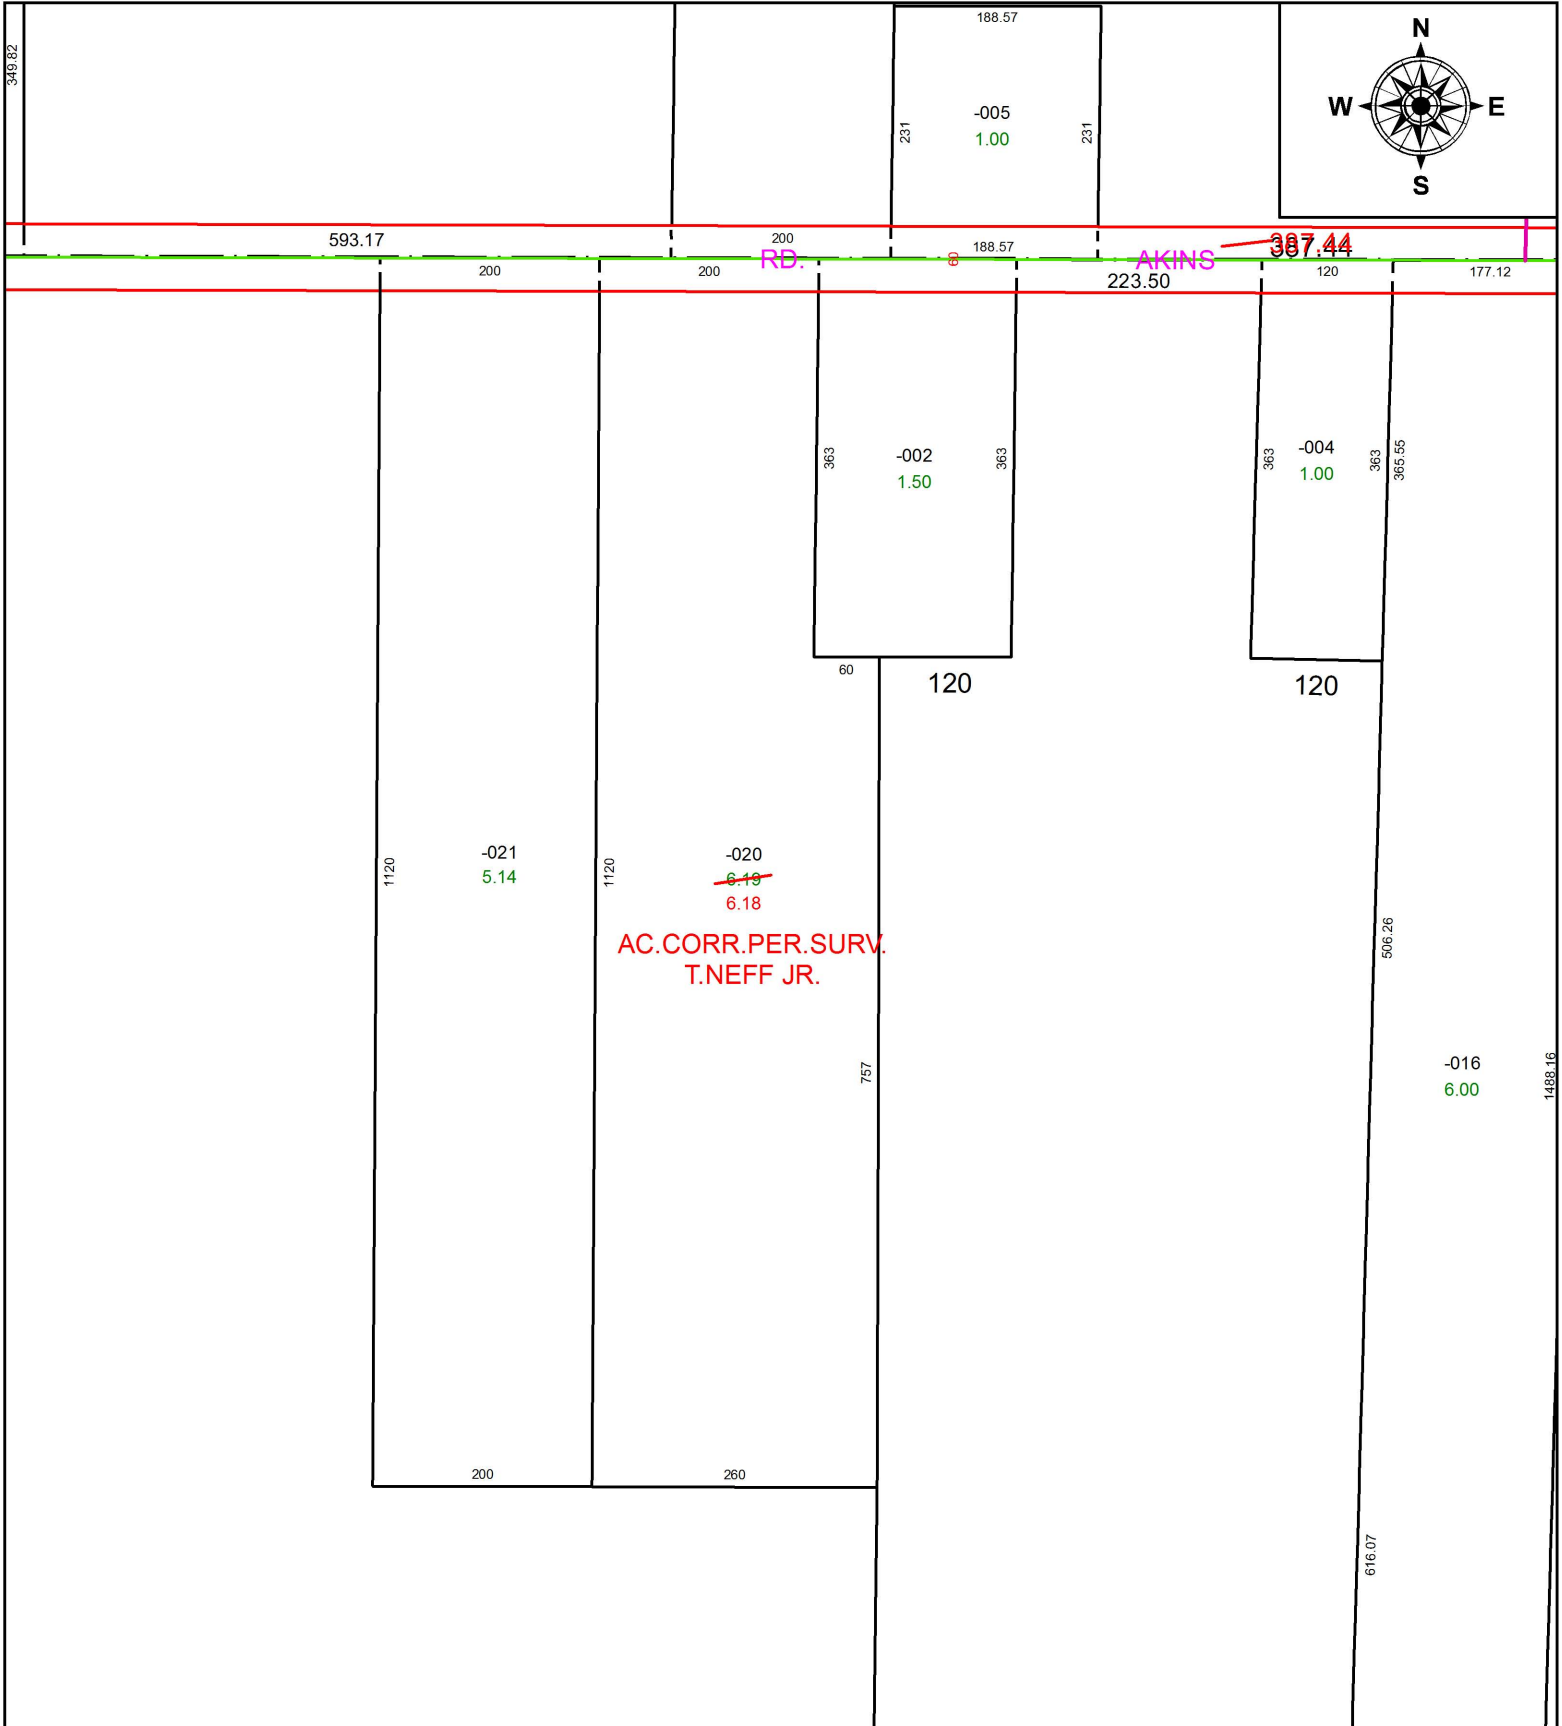

SPLITS/DEEDS PROCESSED
 LORAIN COUNTY TAX MAP DEPARTMENT
 226 MIDDLE AVE. ELYRIA, OH

SURVEYED BY: THOMAS J. NEFF JR.
 CLOSURE: 1:2147483648
 MAP PAGE(S): 12-00-069
 APPROVED BY: RRM DATE: 1-10-19
 SCALE: 1" = 175 PRIOR INSTRUMENT: 20170652038