
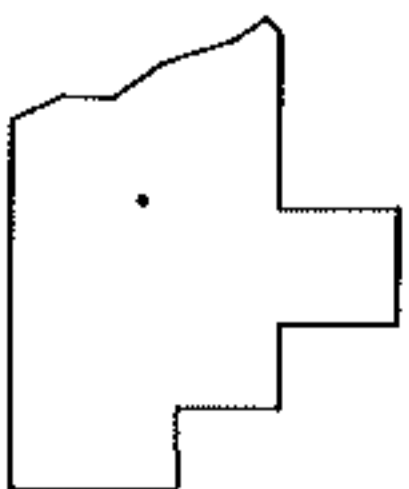
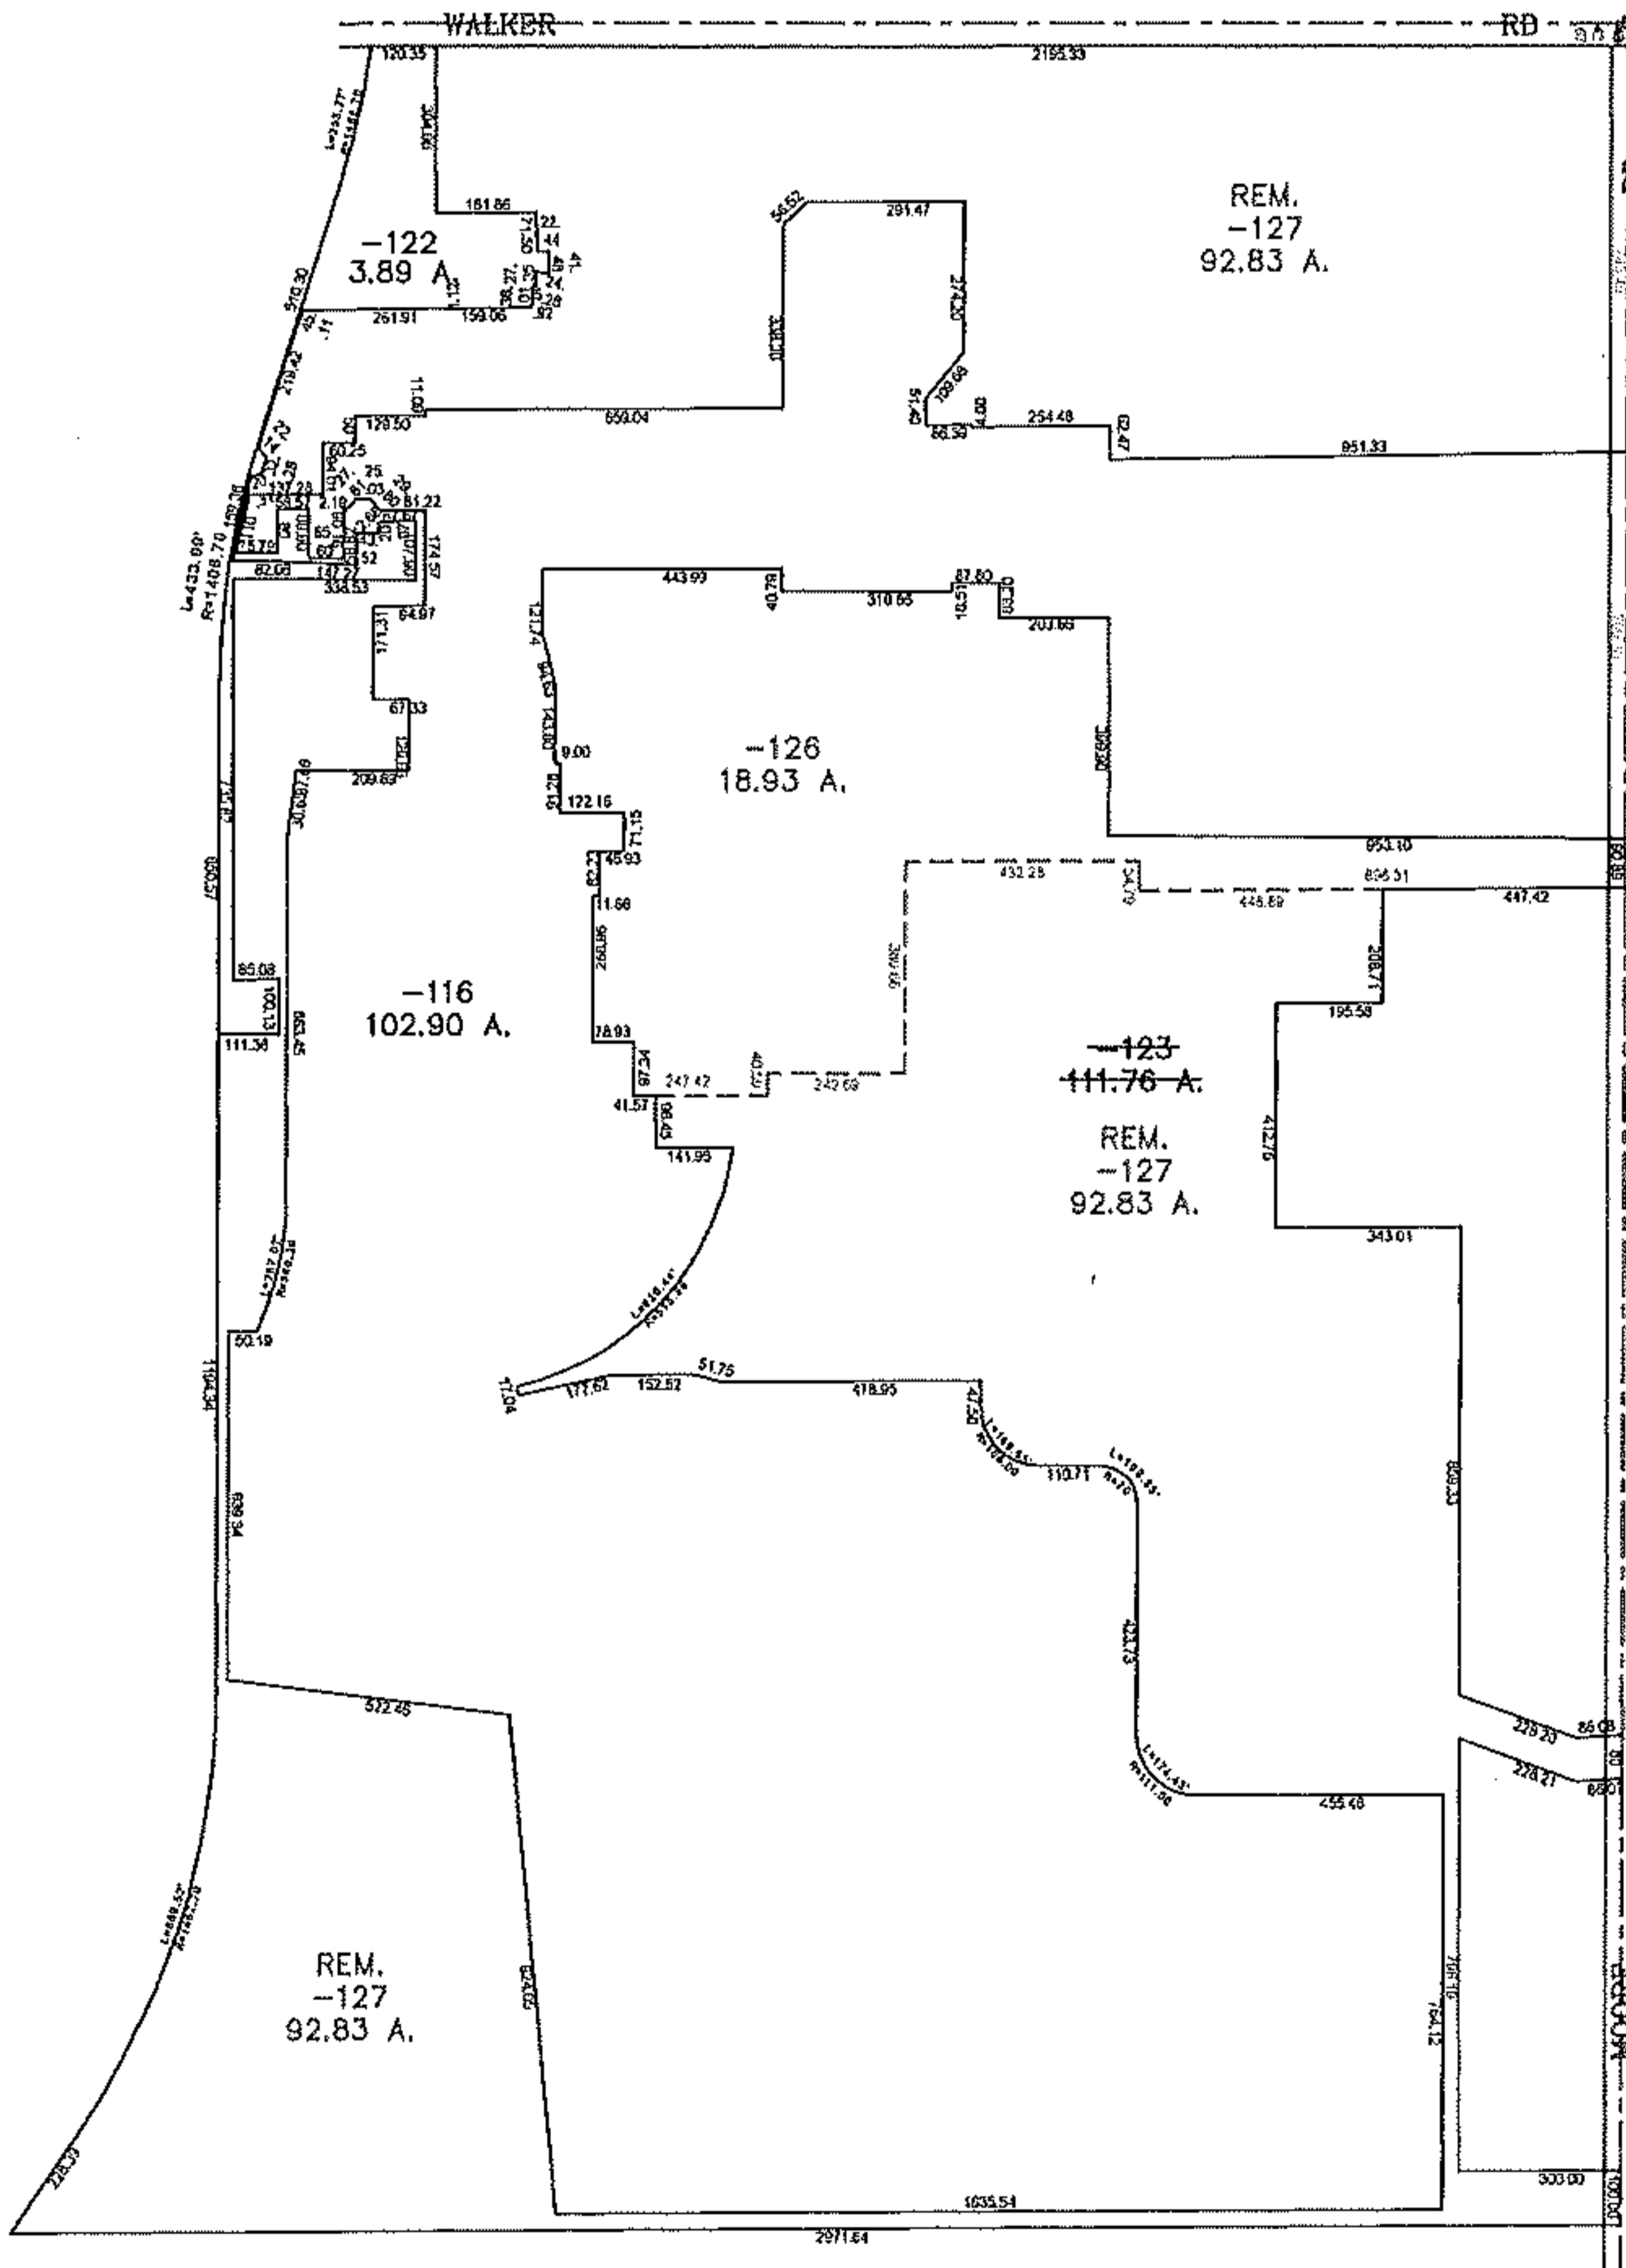


PARENT PARCEL: 04-00-005-000-123

CHILD PARCEL: 04-00-005-000-126 & -127

STARTING POINT: CENTERLINE OF WALKER RD & MOORE RD

19-04022

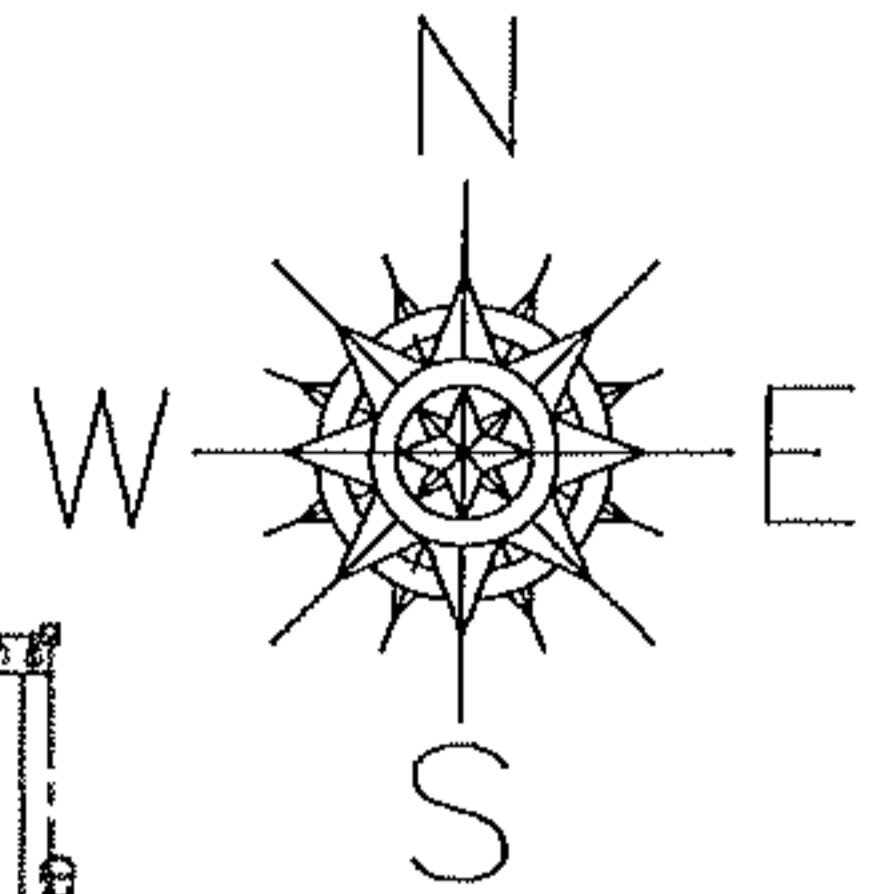

SPLITS/DEEDS PROCESSED

LORAIN COUNTY TAX MAP DEPARTMENT
226 MIDDLE AVE. ELYRIA, OHIO

SURVEYED BY: AMY KELLY
CLOSURE: 0.00 ; 10,000
MAP PAGE(S): 04-00-005-D
APPROVED BY: TJS DATE: 9/19/19
SCALE: 1" = 600 PRIOR INSTRUMENT: 20130463427