
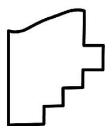


PARENT PARCEL: ADD TO DUP. PER PV. 1 PG. 6

CHILD PARCEL: 18-00-028-115-029 0.01 A. CALC.

STARTING POINT: PT. OF S/L 4 & PT. OF S/L 3 ORIGINAL WELLINGTON PLAT PV. 1 PG. 6

19-04028-A

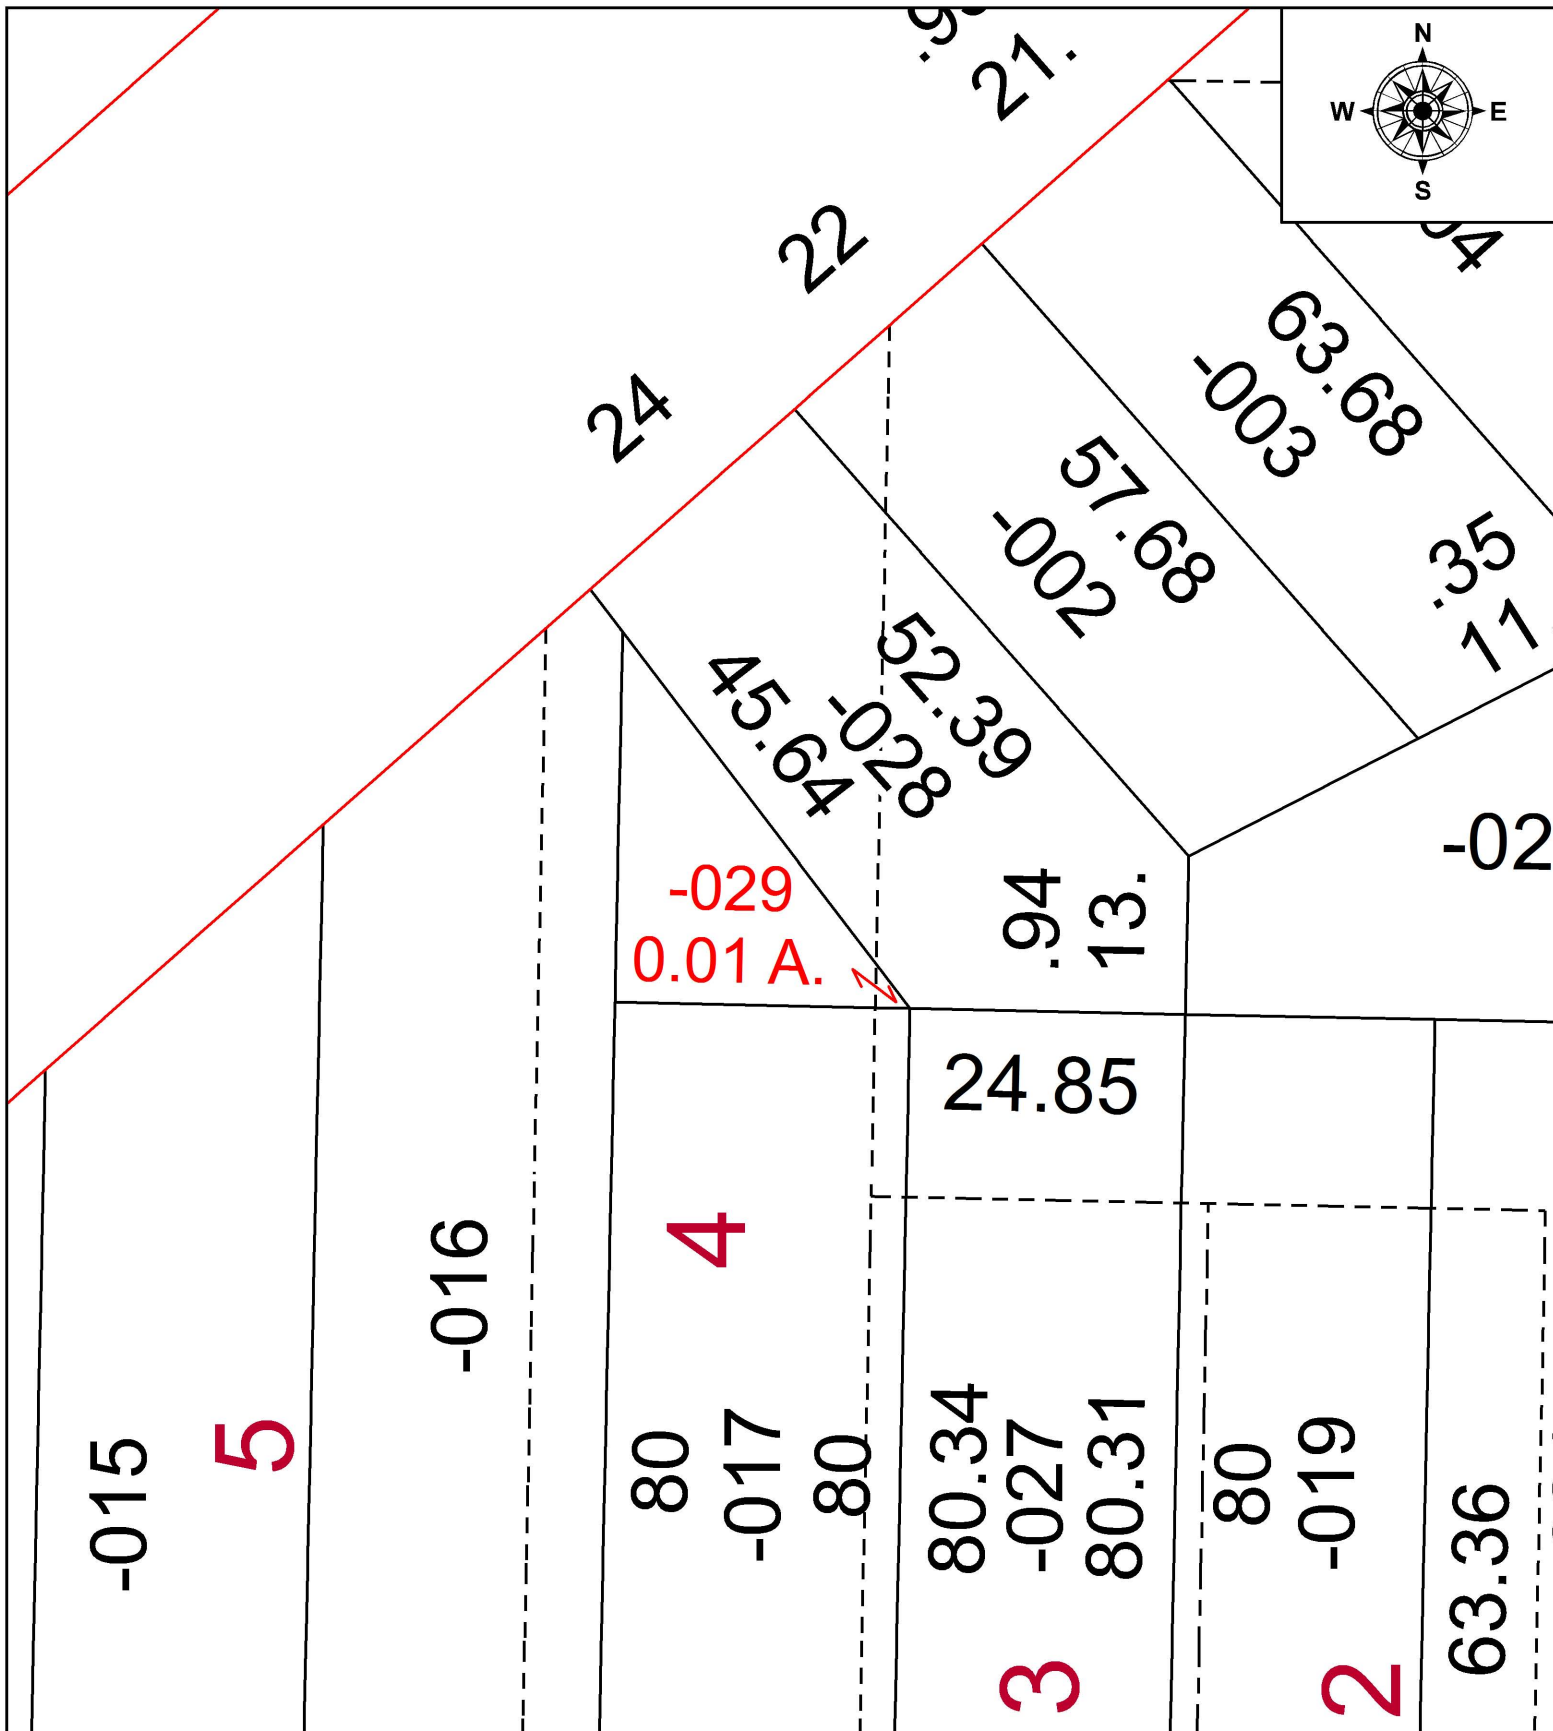

SPLITS/DEEDS PROCESSED
LORAIN COUNTY TAX MAP DEPARTMENT
226 MIDDLE AVE. ELYRIA, OH

SURVEYED BY:	NA
CLOSURE:	NA
MAP PAGE(S):	18-00-028
APPROVED BY:	TJS
DATE:	1/15/19
SCALE:	1" = 10'
PRIOR INSTRUMENT:	DV XXXX/XXXX