
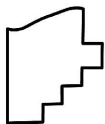


PARENT PARCEL: 03-00-042-103-032
 CHILD PARCEL: 03-00-042-103-042 THRU -044
 STARTING POINT: INTERSECTION OF SOUTH LINE OF LAKE RD. AND WEST LINE OF LAKE BREEZE ALLOT.

19-04031-C

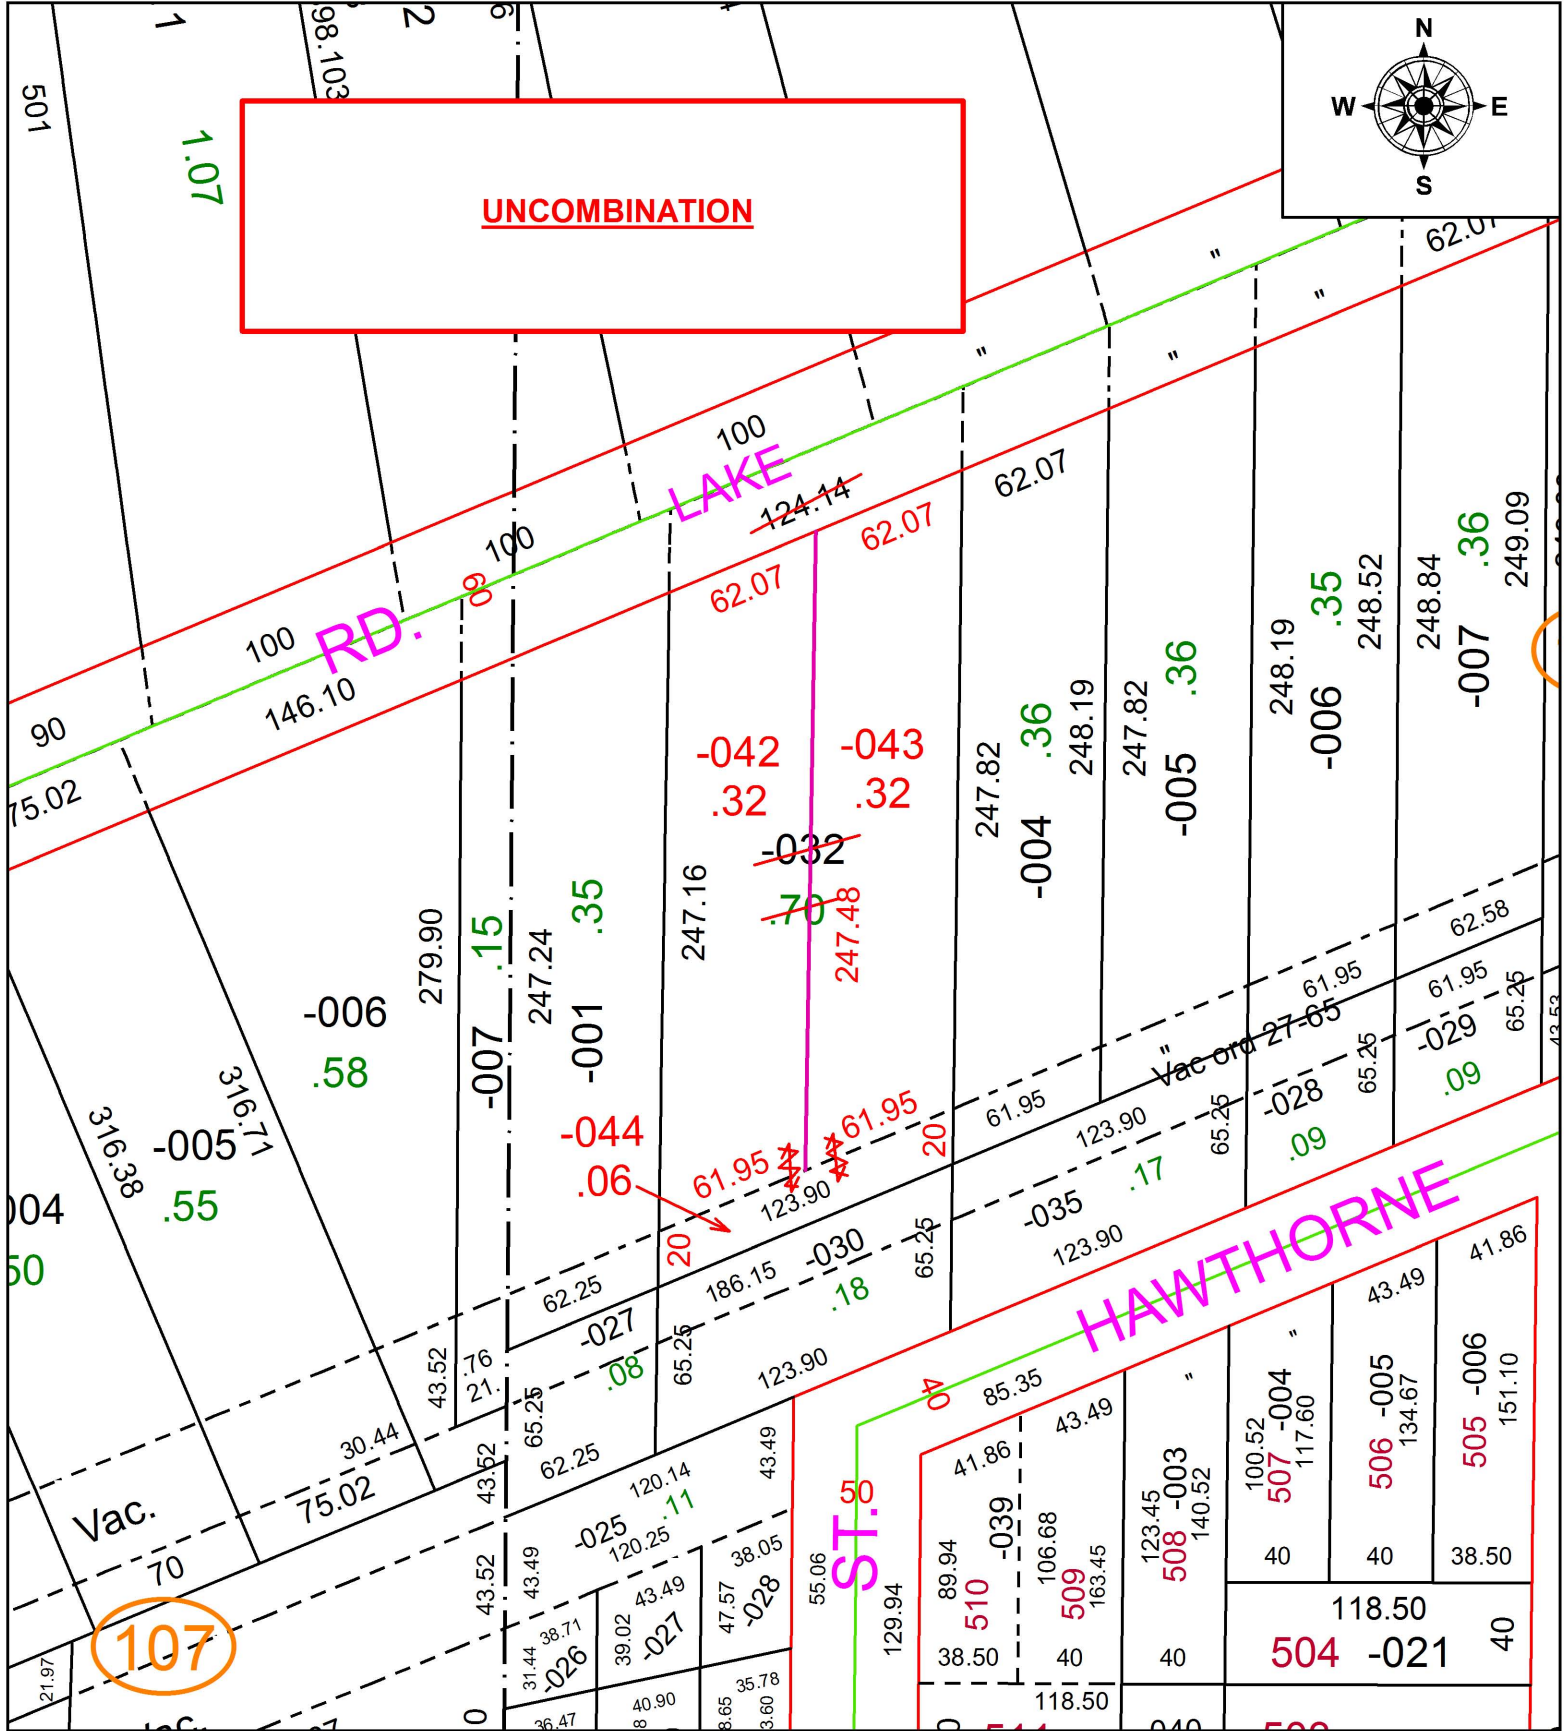

SPLITS/DEEDS PROCESSED
 LORAIN COUNTY TAX MAP DEPARTMENT
 226 MIDDLE AVE. ELYRIA, OH

SURVEYED BY: RAY E. HOLLIS
 CLOSURE: 1:42,609
 MAP PAGE(S): 3-00-042
 APPROVED BY: RRM DATE: 1-22-19
 SCALE: 1" = 75 PRIOR INSTRUMENT: 20180682947