


PARENT PARCEL: 15-00-099-102-085, -114

CHILD PARCEL: 15-00-099-102-085, -115, -116

STARTING POINT: NORTHWEST CORNER OF S/L 109 IN PHEASANT RUN VILLAGE PH.1

19-04032

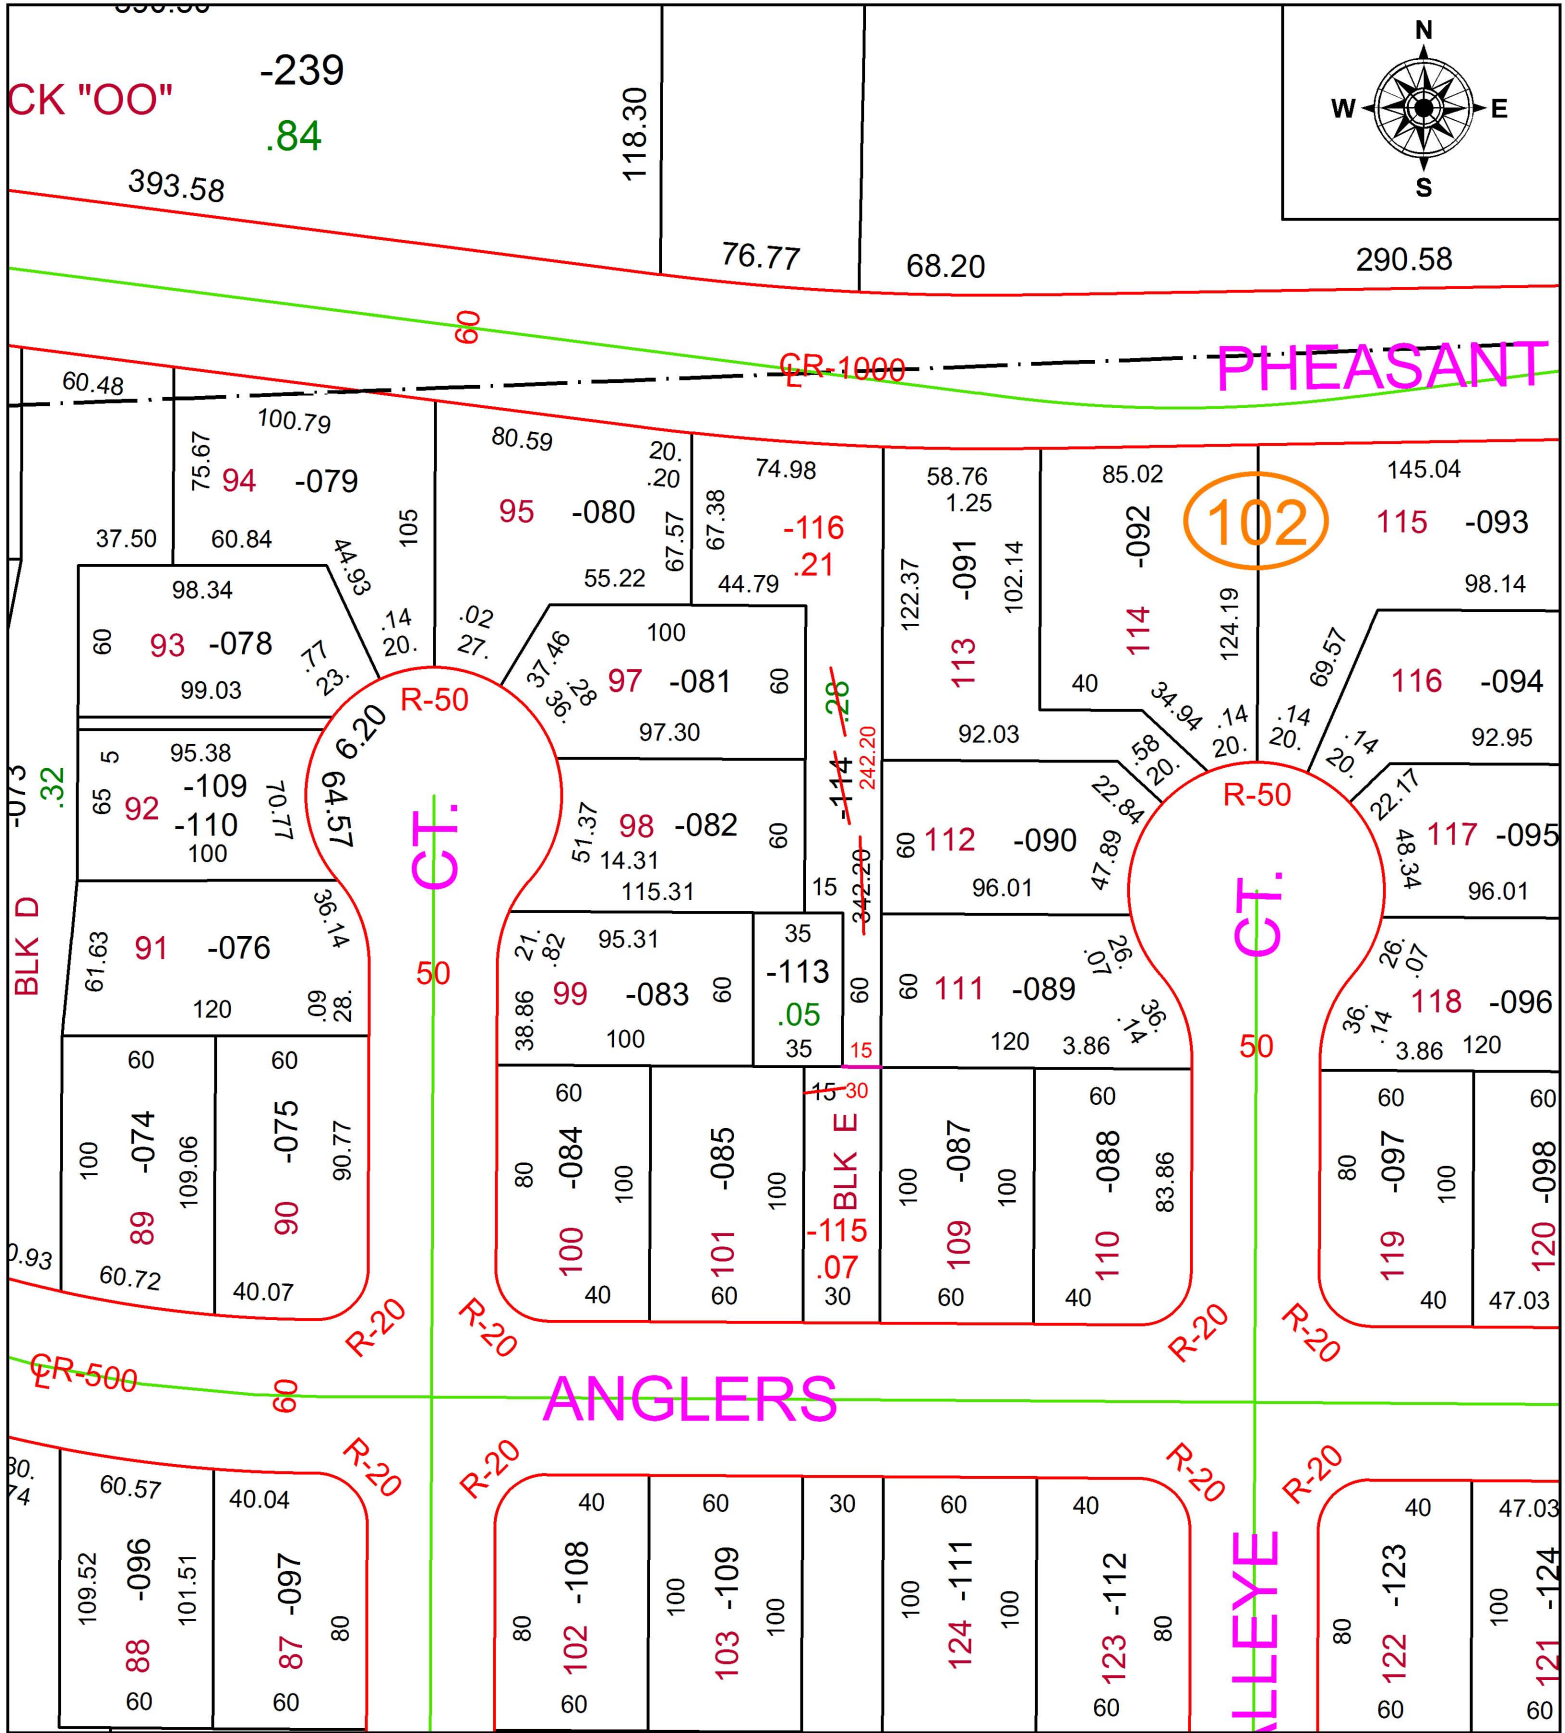

**SPLITS/DEEDS PROCESSED**  
 LORAIN COUNTY TAX MAP DEPARTMENT  
 226 MIDDLE AVE. ELYRIA, OH

SURVEYED BY: THOMAS A. SIMON  
 CLOSURE: 1:91,115  
 MAP PAGE(S): 15-00-099  
 APPROVED BY: RRM DATE: 10-21-19  
 SCALE: 1" = 75' PRIOR INSTRUMENT: 2016092224