


PARENT PARCEL: 15-00-098-108-208, -209, -290

CHILD PARCEL: 15-00-098-108-208, -209, -297 THRU -300

STARTING POINT: NORTHEAST CORNER OF S/L 505 IN PHEASANT RUN VILLAGE PH.1

19-04034

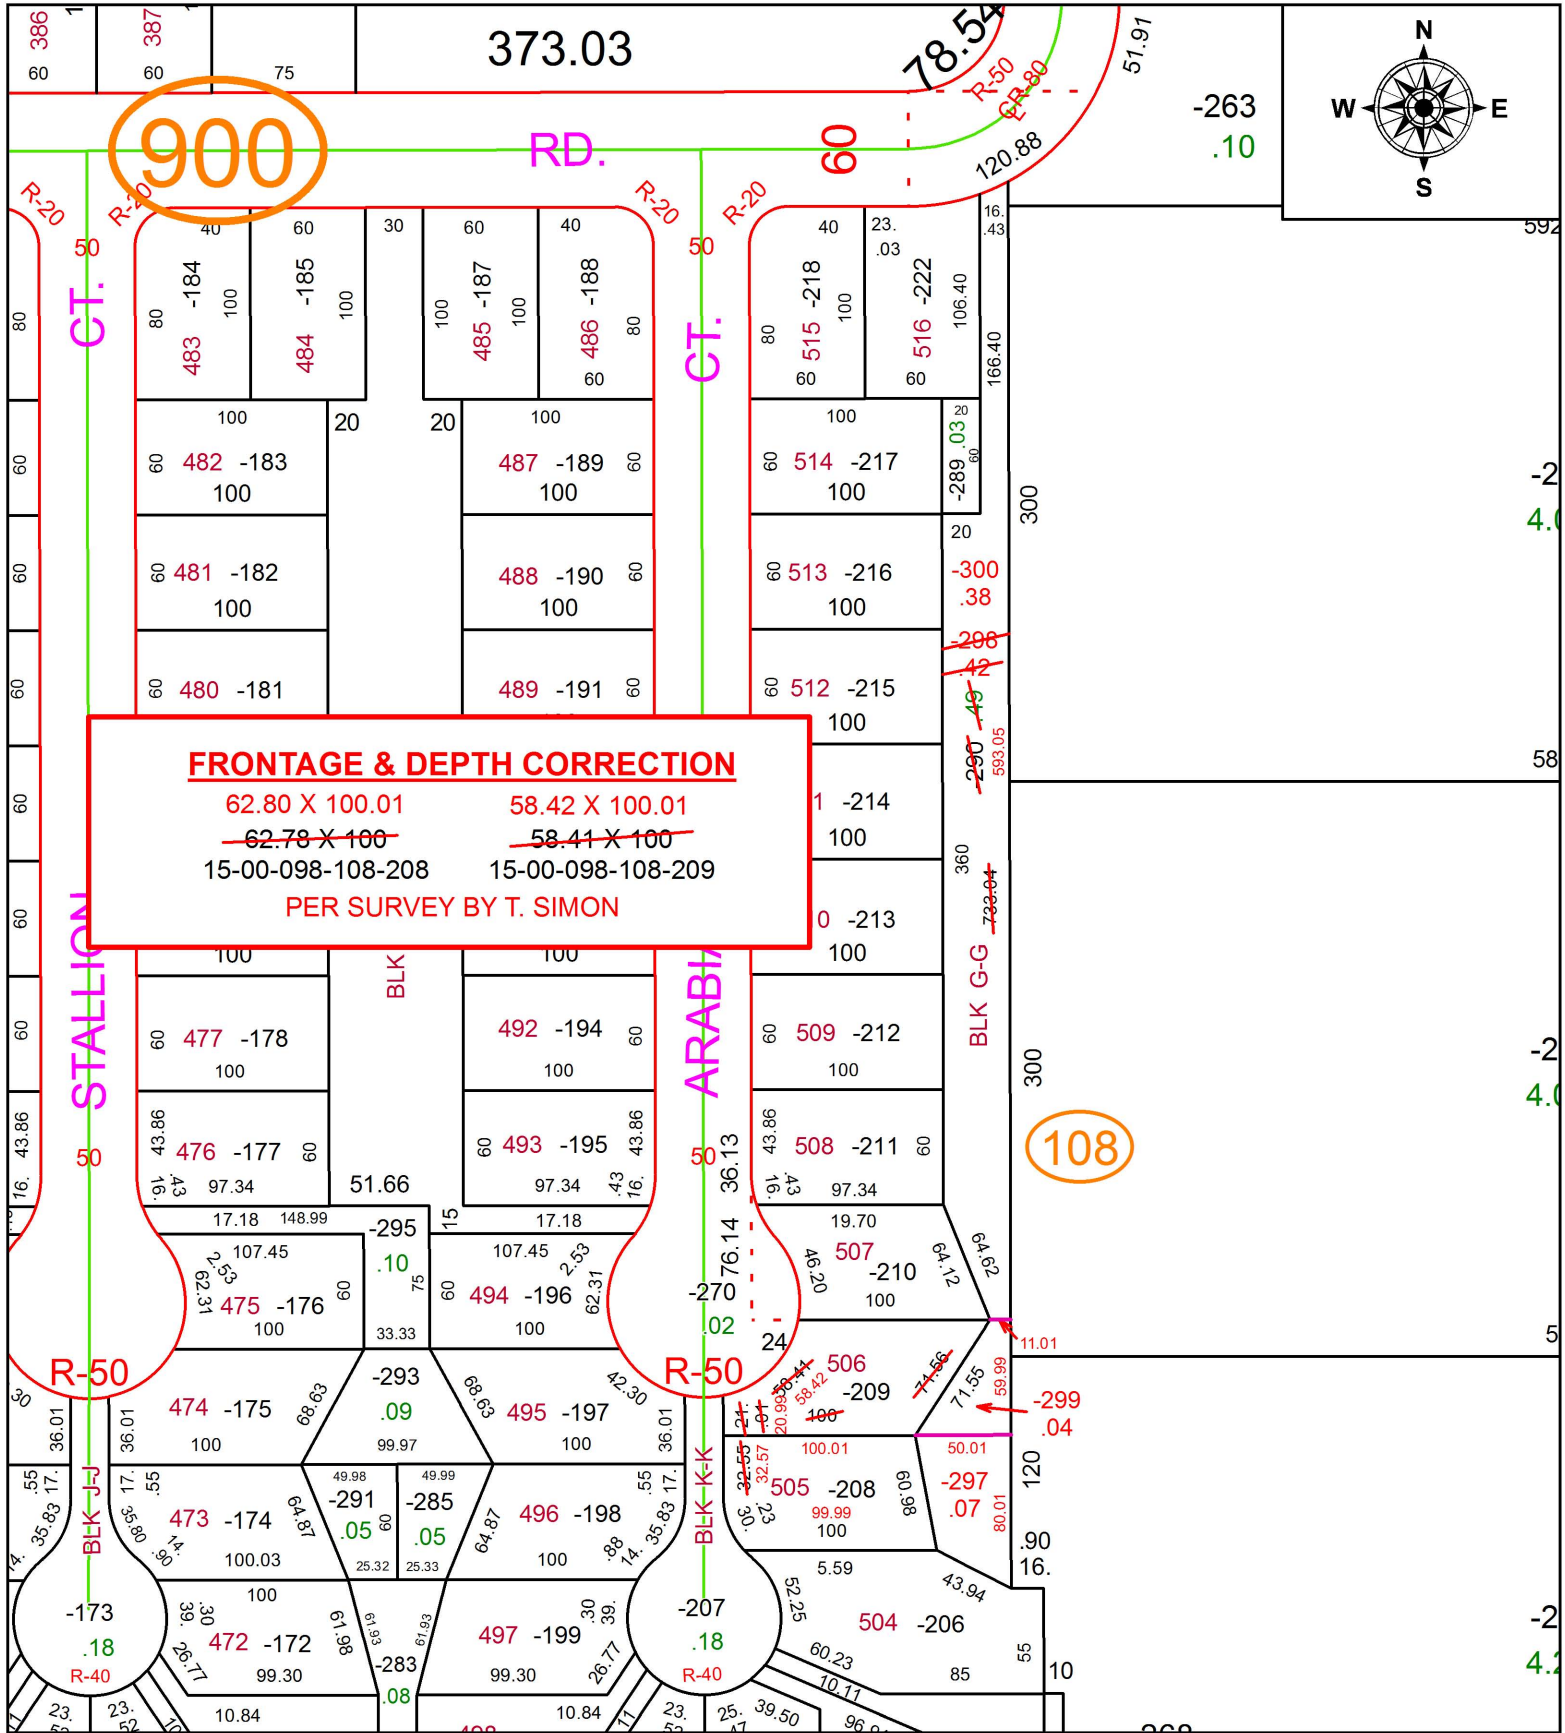

FRONTAGE & DEPTH CORRECTION

62.80 X 100.01	58.42 X 100.01
62.78 X 100	58.41 X 100
15-00-098-108-208	15-00-098-108-209
PER SURVEY BY T. SIMON	

SPLITS/DEEDS PROCESSED

LORAIN COUNTY TAX MAP DEPARTMENT
226 MIDDLE AVE. ELYRIA, OH

SURVEYED BY: THOMAS A. SIMON

CLOSURE: 1:59,836

MAP PAGE(S): 15-00-098

APPROVED BY: RRM DATE: 10-24-19

SCALE: 1" = 100 PRIOR INSTRUMENT: 20160588405