
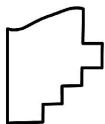


PARENT PARCEL: 01-00-037-102-009, -010
 CHILD PARCEL: 01-00-037-102-053
 STARTING POINT: INTERSECTION OF C/L OF COOPER FOSTER PARK RD. AND C/L OF CLAUS RD.

19-04039

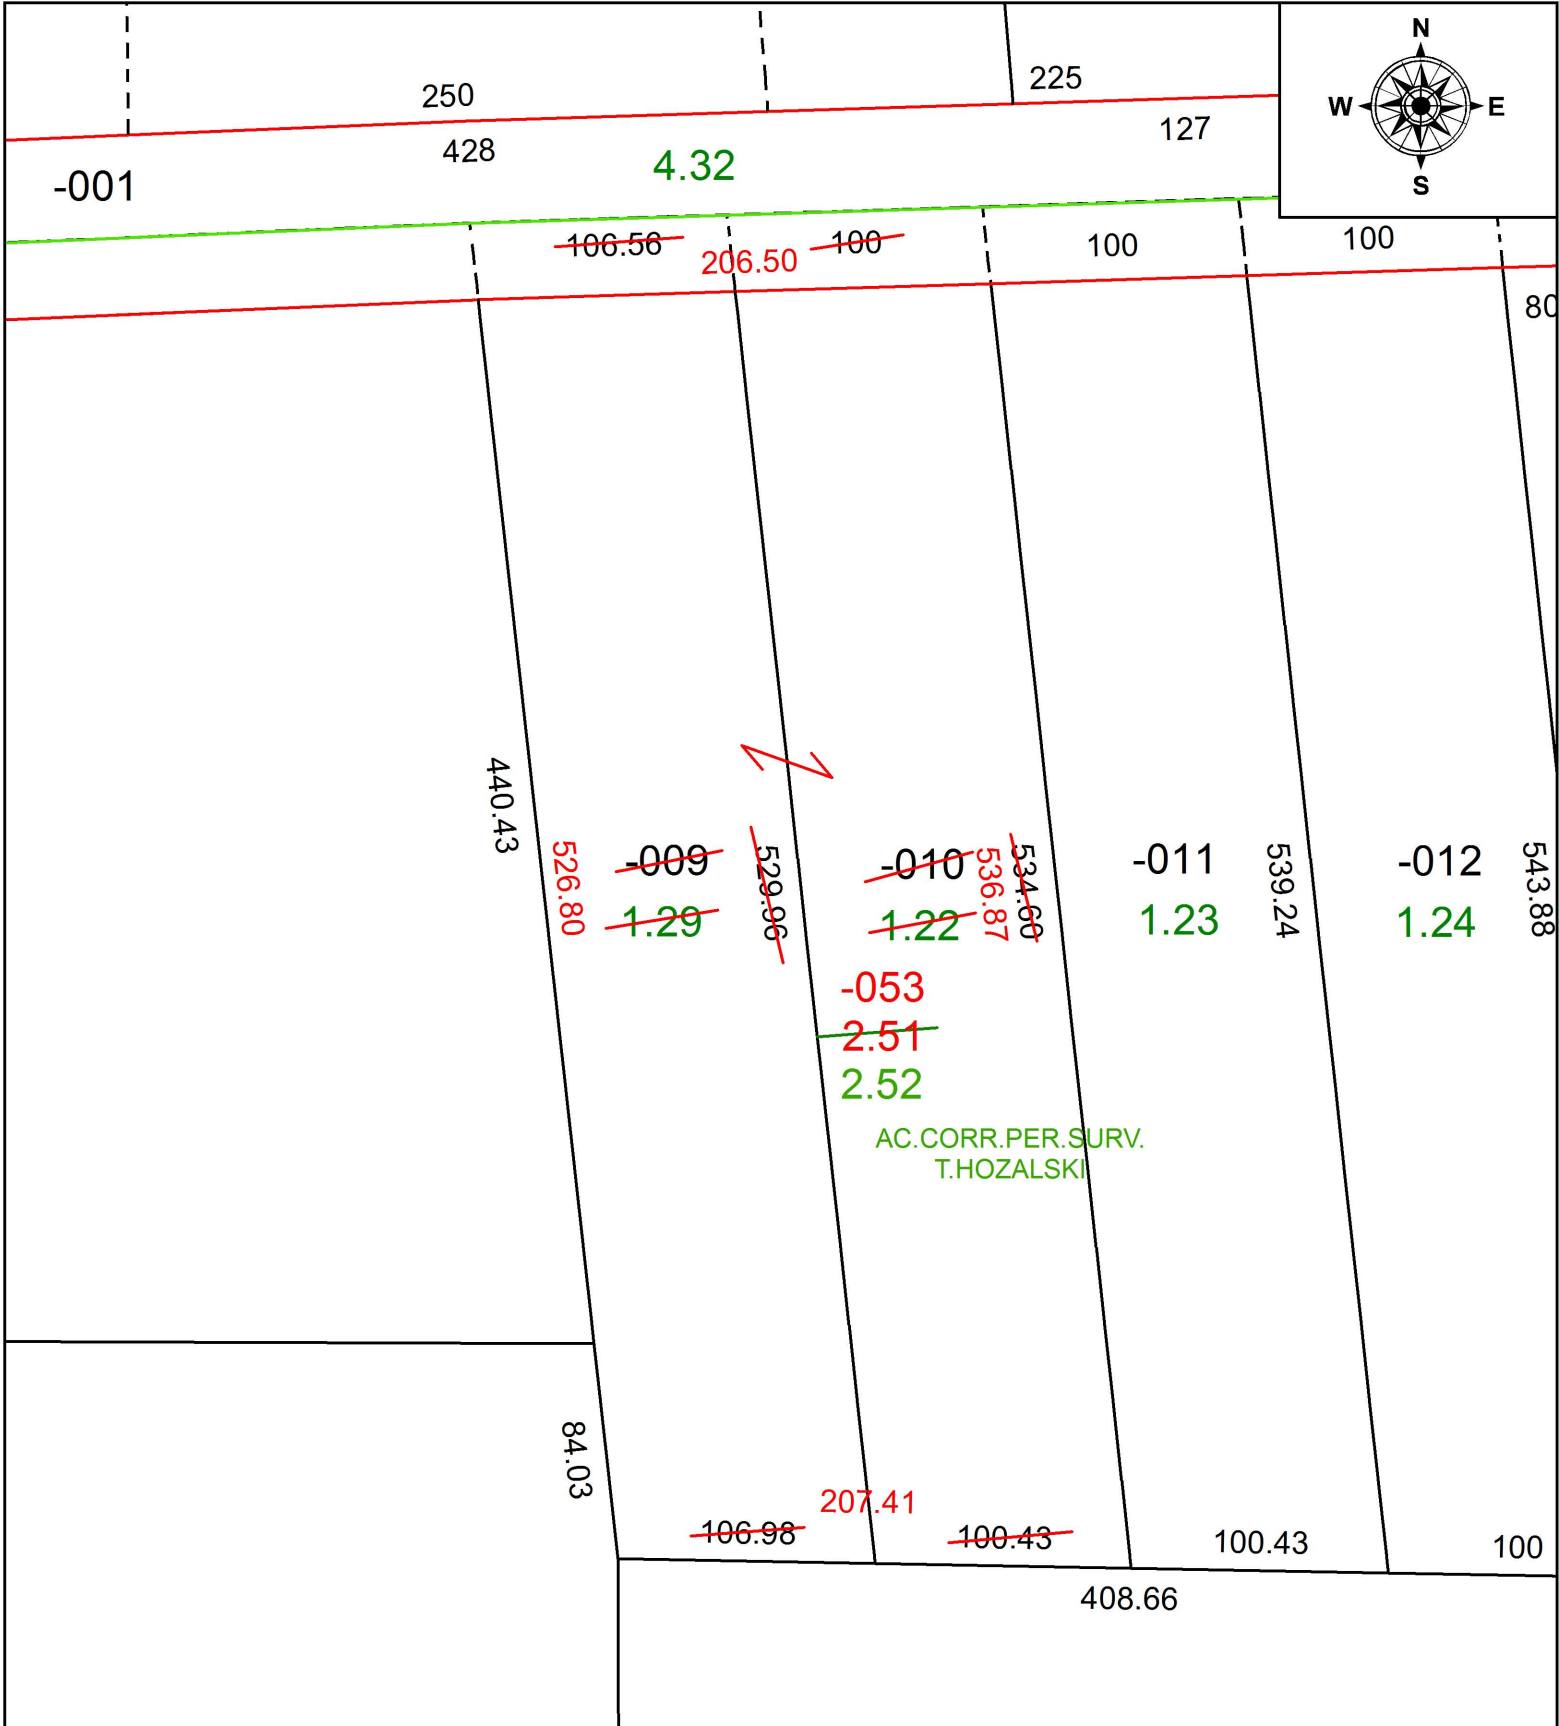

SPLITS/DEEDS PROCESSED
 LORAIN COUNTY TAX MAP DEPARTMENT
 226 MIDDLE AVE. ELYRIA, OH

SURVEYED BY: TIMOTHY D. HOZALSKI
 CLOSURE: 1:384,469
 MAP PAGE(S): 1-00-037
 APPROVED BY: RRM DATE: 10-31-19
 SCALE: 1" = 75' PRIOR INSTRUMENT: 20190726111