
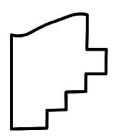
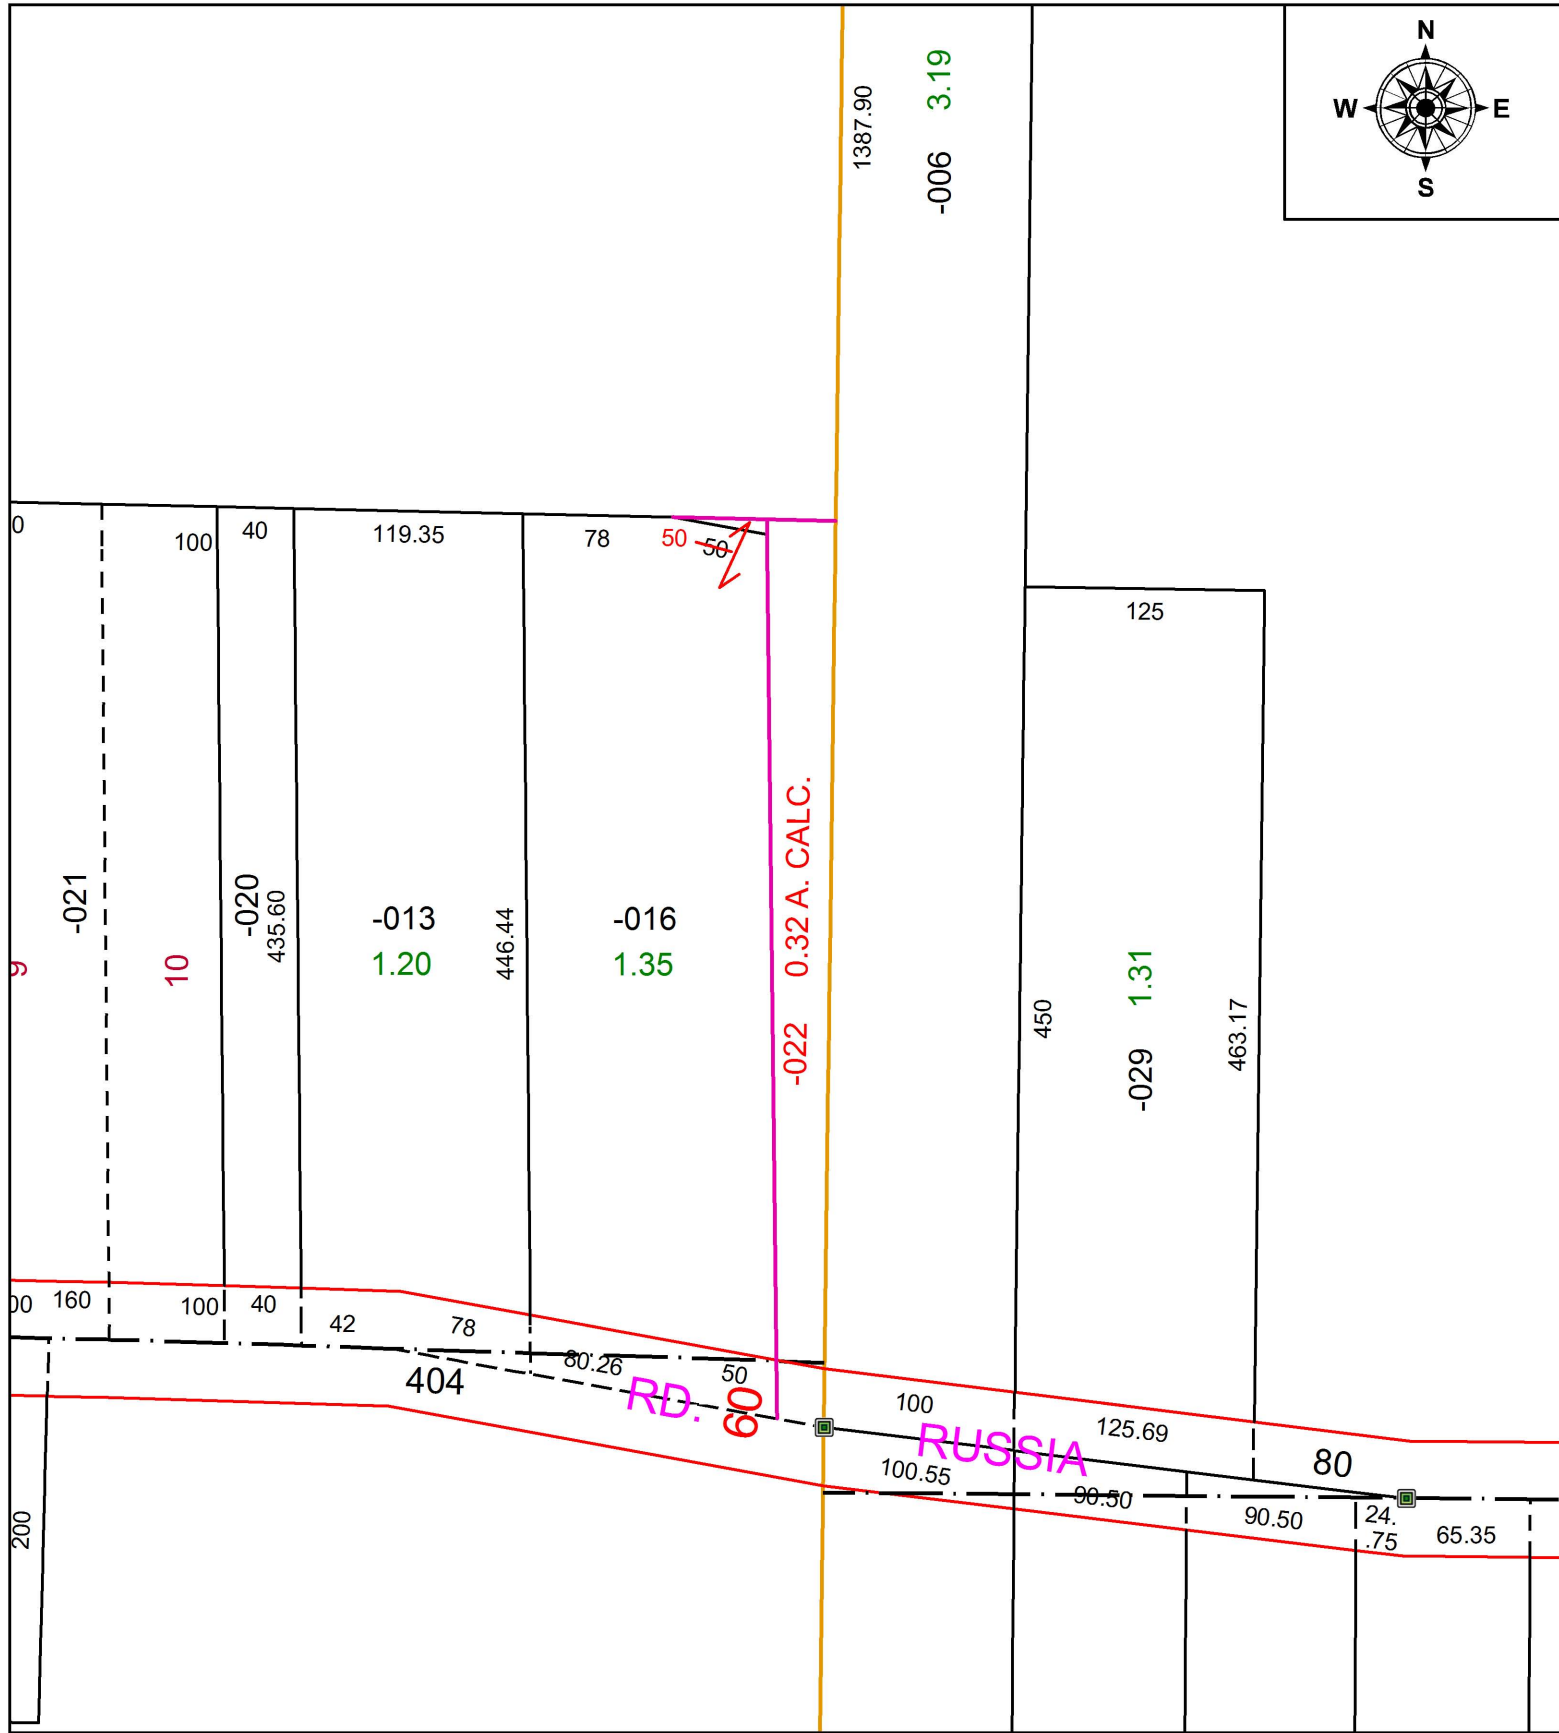


PARENT PARCEL: ADD TO DUP. & MAP CORR. PER DV 465 PG. 512 & DV 874 PG. 161

CHILD PARCEL: 08-00-089-000-022 SURVEY BEFORE NEXT TRANSFER

STARTING POINT: NA

19-04041-C

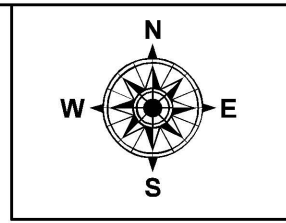

SPLITS/DEEDS PROCESSED
LORAIN COUNTY TAX MAP DEPARTMENT
226 MIDDLE AVE. ELYRIA, OH

SURVEYED BY: NA
CLOSURE: NA
MAP PAGE(S): 08-00-089
APPROVED BY: TJS DATE: 2/1/19
SCALE: 1" = 200 PRIOR INSTRUMENT: SEE ABOVE