
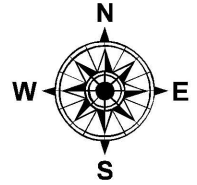


PARENT PARCEL: 10-00-010-000-092, -101, -102


CHILD PARCEL: 10-00-010-000-103, -104

STARTING POINT: INTERSECTION OF WEST LINE OF SEC. 11 AND C/L OF BUTTERNUT RIDGE RD.

19-04041

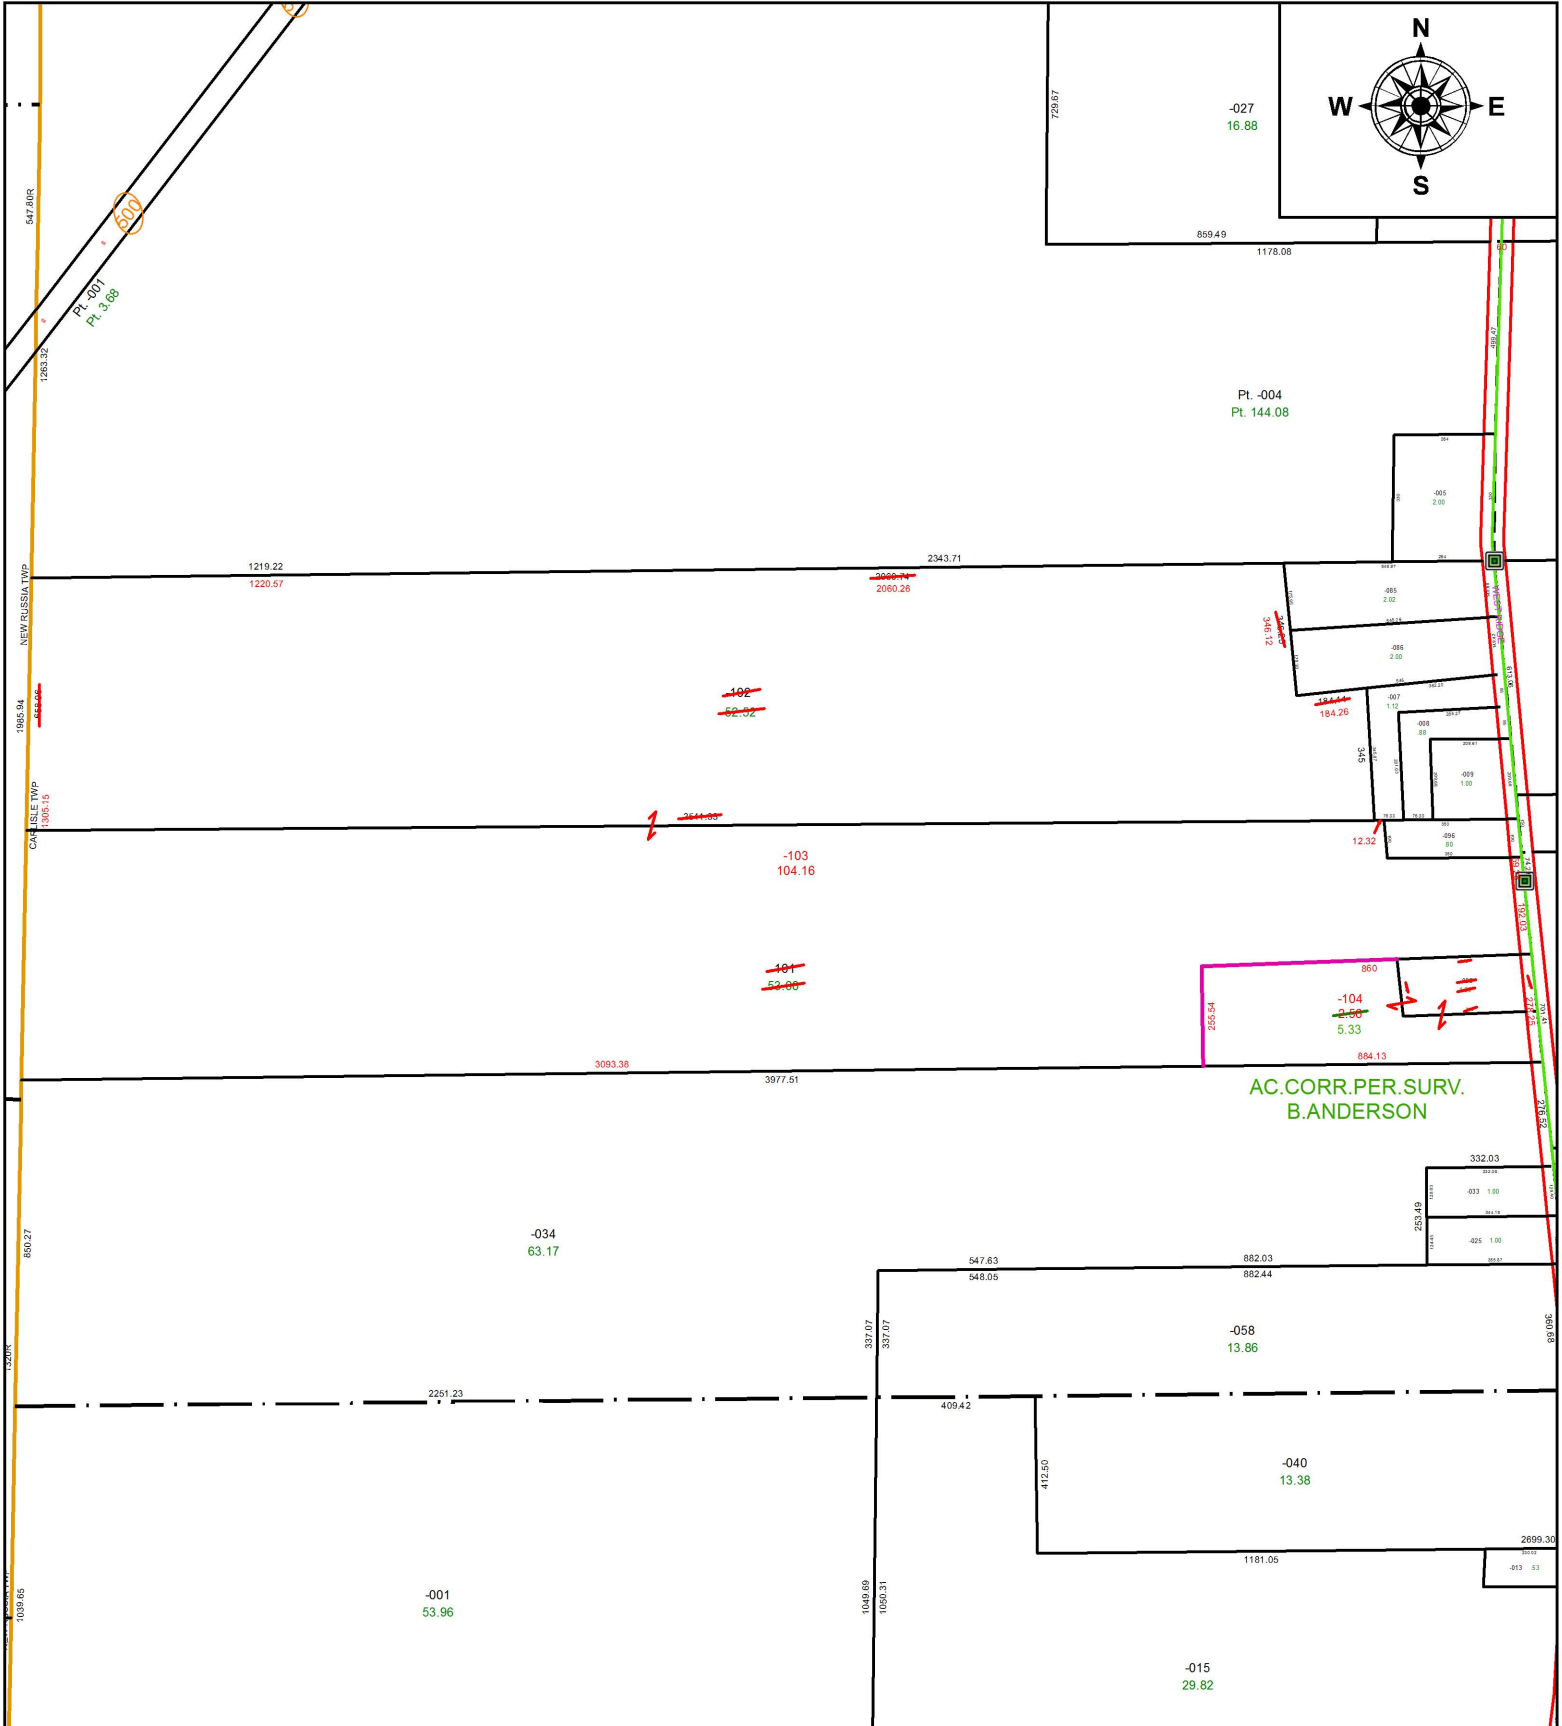

AC. CORR. PER. SURV.
B. ANDERSON

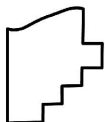

SPLITS/DEEDS PROCESSED
LORAIN COUNTY TAX MAP DEPARTMENT
226 MIDDLE AVE. ELYRIA, OH

SURVEYED BY: BRENT D. ANDERSON
 CLOSURE: 1:716,448
 MAP PAGE(S): 10-00-010
 APPROVED BY: RRM DATE: 11-5-19
 SCALE: 1" = 500 PRIOR INSTRUMENT: 20190701998