
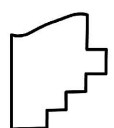
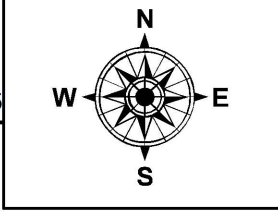


PARENT PARCEL: 05-00-097-102-025, -040

CHILD PARCEL: 05-00-097-102-042 THRU -044

STARTING POINT: INTERSECTION OF C/L OF NORTH RIDGE RD, AND C/L OF CROSSE RD.

19-04043

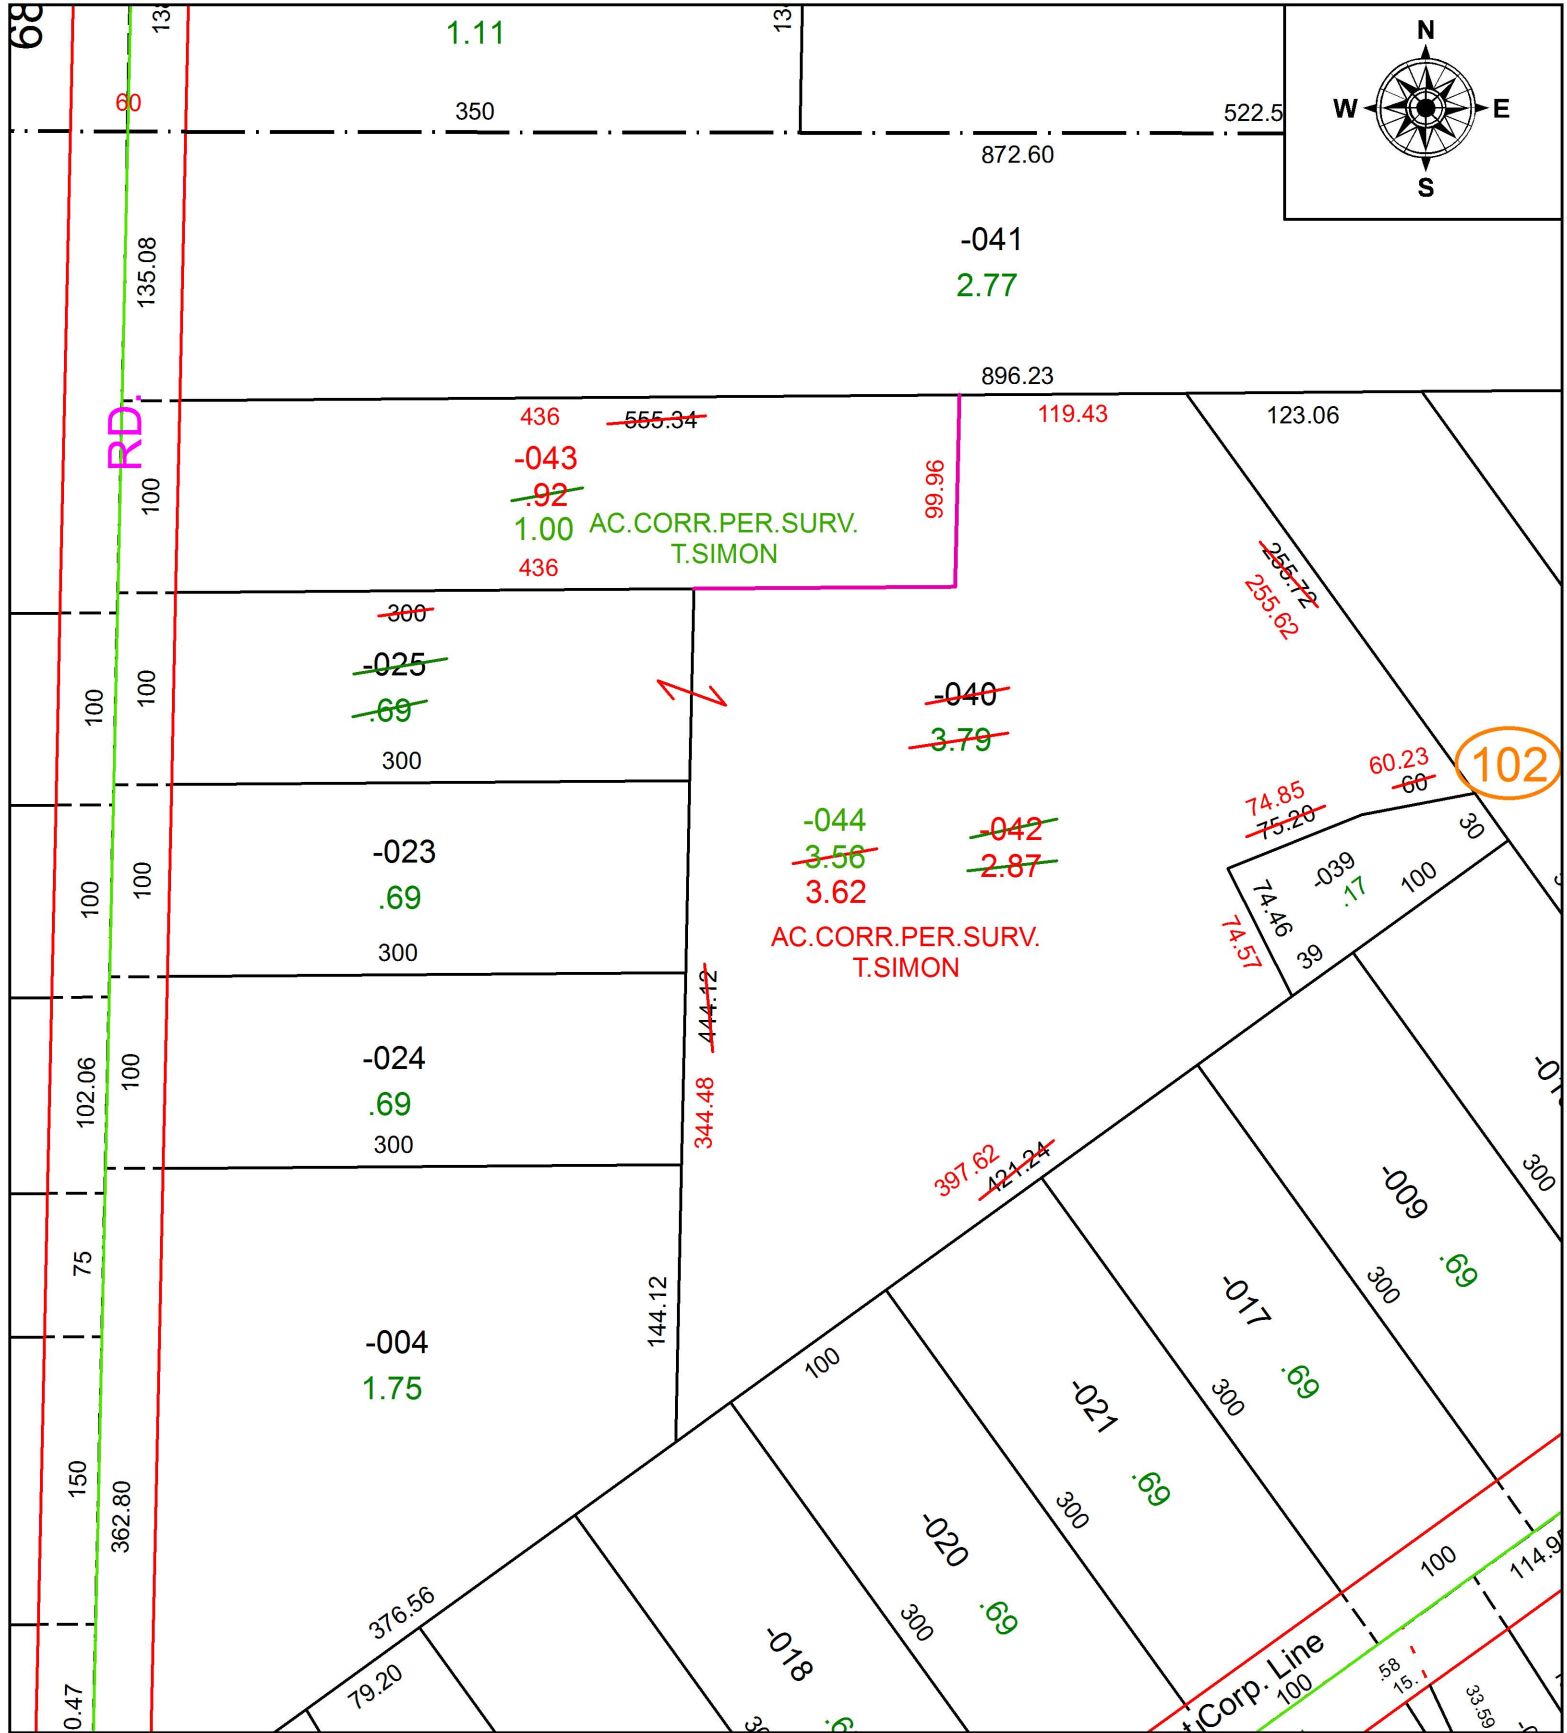

SPLITS/DEEDS PROCESSED
 LORAIN COUNTY TAX MAP DEPARTMENT
 226 MIDDLE AVE. ELYRIA, OH

SURVEYED BY: THOMAS A. SIMON
 CLOSURE: 1:106,533
 MAP PAGE(S): 5-00-097
 APPROVED BY: RRM DATE: 11-8-19
 SCALE: 1" = 100 PRIOR INSTRUMENT: OR 31/781