


PARENT PARCEL: 16-00-029-000-015, -017, -018, -019, -021, -025 -027 THRU -030
CHILD PARCEL:
STARTING POINT:


19-04044-C

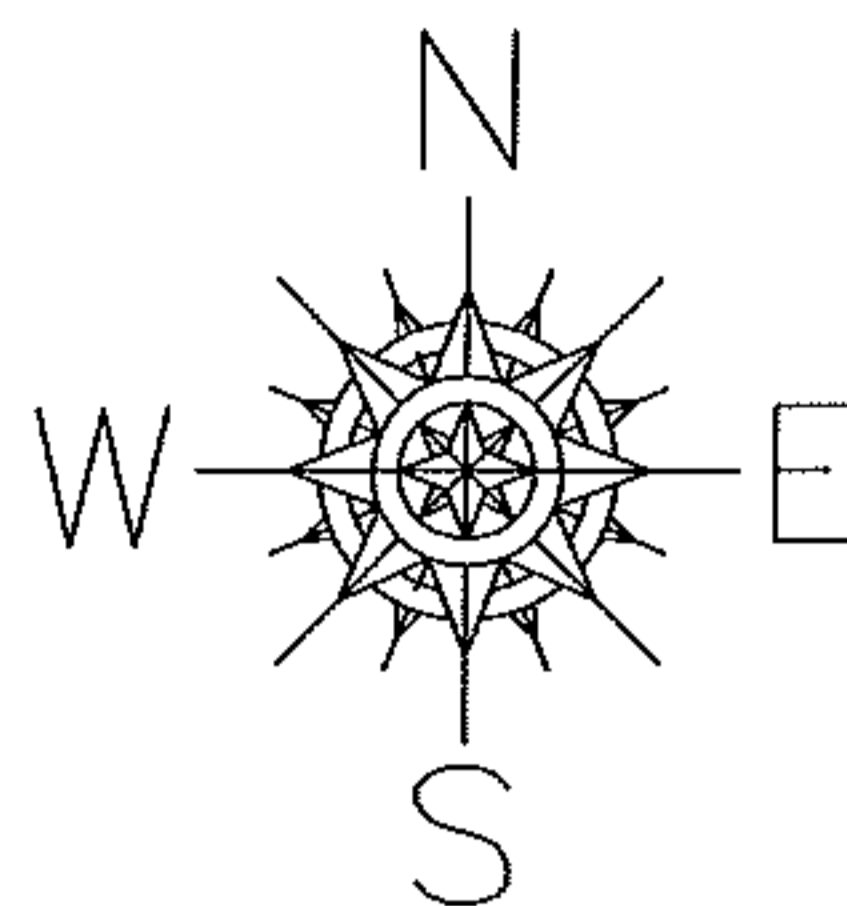

MAP CORRECTION

PARCELS READ TO SIDELINE NOT C/L

- 16-00-029-000-015
- 16-00-029-000-017
- 16-00-029-000-018
- 16-00-029-000-019
- 16-00-029-000-021
- 16-00-029-000-025
- 16-00-029-000-027
- 16-00-029-000-028
- 16-00-029-000-029
- 16-00-029-000-030

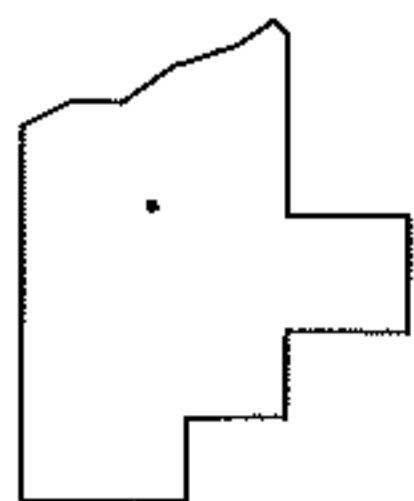

SPLITS/DEEDS PROCESSED
LORAIN COUNTY TAX MAP DEPARTMENT
226 MIDDLE AVE. ELYRIA, OHIO

SURVEYED BY: N/A
CLOSURE: N/A
MAP PAGE(S): 16-00-029
APPROVED BY: RRM DATE: 2-5-19
SCALE: N/A PRIOR INSTRUMENT: