
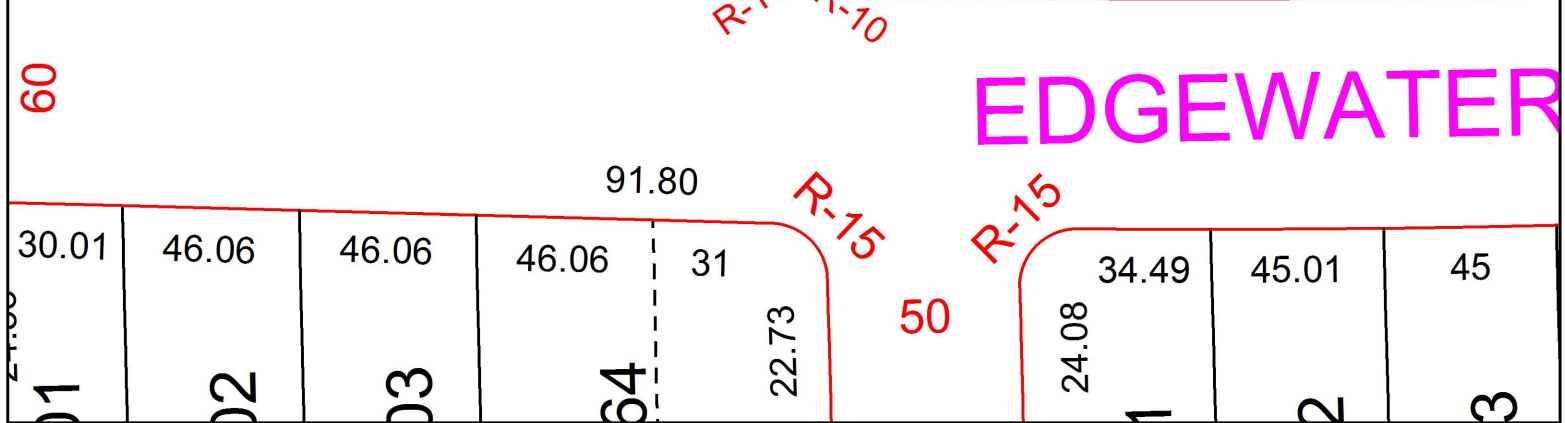


PARENT PARCEL: 01-00-001-102-013

CHILD PARCEL: MAP & LINE CORR. PER DV 286/123, DV 764/72, DV 764/132, DV 759/1

STARTING POINT: HURON LANE

19-04049-C

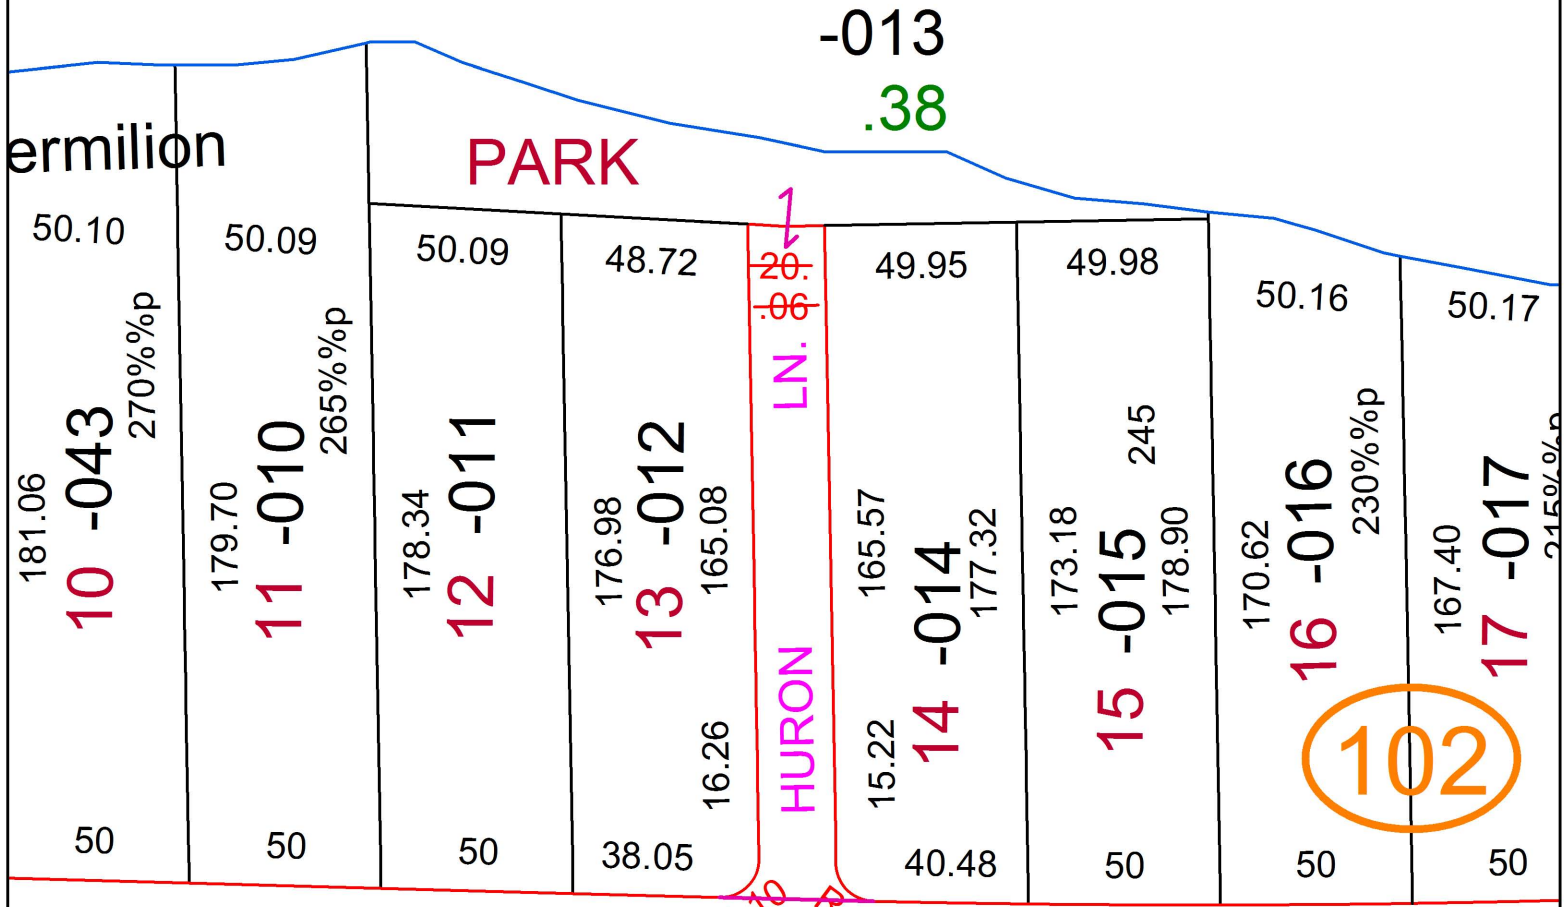

SPLITS/DEEDS PROCESSED
 LORAIN COUNTY TAX MAP DEPARTMENT
 226 MIDDLE AVE. ELYRIA, OH

SURVEYED BY: PLAT VOL. 10 PG. 13
 CLOSURE: NA
 MAP PAGE(S): 01-00-001
 APPROVED BY: TJS DATE: 2/19/19
 SCALE: 1" = 50' PRIOR INSTRUMENT: DV XXXX/XXXX