


PARENT PARCEL: 05-00-060-105-012, -013, -014

CHILD PARCEL: 05-00-060-105-050, -051

STARTING POINT: INTERSECTION OF C/L OF NORTH RIDGE RD. AND C/L OF OBERLIN RD.

19-04052

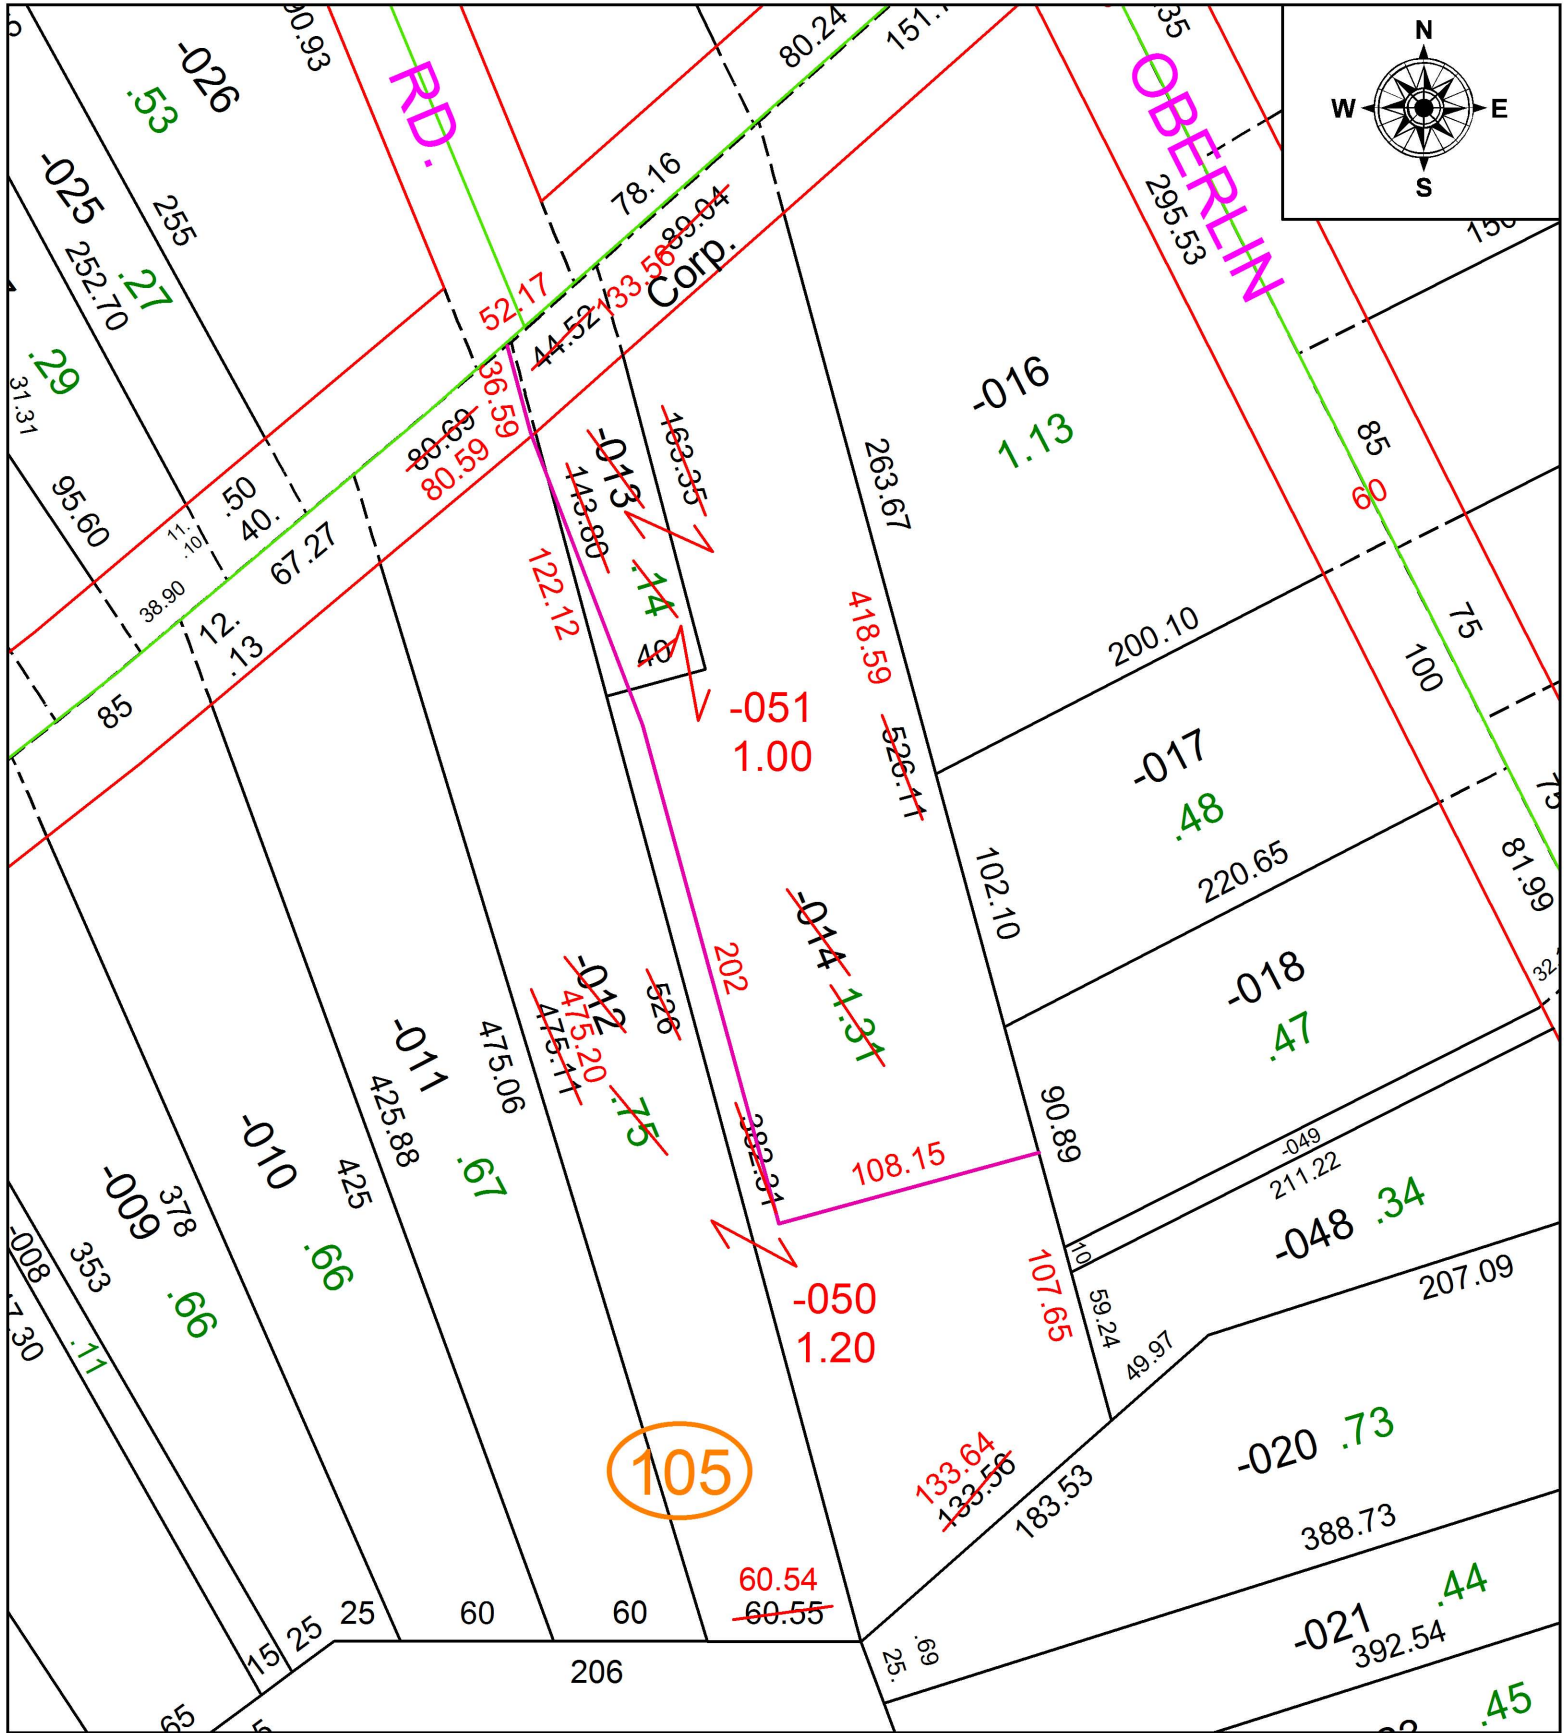

**SPLITS/DEEDS PROCESSED**  
 LORAIN COUNTY TAX MAP DEPARTMENT  
 226 MIDDLE AVE. ELYRIA, OH

SURVEYED BY: PATRICK A. MCGANNON  
 CLOSURE: 1:178,605  
 MAP PAGE(S): 5-00-060  
 APPROVED BY: RRM DATE: 11-20-19  
 SCALE: 1" = 75' PRIOR INSTRUMENT: 20180667246