


PARENT PARCEL: 05-00-024-112-008, -009

CHILD PARCEL:

STARTING POINT: INTERSECTION OF NORTH LINE OF FRANKLIN AVE. AND EAST LINE OF CHURCH ST,

19-04060-C

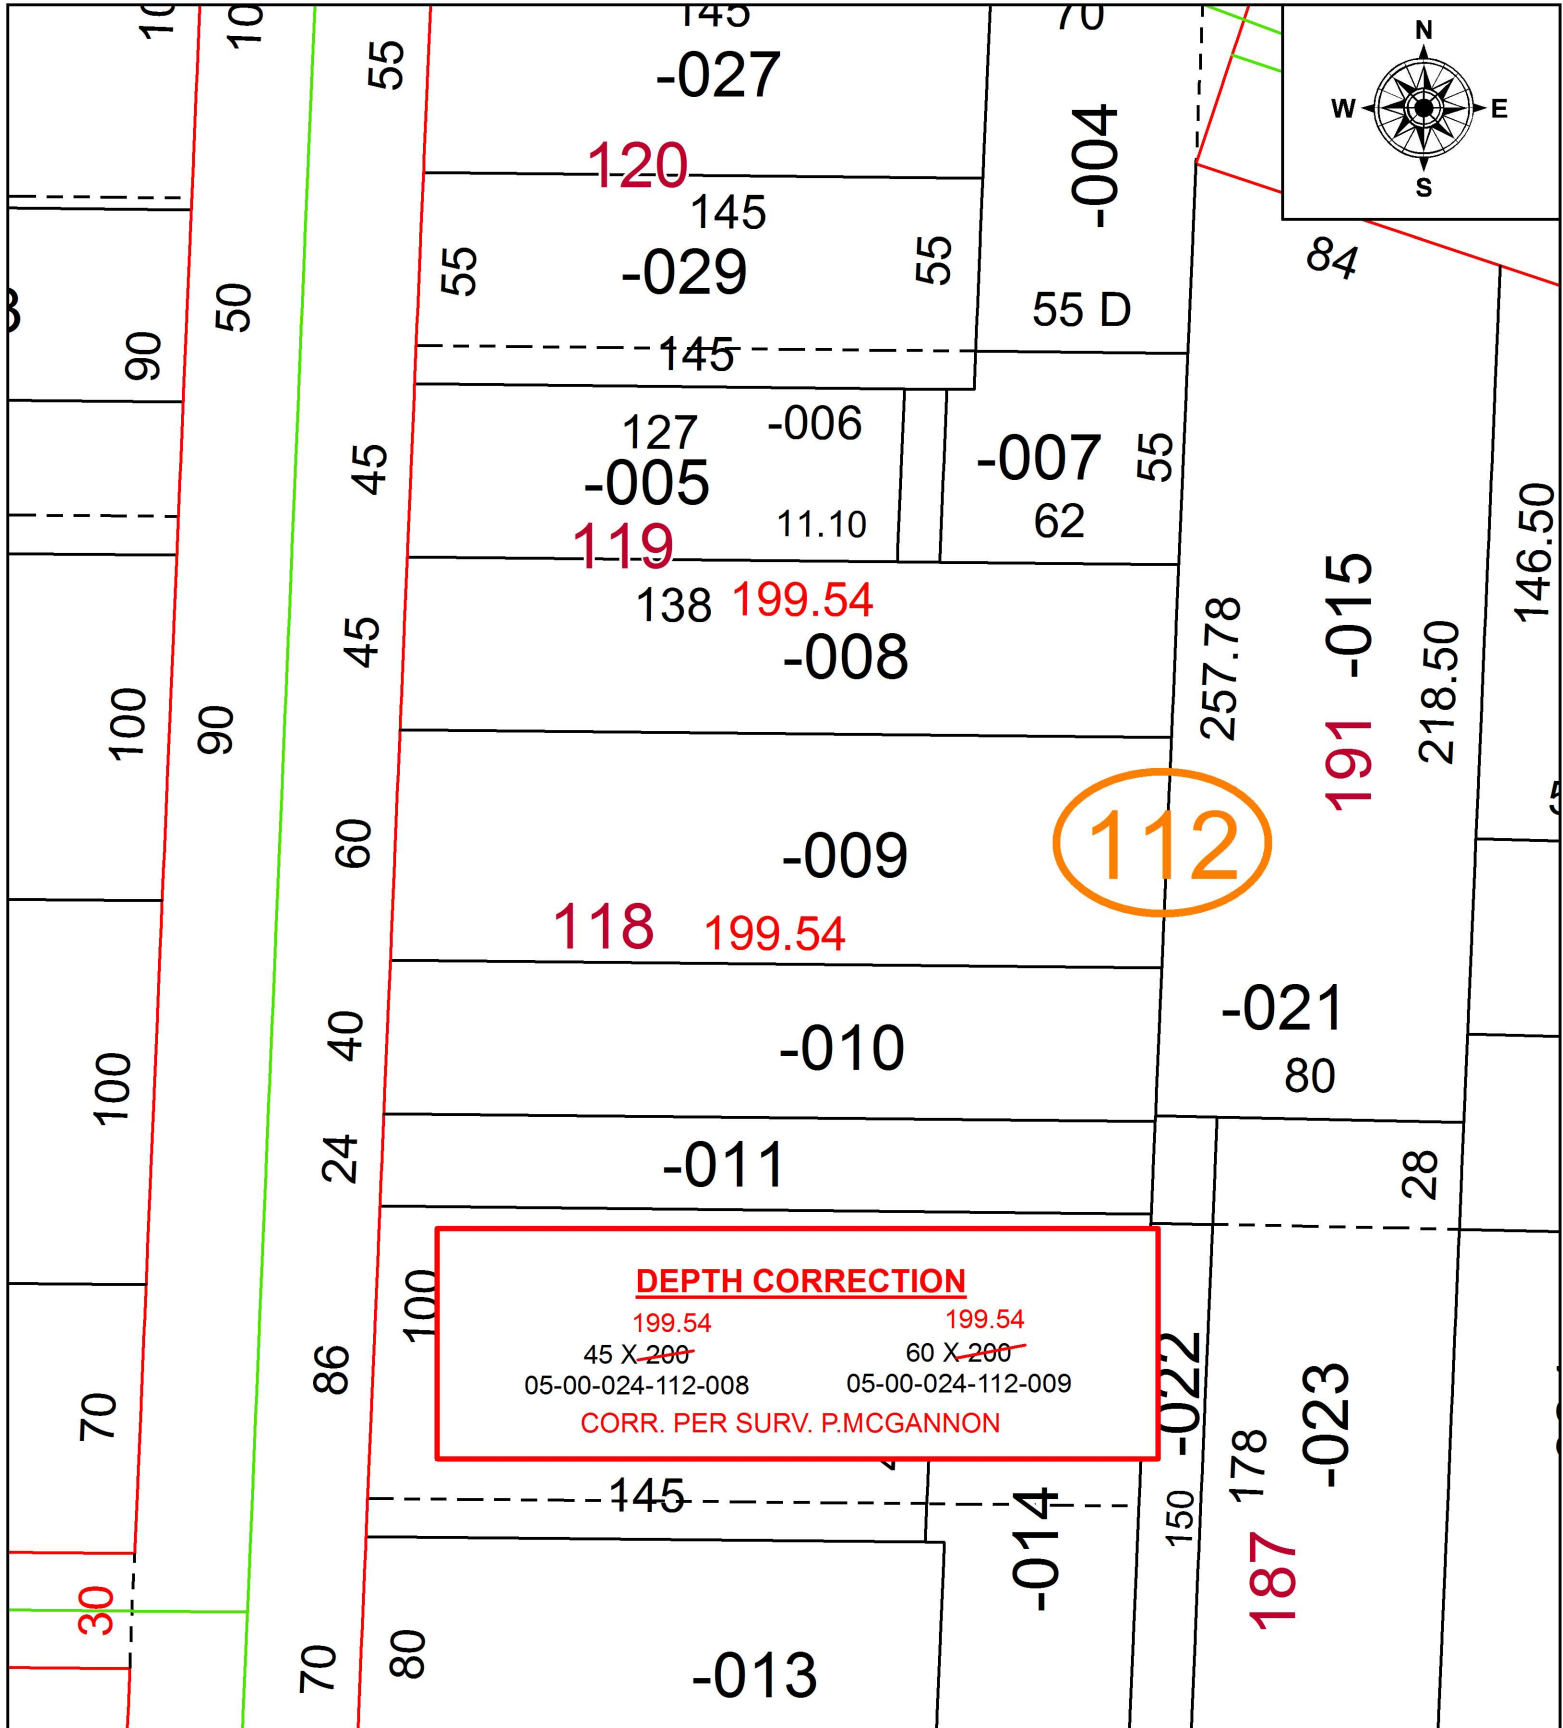

**DEPTH CORRECTION**  
 199.54                      199.54  
 45 X ~~200~~                      60 X ~~200~~  
 05-00-024-112-008              05-00-024-112-009  
 CORR. PER SURV. P.MCGANNON



**SPLITS/DEEDS PROCESSED**  
 LORAIN COUNTY TAX MAP DEPARTMENT  
 226 MIDDLE AVE. ELYRIA, OH

SURVEYED BY: PATRICK A. MCGANNON  
 CLOSURE: 1: 2147483648  
 MAP PAGE(S): 5-00-024  
 APPROVED BY: RRM DATE: 3-18-19  
 SCALE: 1" = 50 PRIOR INSTRUMENT: 20170630792