


PARENT PARCEL: 02-03-001-106-004, -005

CHILD PARCEL: 02-03-001-106-004, -017, -018

STARTING POINT: NORTHEAST CORNER OF S/L 10 IN KOLBE ACRES SUB.



19-04065

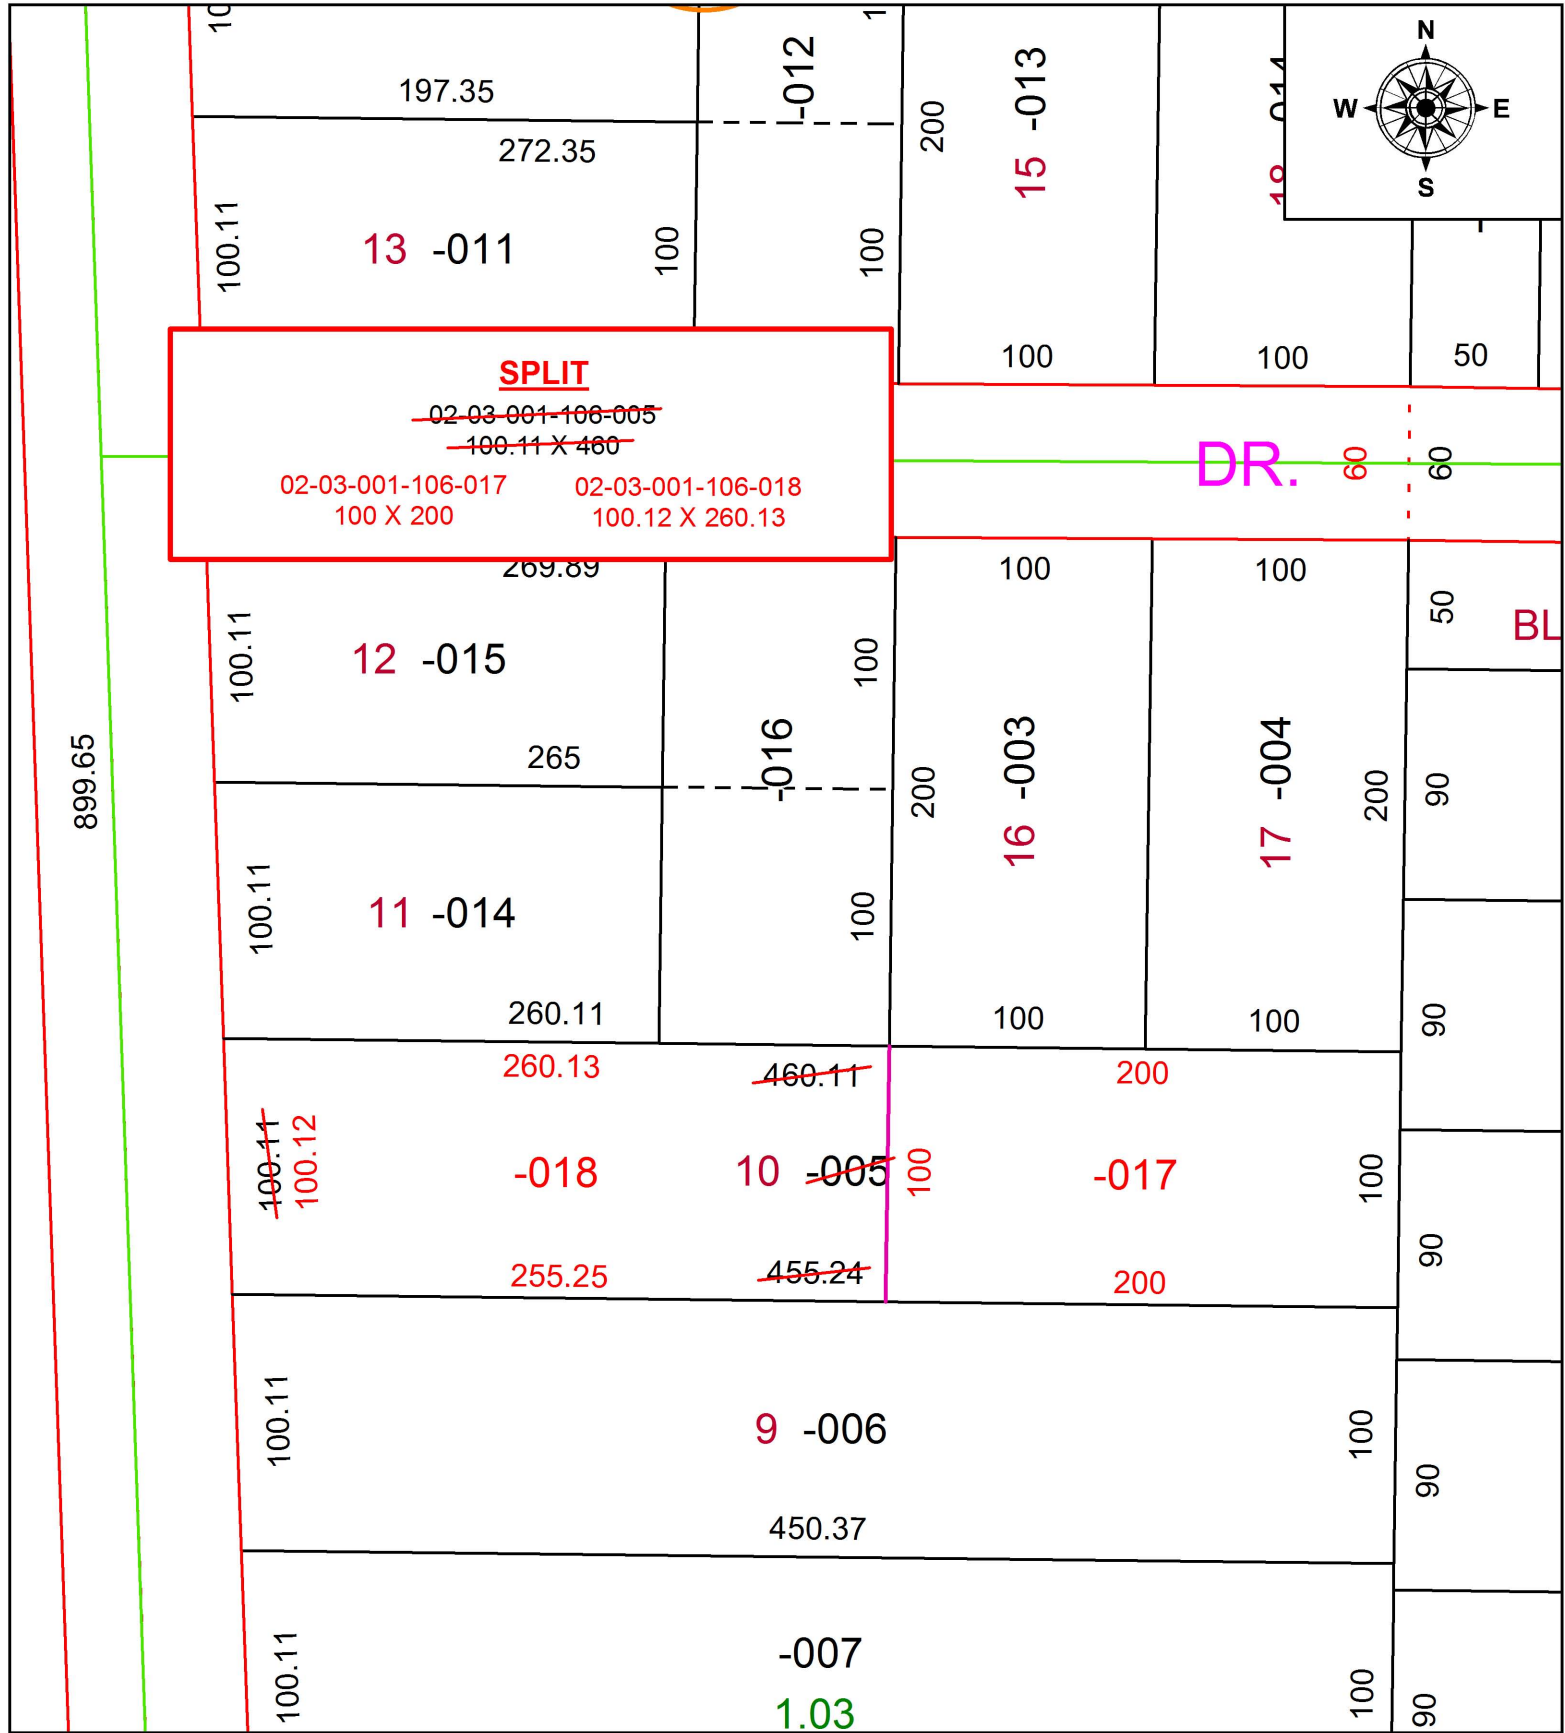

899.65

SPLIT
~~02-03-001-106-005~~
~~100.11 X 460~~
02-03-001-106-017 02-03-001-106-018
100 X 200 100.12 X 260.13

DR.

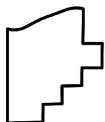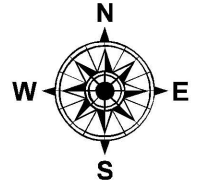

SPLITS/DEEDS PROCESSED
LORAIN COUNTY TAX MAP DEPARTMENT
226 MIDDLE AVE. ELYRIA, OH

SURVEYED BY: PATRICK A. MCGANNON
CLOSURE: 1:57,048
MAP PAGE(S): 2-03-001
APPROVED BY: RRM DATE: 12-12-19
SCALE: 1" = 75' PRIOR INSTRUMENT: 20100334087