


PARENT PARCEL: 05-00-088-000-008, 06-24-017-102-056


CHILD PARCEL: 05-00-087-000-073, 05-00-088-000-027, -028, 06-24-017-102-056

STARTING POINT: SOUTHEAST CORNER OF O.L.88

19-04066-U

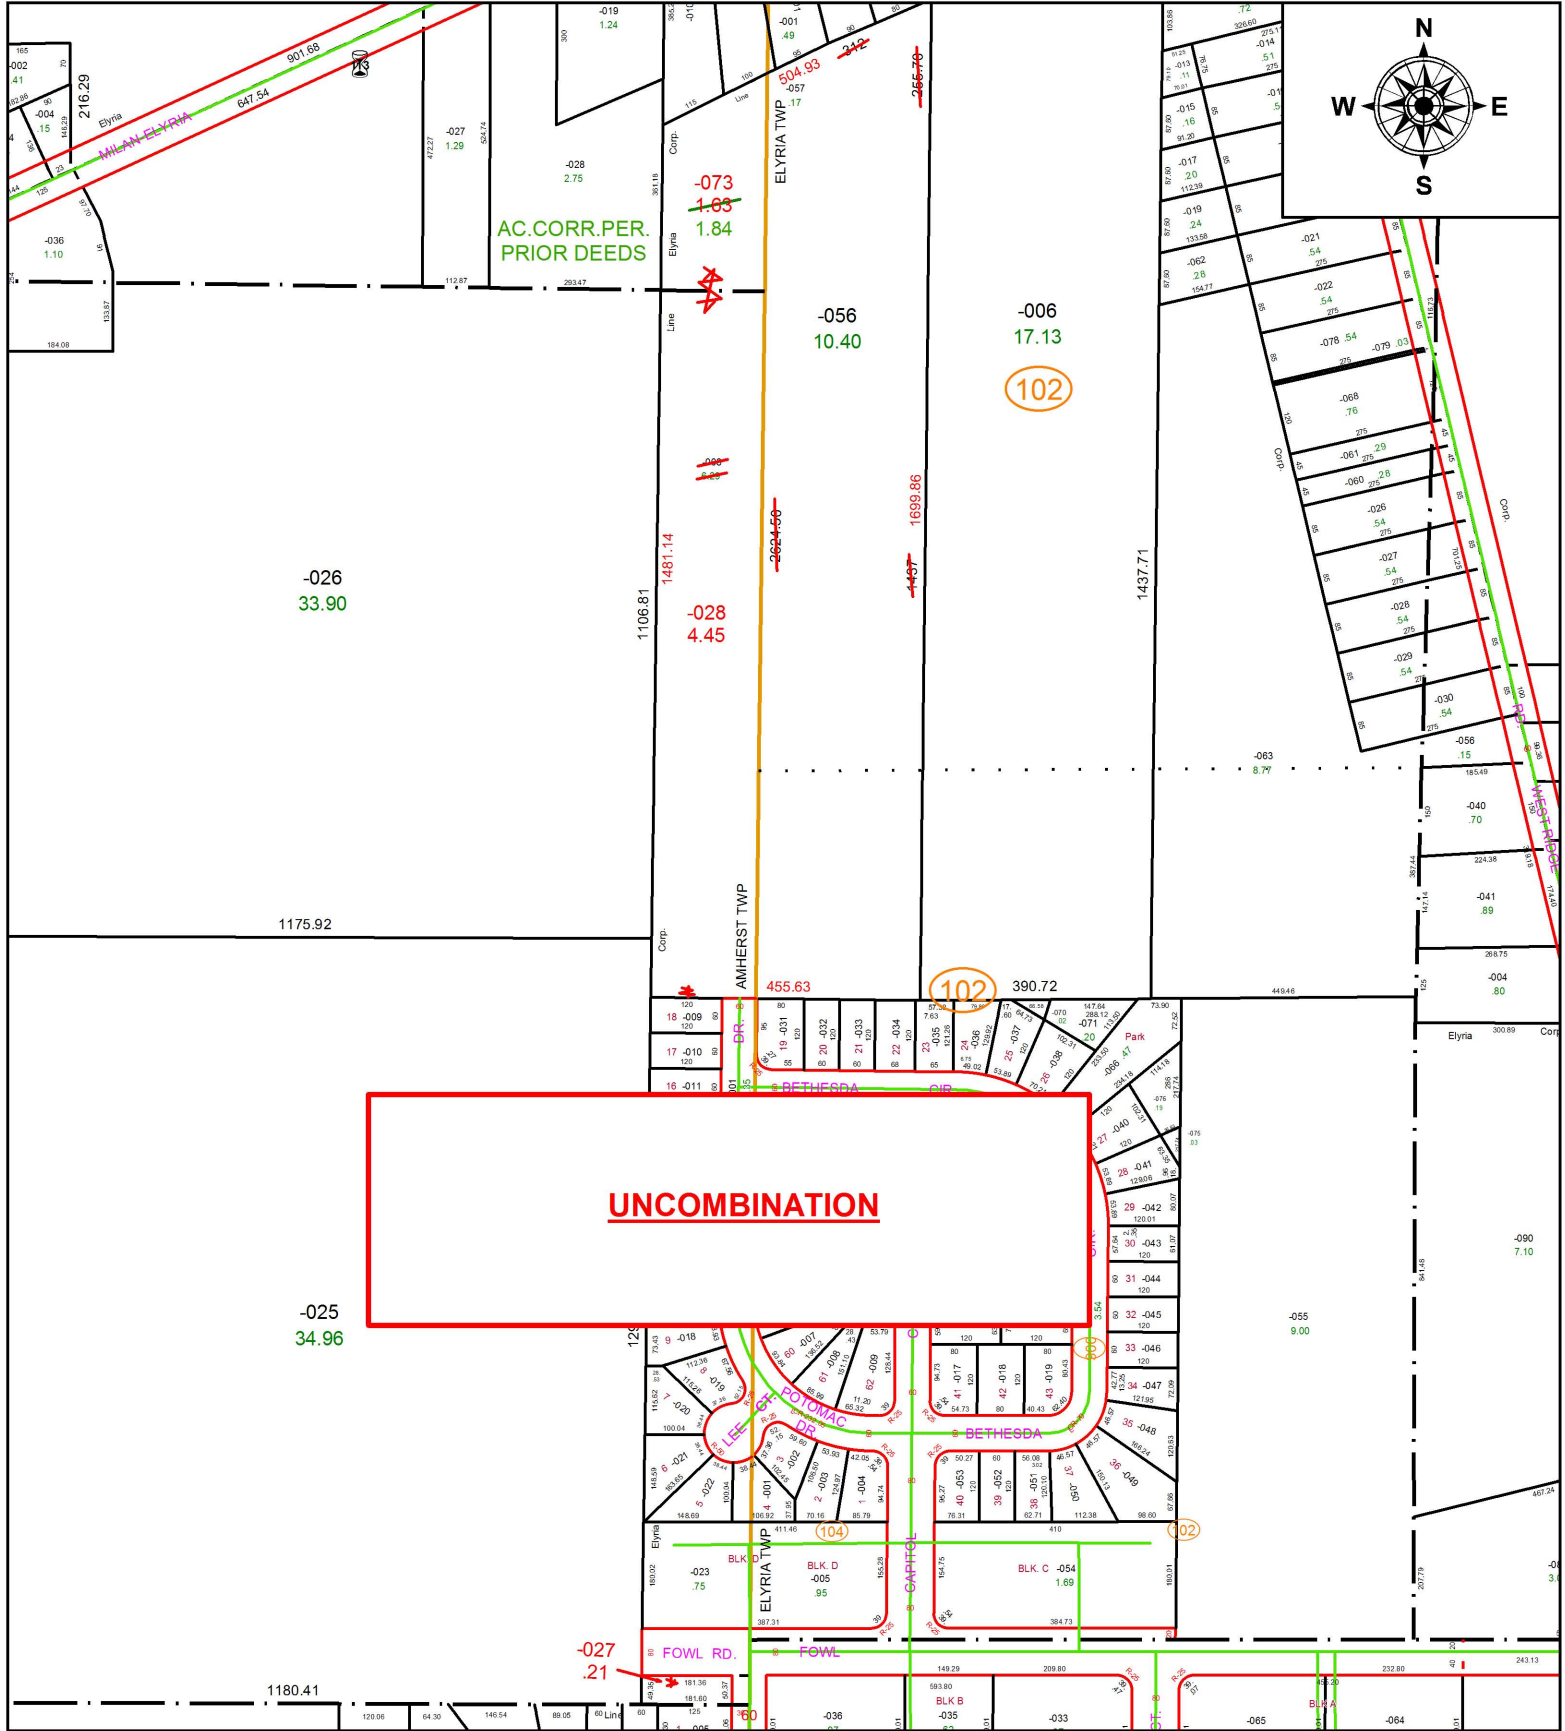

UNCOMBINATION

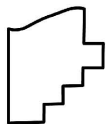

SPLITS/DEEDS PROCESSED
 LORAIN COUNTY TAX MAP DEPARTMENT
 226 MIDDLE AVE. ELYRIA, OH

SURVEYED BY: N/A
 CLOSURE: 1:61,440
 MAP PAGE(S): 5-00-088
 APPROVED BY: RRM DATE: 4-1-19
 SCALE: 1" = 325 PRIOR INSTRUMENT: 20030887997