


PARENT PARCEL: 06-24-025-105-001

CHILD PARCEL:

STARTING POINT: INTERSECTION OF C/L OF OAKWOOD DR. AND WEST LINE OF OAKWOOD PARK SUB. NO.2

19-04067-C

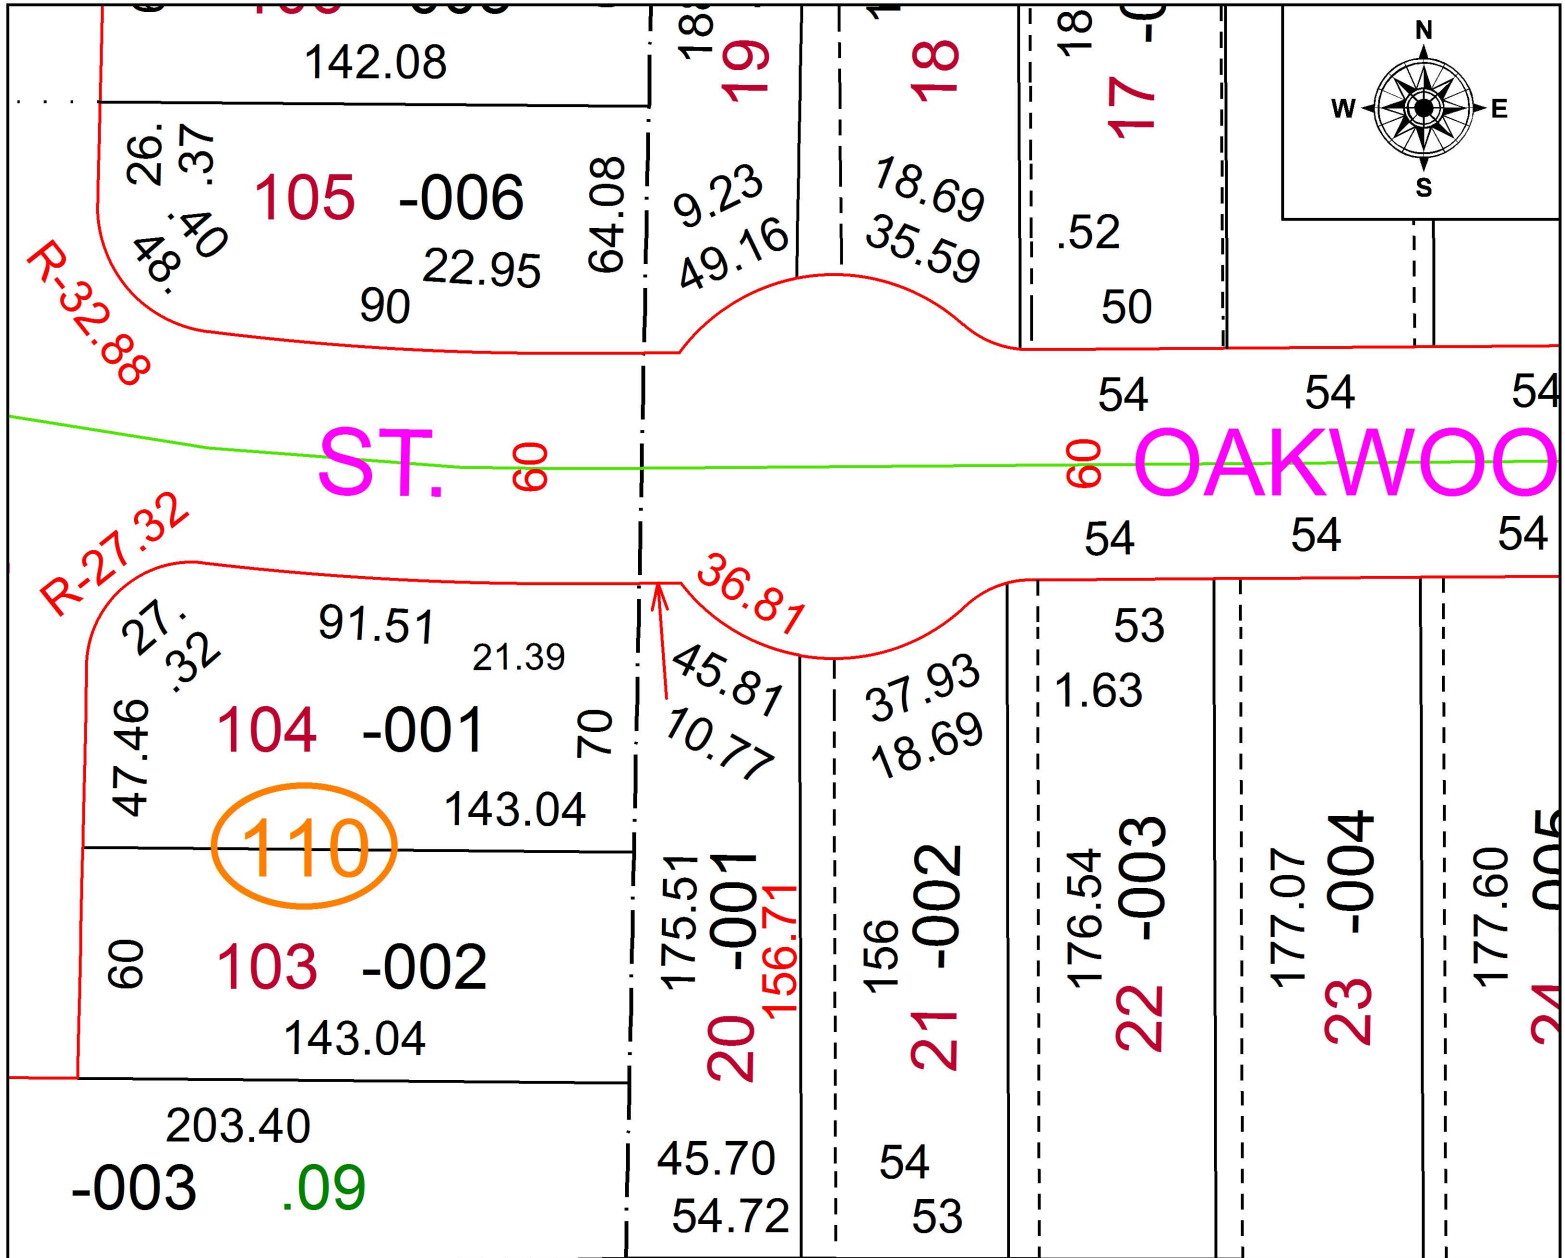

FRONTAGE & DEPTH CORRECTION
 47.58 X 175.51
~~45.70 X 176~~
 PER SURVEY BY S.BOLAND



SPLITS/DEEDS PROCESSED
 LORAIN COUNTY TAX MAP DEPARTMENT
 226 MIDDLE AVE. ELYRIA, OH

SURVEYED BY: SEAN A. BOLAND
 CLOSURE: 1: 169,793
 MAP PAGE(S): 6-78
 APPROVED BY: RRM DATE: 4-2-19
 SCALE: 1" = 50 PRIOR INSTRUMENT: 20180657934