


PARENT PARCEL: 11-00-045-000-056

CHILD PARCEL: 11-00-045-000-057, -058

STARTING POINT: INTERSECTION OF C/L OF S.R.82 AND C/L OF S.R.83

19-04073

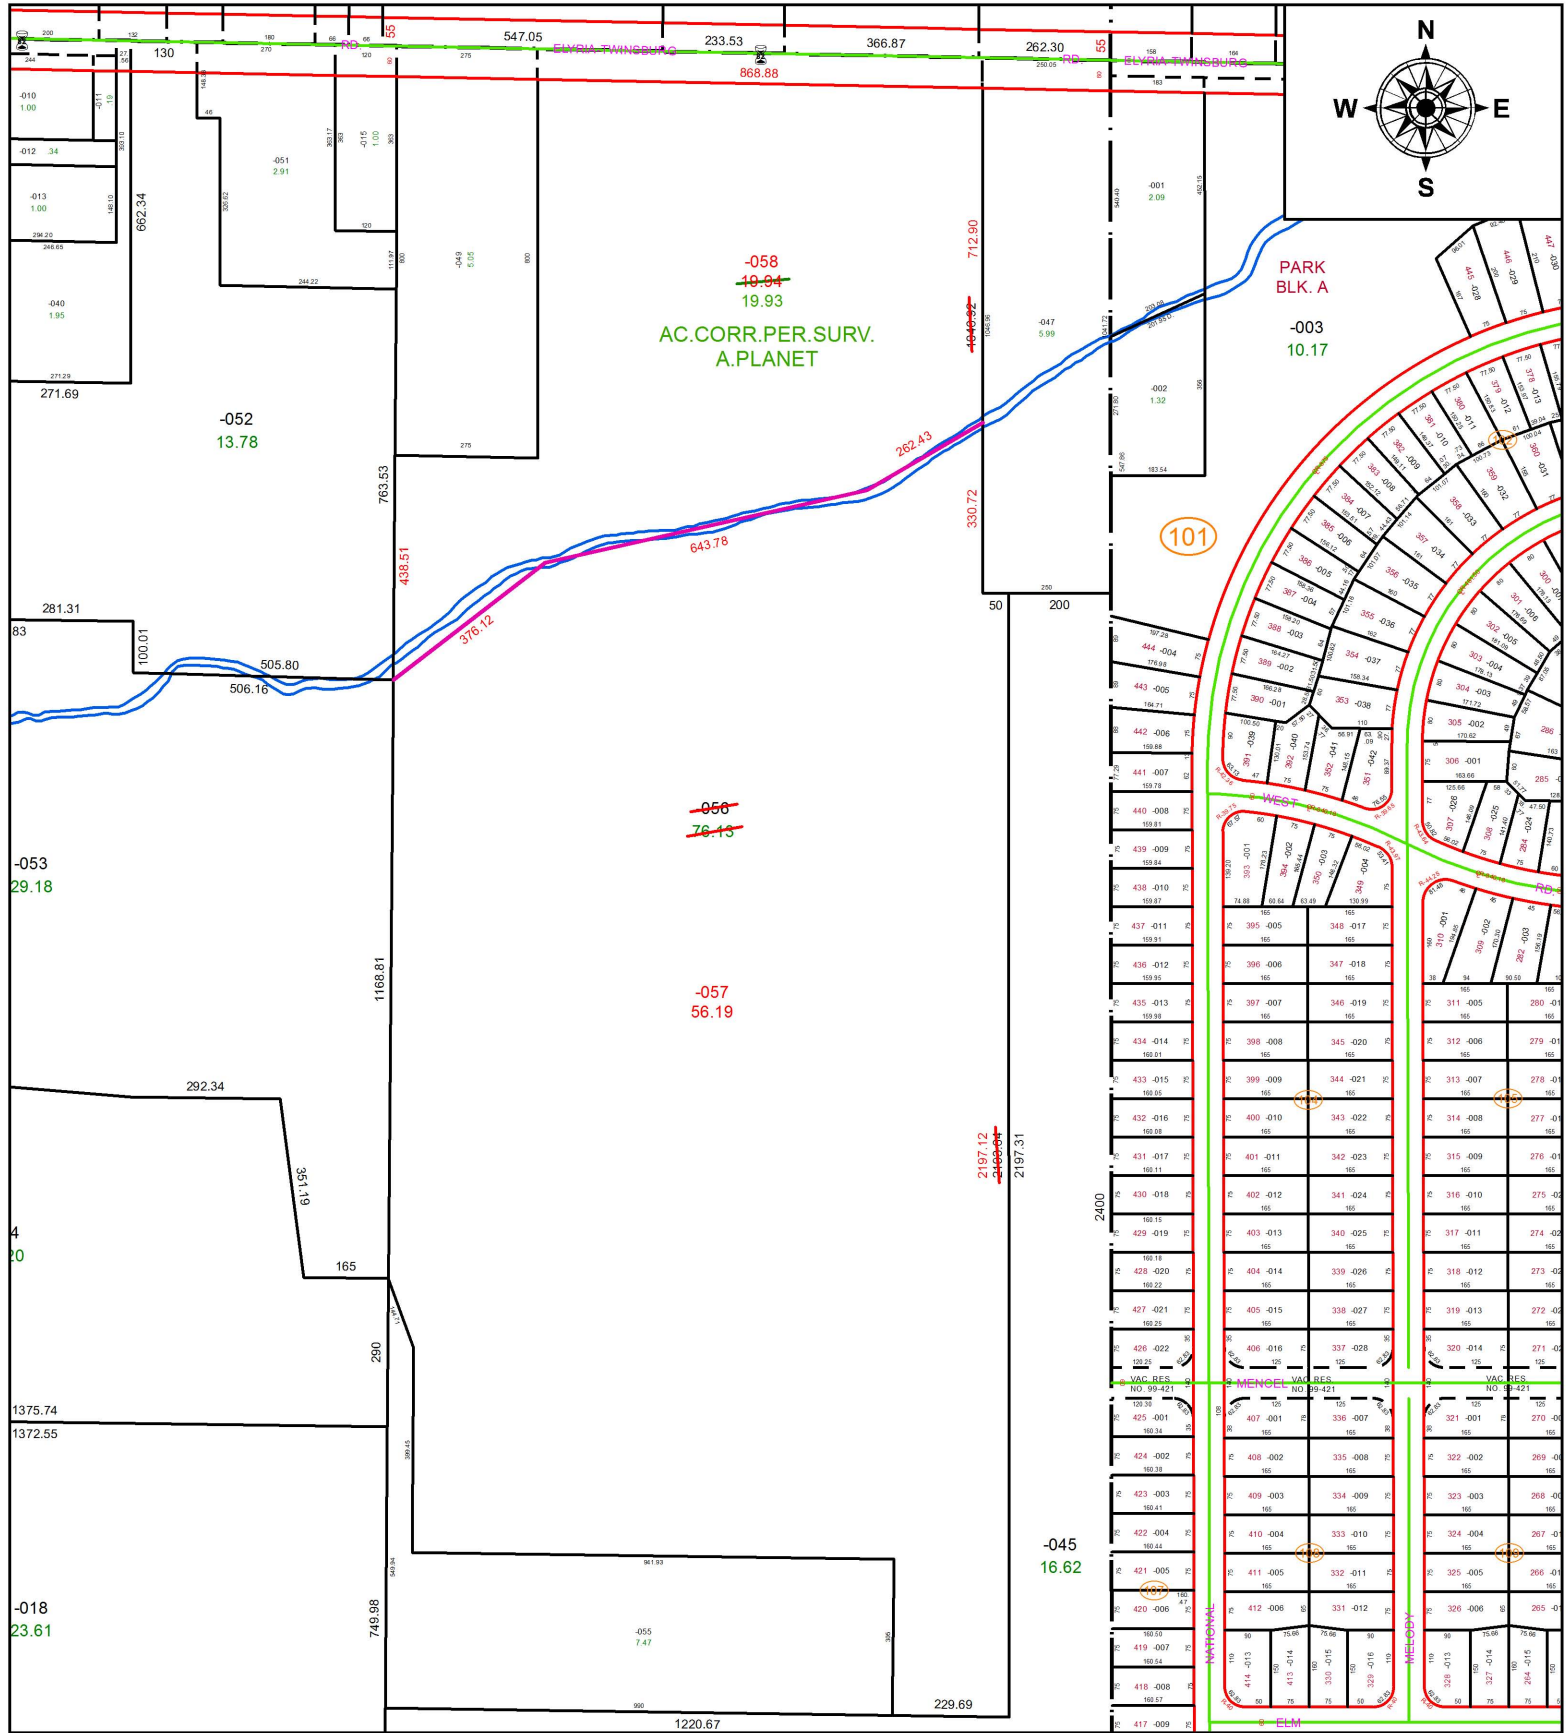

~~-058~~
19.94
19.93
AC.CORR.PER.SURV.
A.PLANET

PARK
BLK. A
~~-003~~
10.17


~~-052~~
13.78

~~-053~~
29.18

~~-056~~
76.13

~~-057~~
56.19

~~-045~~
16.62

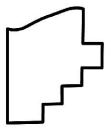

SPLITS/DEEDS PROCESSED
LORAIN COUNTY TAX MAP DEPARTMENT
226 MIDDLE AVE. ELYRIA, OH

SURVEYED BY: ANDREW G. PLANET
CLOSURE: 1:754,567
MAP PAGE(S): 11-00-045
APPROVED BY: RRM DATE: 12-20-19
SCALE: 1" = 375 PRIOR INSTRUMENT: 20010738234