
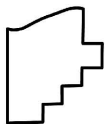


PARENT PARCEL: 07-00-030-000-026

CHILD PARCEL: 07-00-030-000-281, -282

STARTING POINT: SOUTHEAST CORNER OF O.L.30

19-04077-U

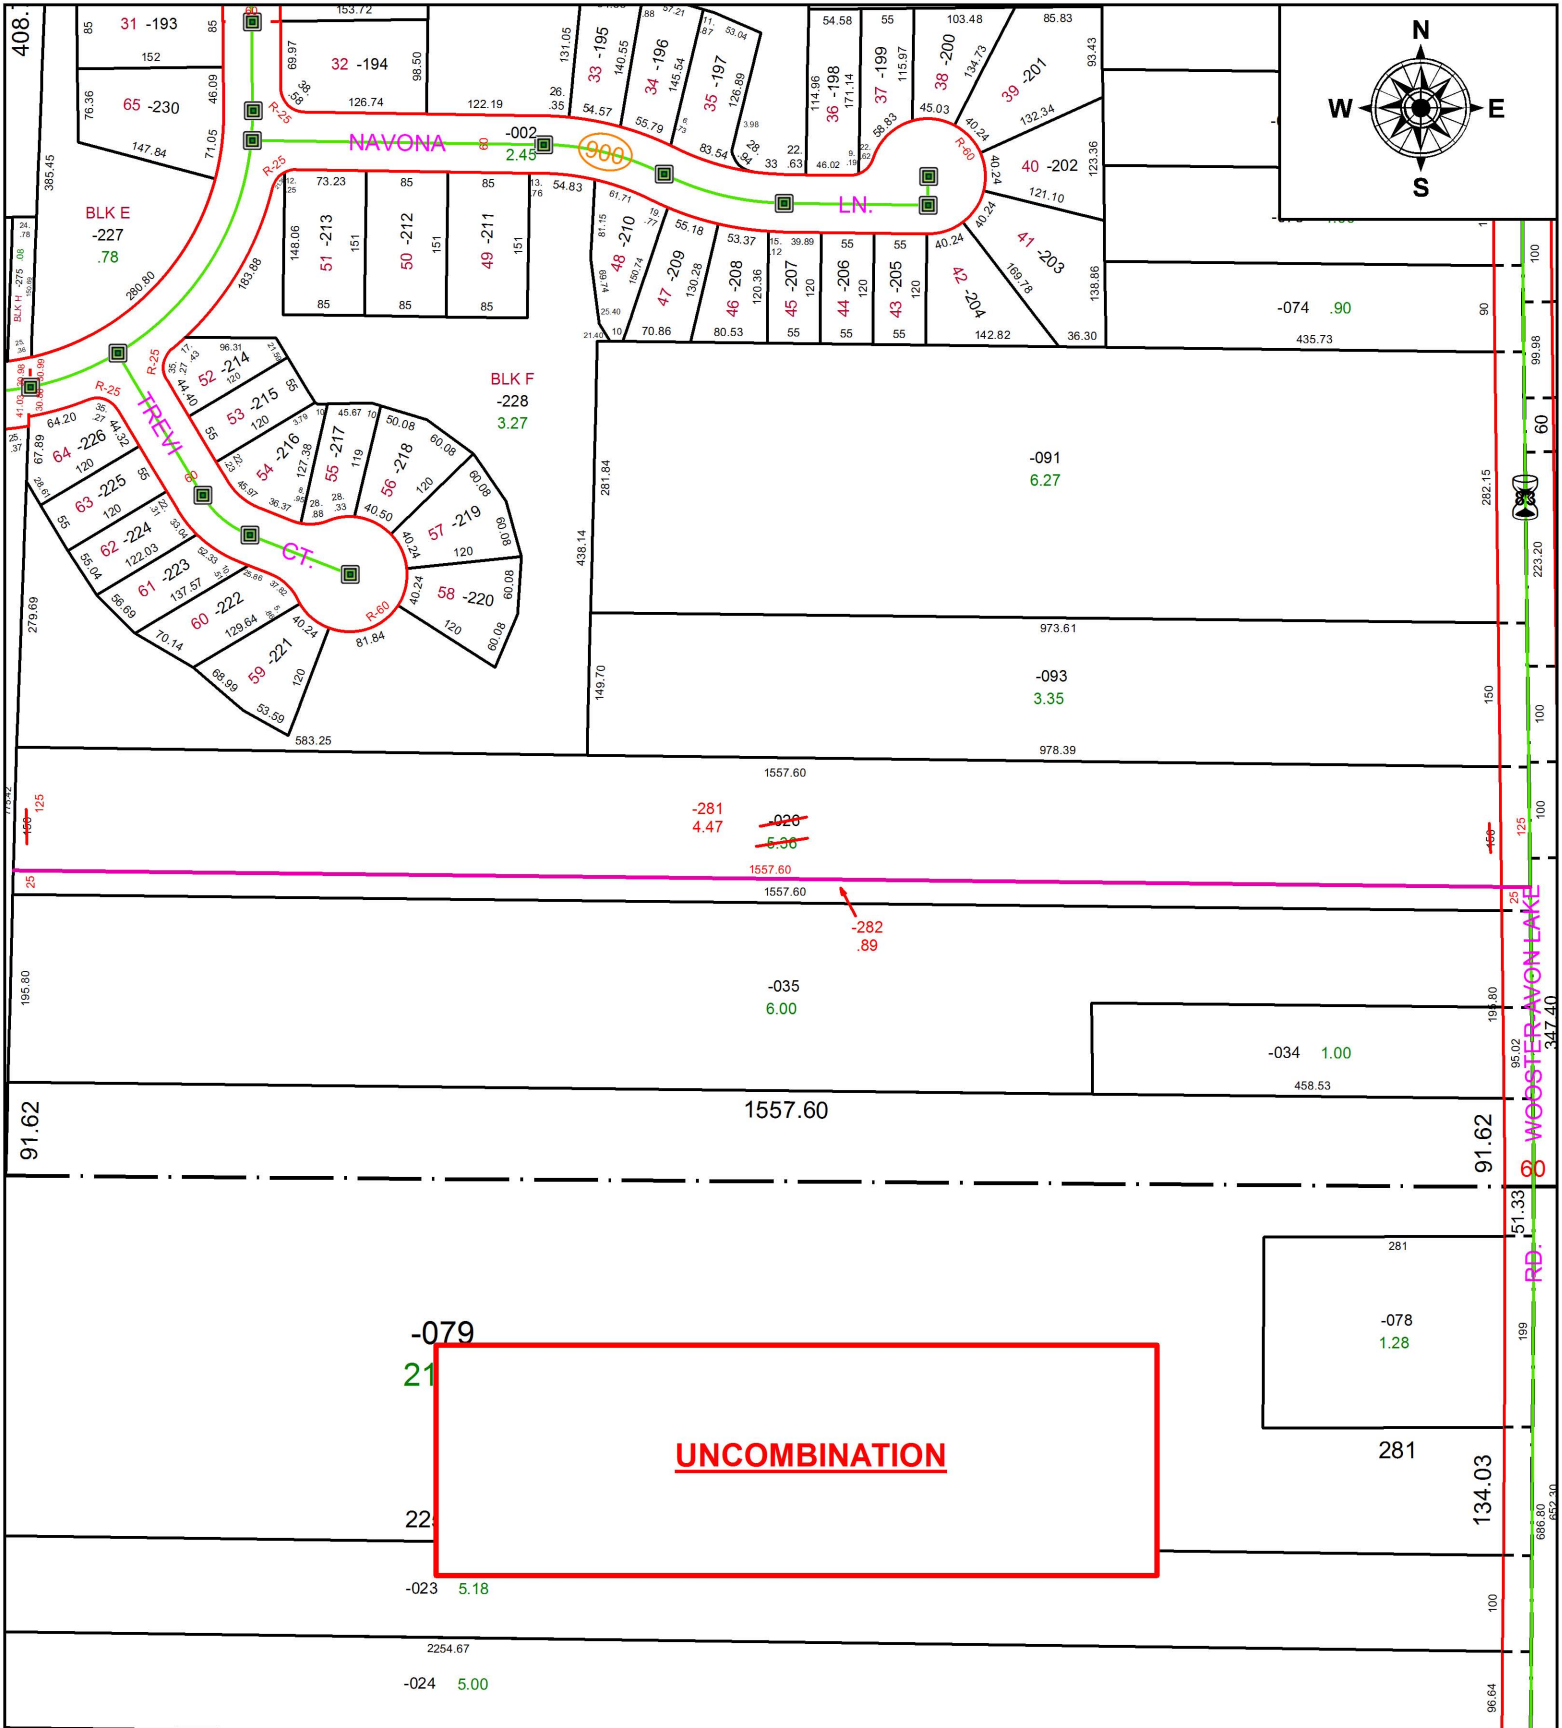

SPLITS/DEEDS PROCESSED
 LORAIN COUNTY TAX MAP DEPARTMENT
 226 MIDDLE AVE. ELYRIA, OH

SURVEYED BY: N/A
 CLOSURE: 1: 247348472
 MAP PAGE(S): 7-00-030
 APPROVED BY: RRM DATE: 4-26-19
 SCALE: 1" = 200 PRIOR INSTRUMENT: 20170650429