
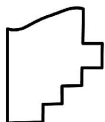
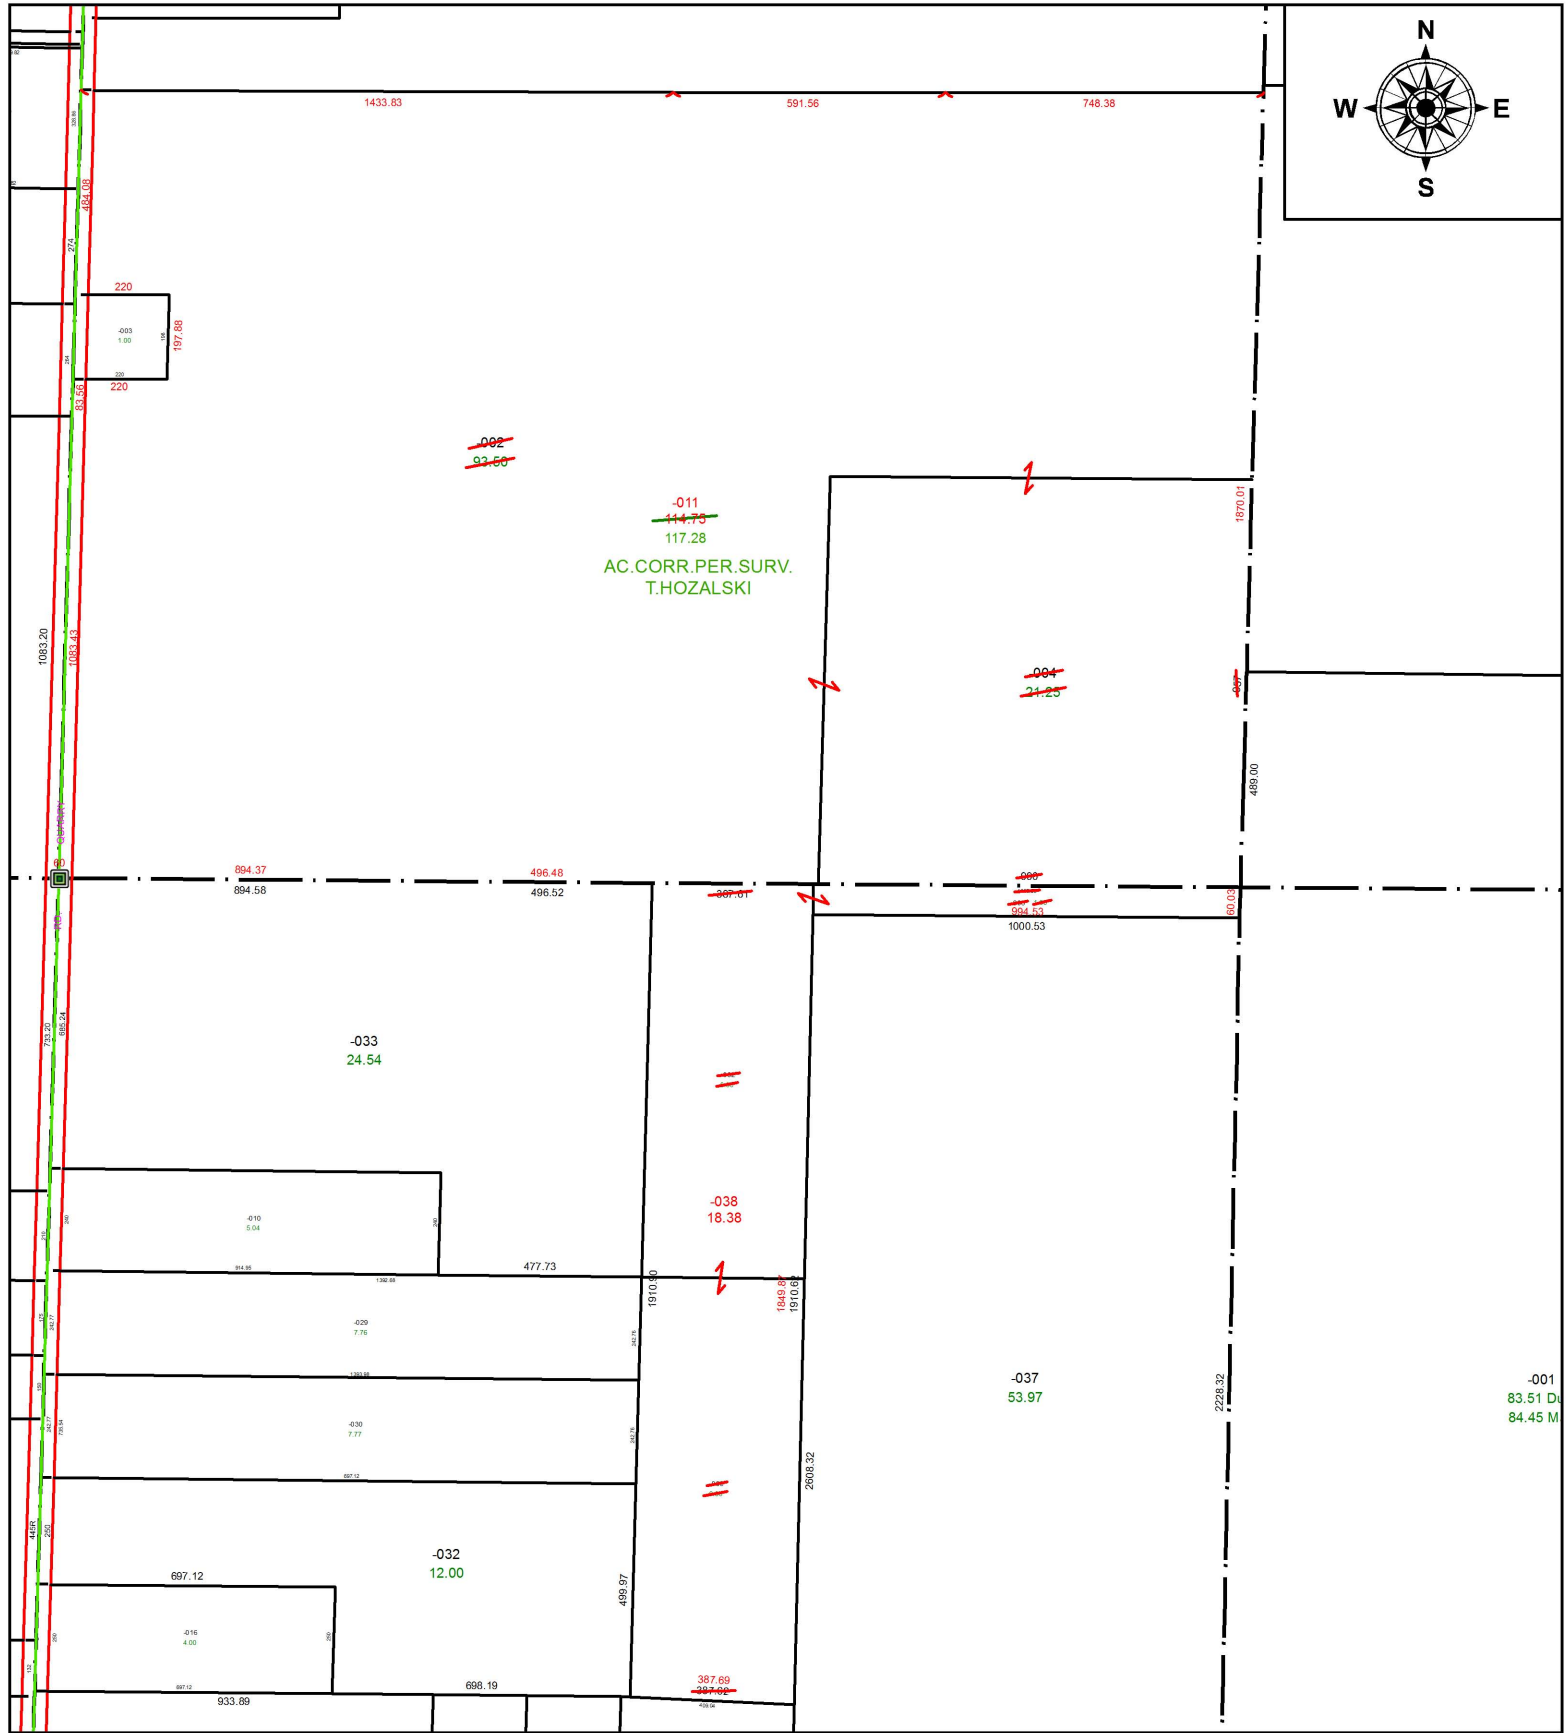


PARENT PARCEL: 09-00-062-000-002, -004. 09-00-072-000-002, -003, -005

CHILD PARCEL: 09-00-062-000-011. 09-00-072-000-038

STARTING POINT: NORTHWEST CORNER OF O.L.72

19-04078-A

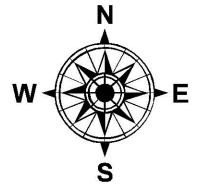

SPLITS/DEEDS PROCESSED
LORAIN COUNTY TAX MAP DEPARTMENT
226 MIDDLE AVE. ELYRIA, OH

SURVEYED BY: TIMOTHY D. HOZALSKI

CLOSURE: 1:874,671

MAP PAGE(S): 9-00-072

APPROVED BY: RRM DATE: 4-29-19

SCALE: 1" = 450 PRIOR INSTRUMENT: 2014050098