
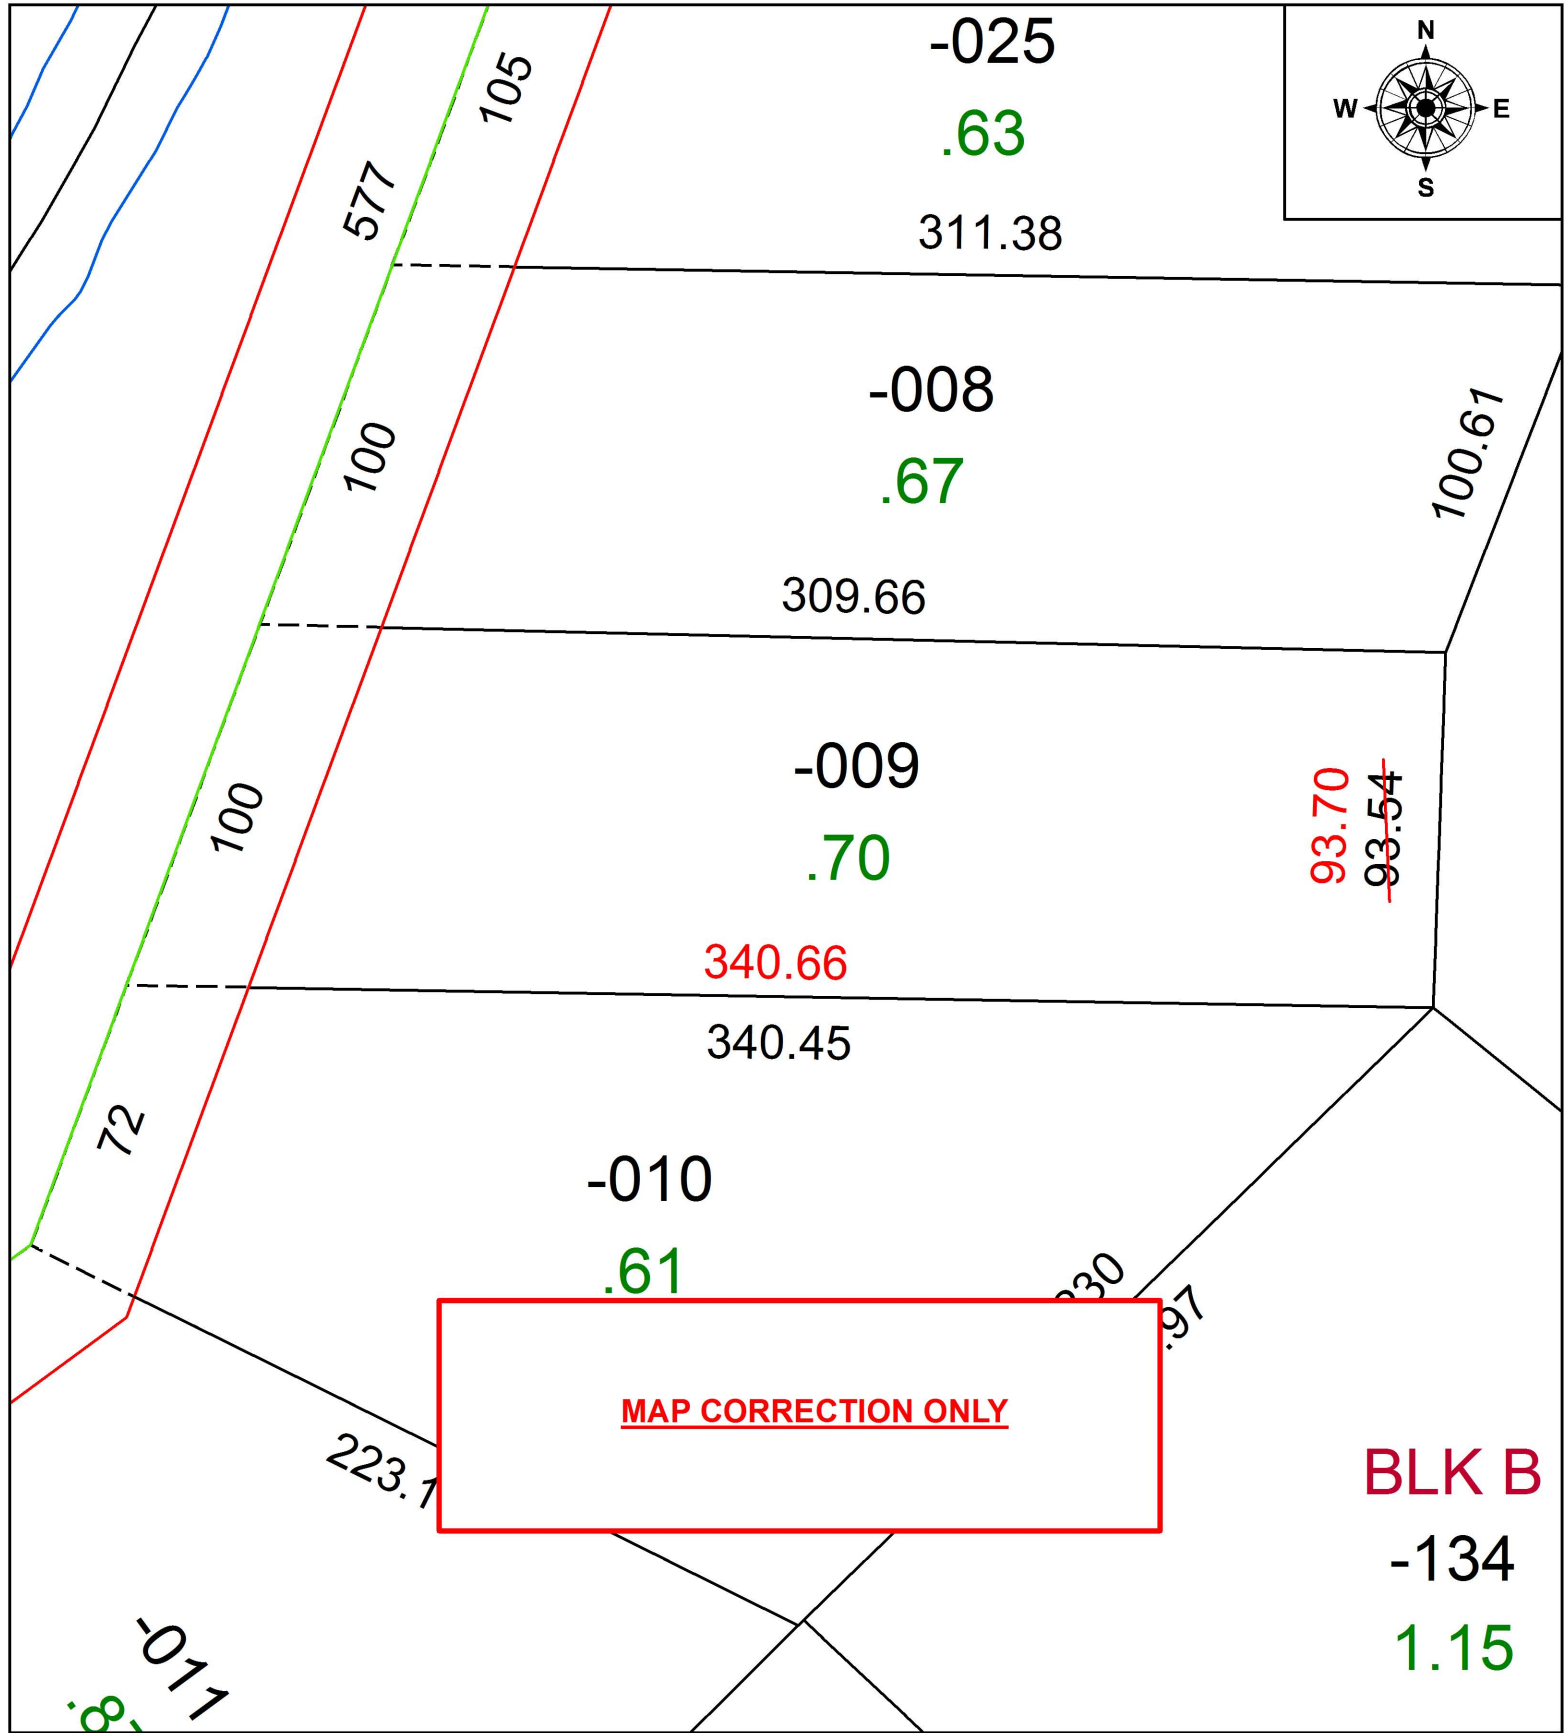


PARENT PARCEL: 05-00-021-103-009

CHILD PARCEL:

STARTING POINT: SOUTHWEST CORNER OF BLOCK A IN PRESERVE AT QUARRY LAKES SUB. NO.1

19-04079-D

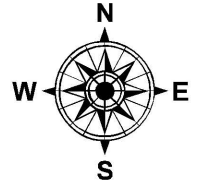

-025

.63

311.38

-008

.67

309.66

-009

.70

340.66

340.45

-010

.61

223.1

MAP CORRECTION ONLY

100.61


93.70

~~93.54~~

BLK B

-134

1.15

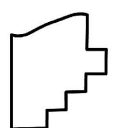

SPLITS/DEEDS PROCESSED
LORAIN COUNTY TAX MAP DEPARTMENT
226 MIDDLE AVE. ELYRIA, OH

SURVEYED BY: THOMAS A. SIMON
CLOSURE: 1: 317,480
MAP PAGE(S): 5-00-021
APPROVED BY: RRM DATE: 4-30-19
SCALE: 1" = 50' PRIOR INSTRUMENT: 20180697190