


PARENT PARCEL: 03-00-096-108-047, -048

CHILD PARCEL:

STARTING POINT: SOUTHWEST CORNER OF S/L 1093

19-04081-C

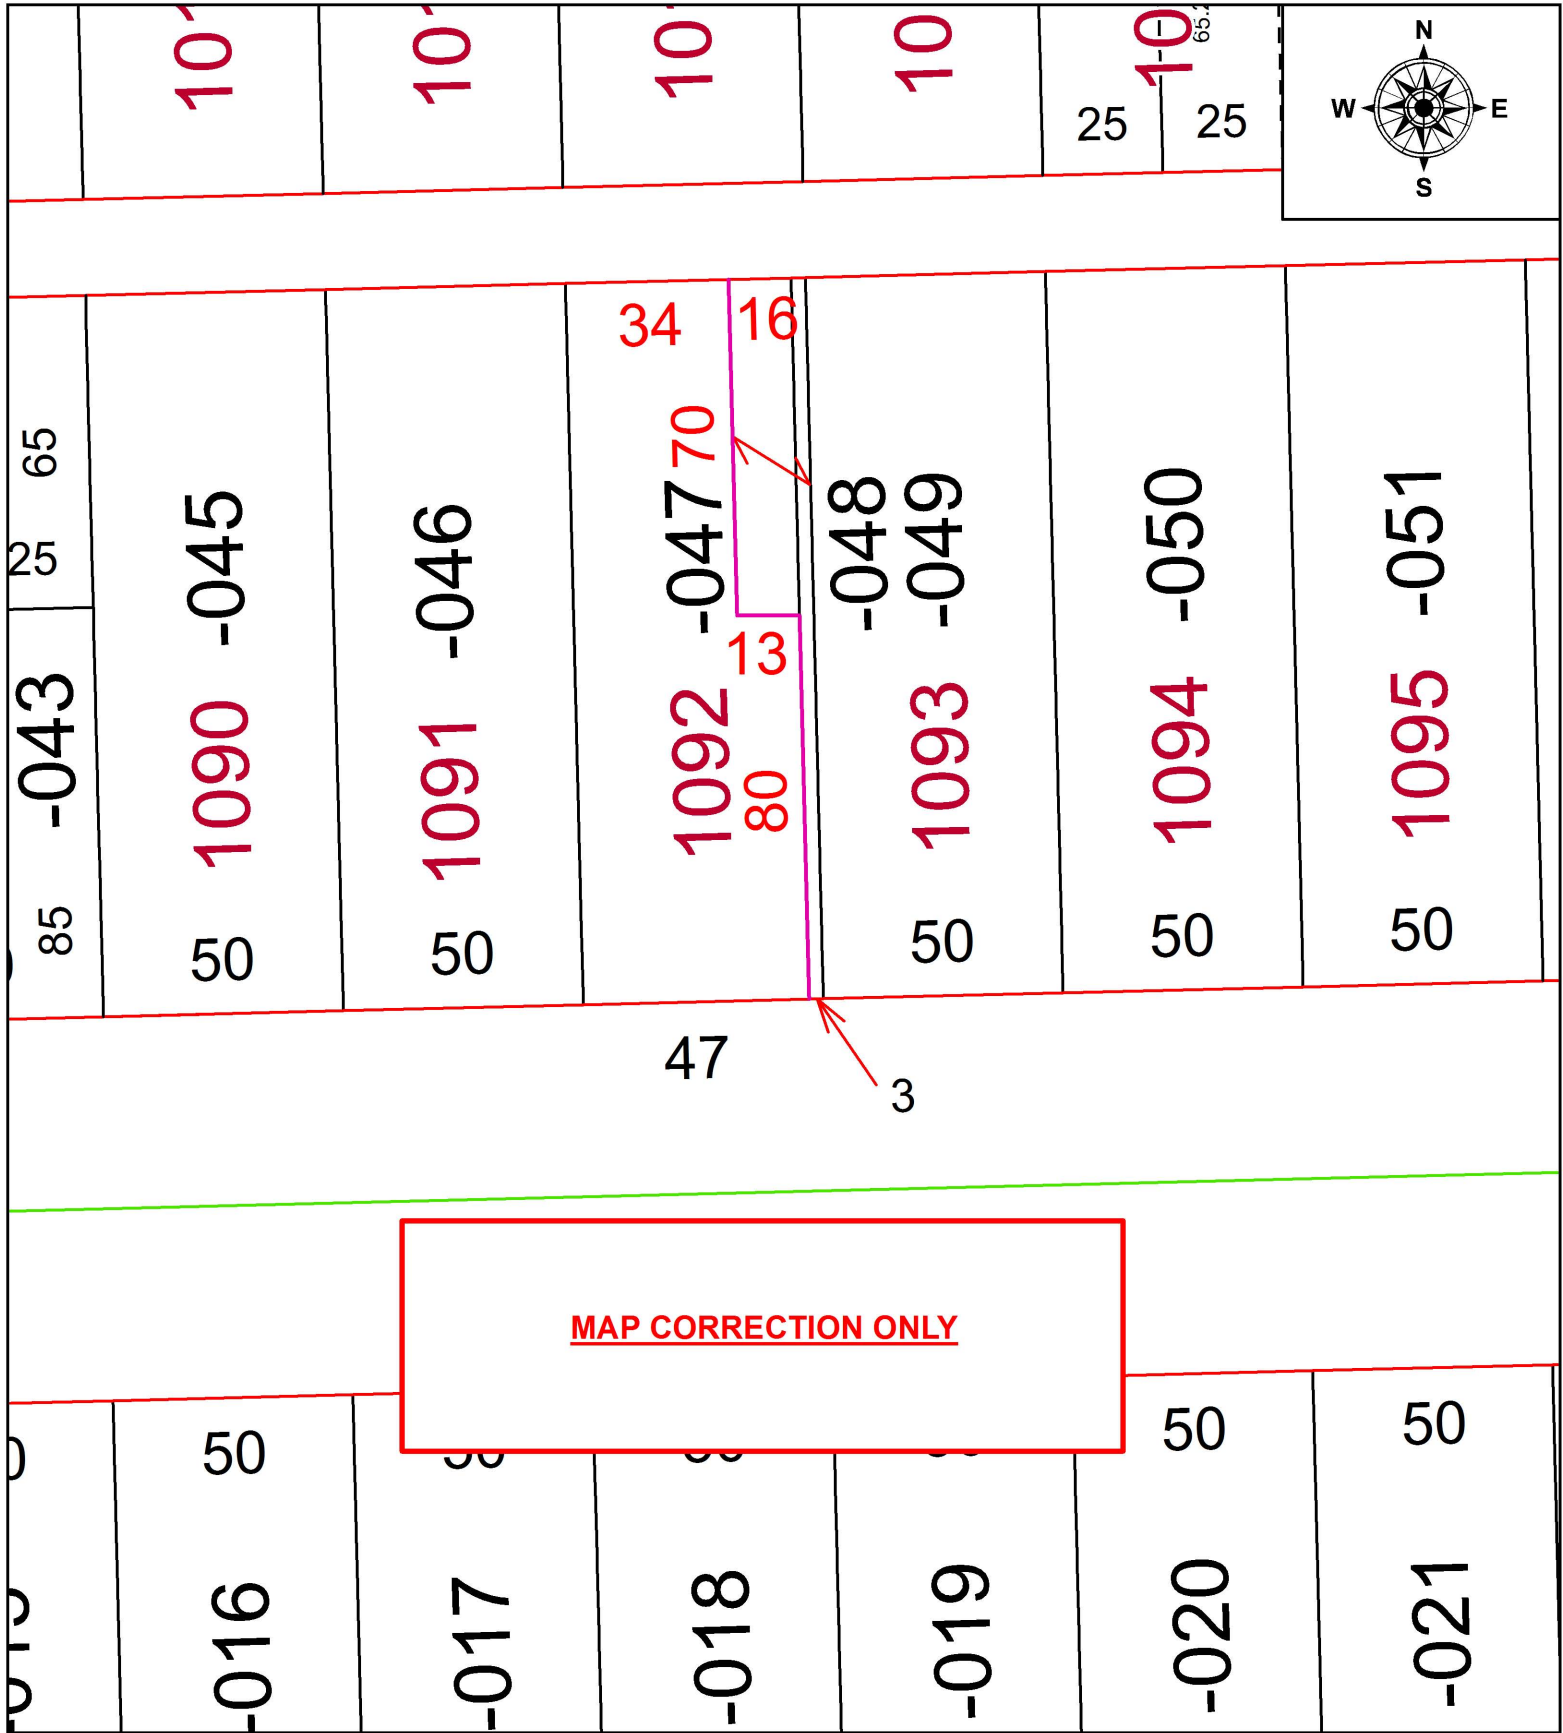

**MAP CORRECTION ONLY**



**SPLITS/DEEDS PROCESSED**  
LORAIN COUNTY TAX MAP DEPARTMENT  
226 MIDDLE AVE. ELYRIA, OH

SURVEYED BY:	N/A
CLOSURE:	N/A
MAP PAGE(S):	3-00-096
APPROVED BY:	RRM DATE: 5-1-2019
SCALE:	1" = 40' PRIOR INSTRUMENT: