
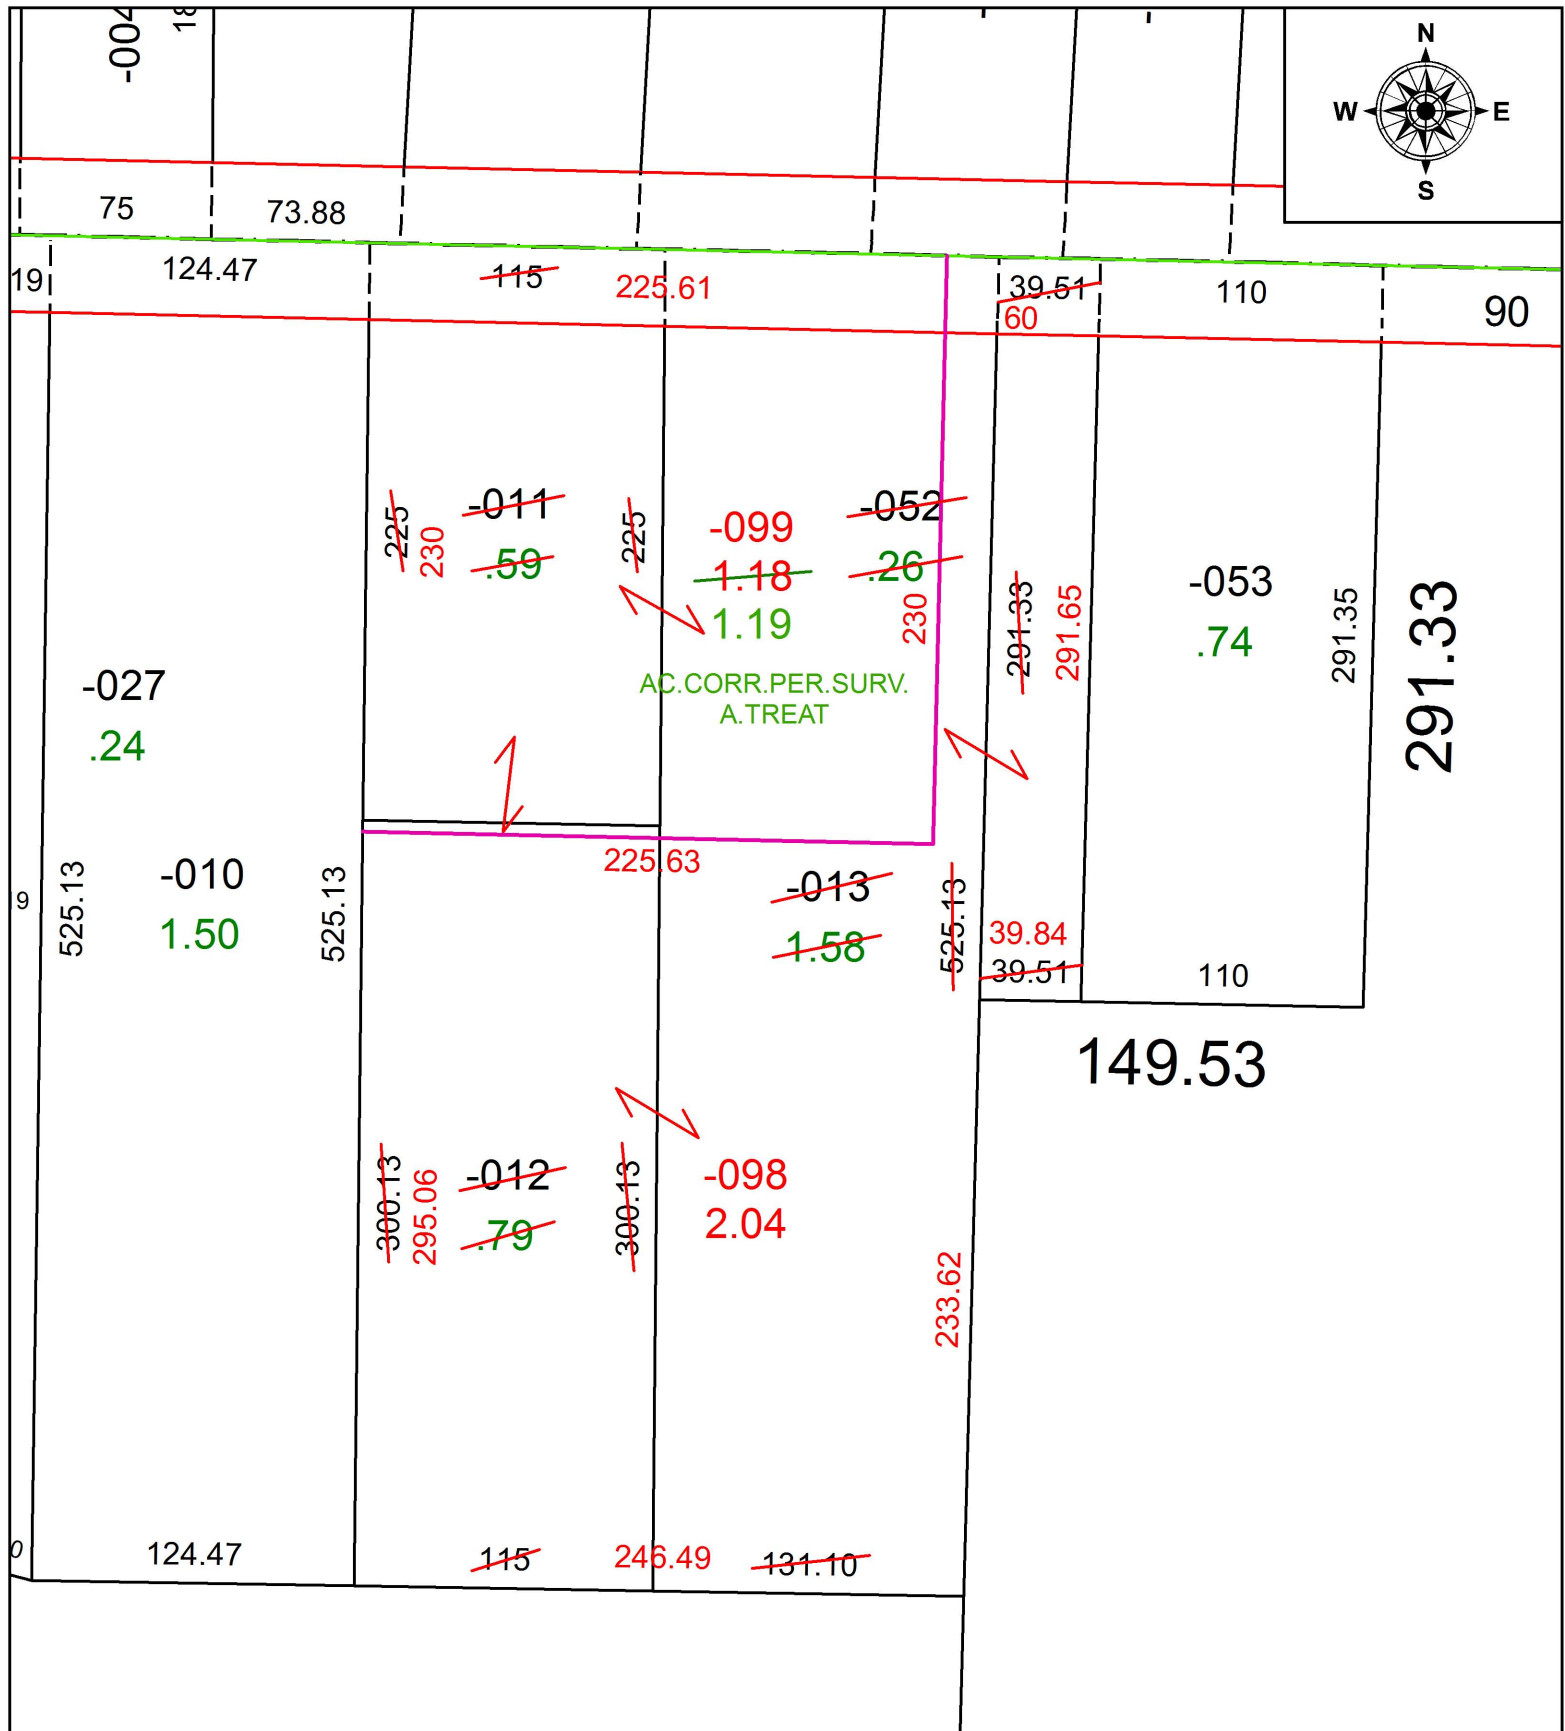


PARENT PARCEL: 07-00-003-102-011, -012, -013, -052

CHILD PARCEL: 07-00-003-102-098, -099

STARTING POINT: NORTHEAST CORNER OF O.L.3

20-04086

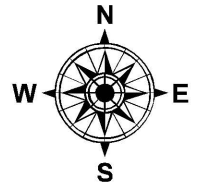

**SPLITS/DEEDS PROCESSED**  
 LORAIN COUNTY TAX MAP DEPARTMENT  
 226 MIDDLE AVE. ELYRIA, OH

SURVEYED BY: ADAM D. TREAT  
 CLOSURE: 1:134,761  
 MAP PAGE(S): 7-00-003  
 APPROVED BY: RRM DATE: 2-7-20  
 SCALE: 1" = 75 PRIOR INSTRUMENT: 20190737722