
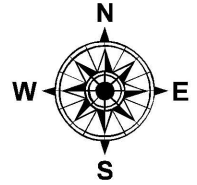


PARENT PARCEL: 07-00-021-118-017, -018, -020

CHILD PARCEL: 07-00-021-118-048 THRU -051

STARTING POINT: NORTHEAST CORNER OF S/L 12 IN ROOT FARM ALLOT.

20-04088

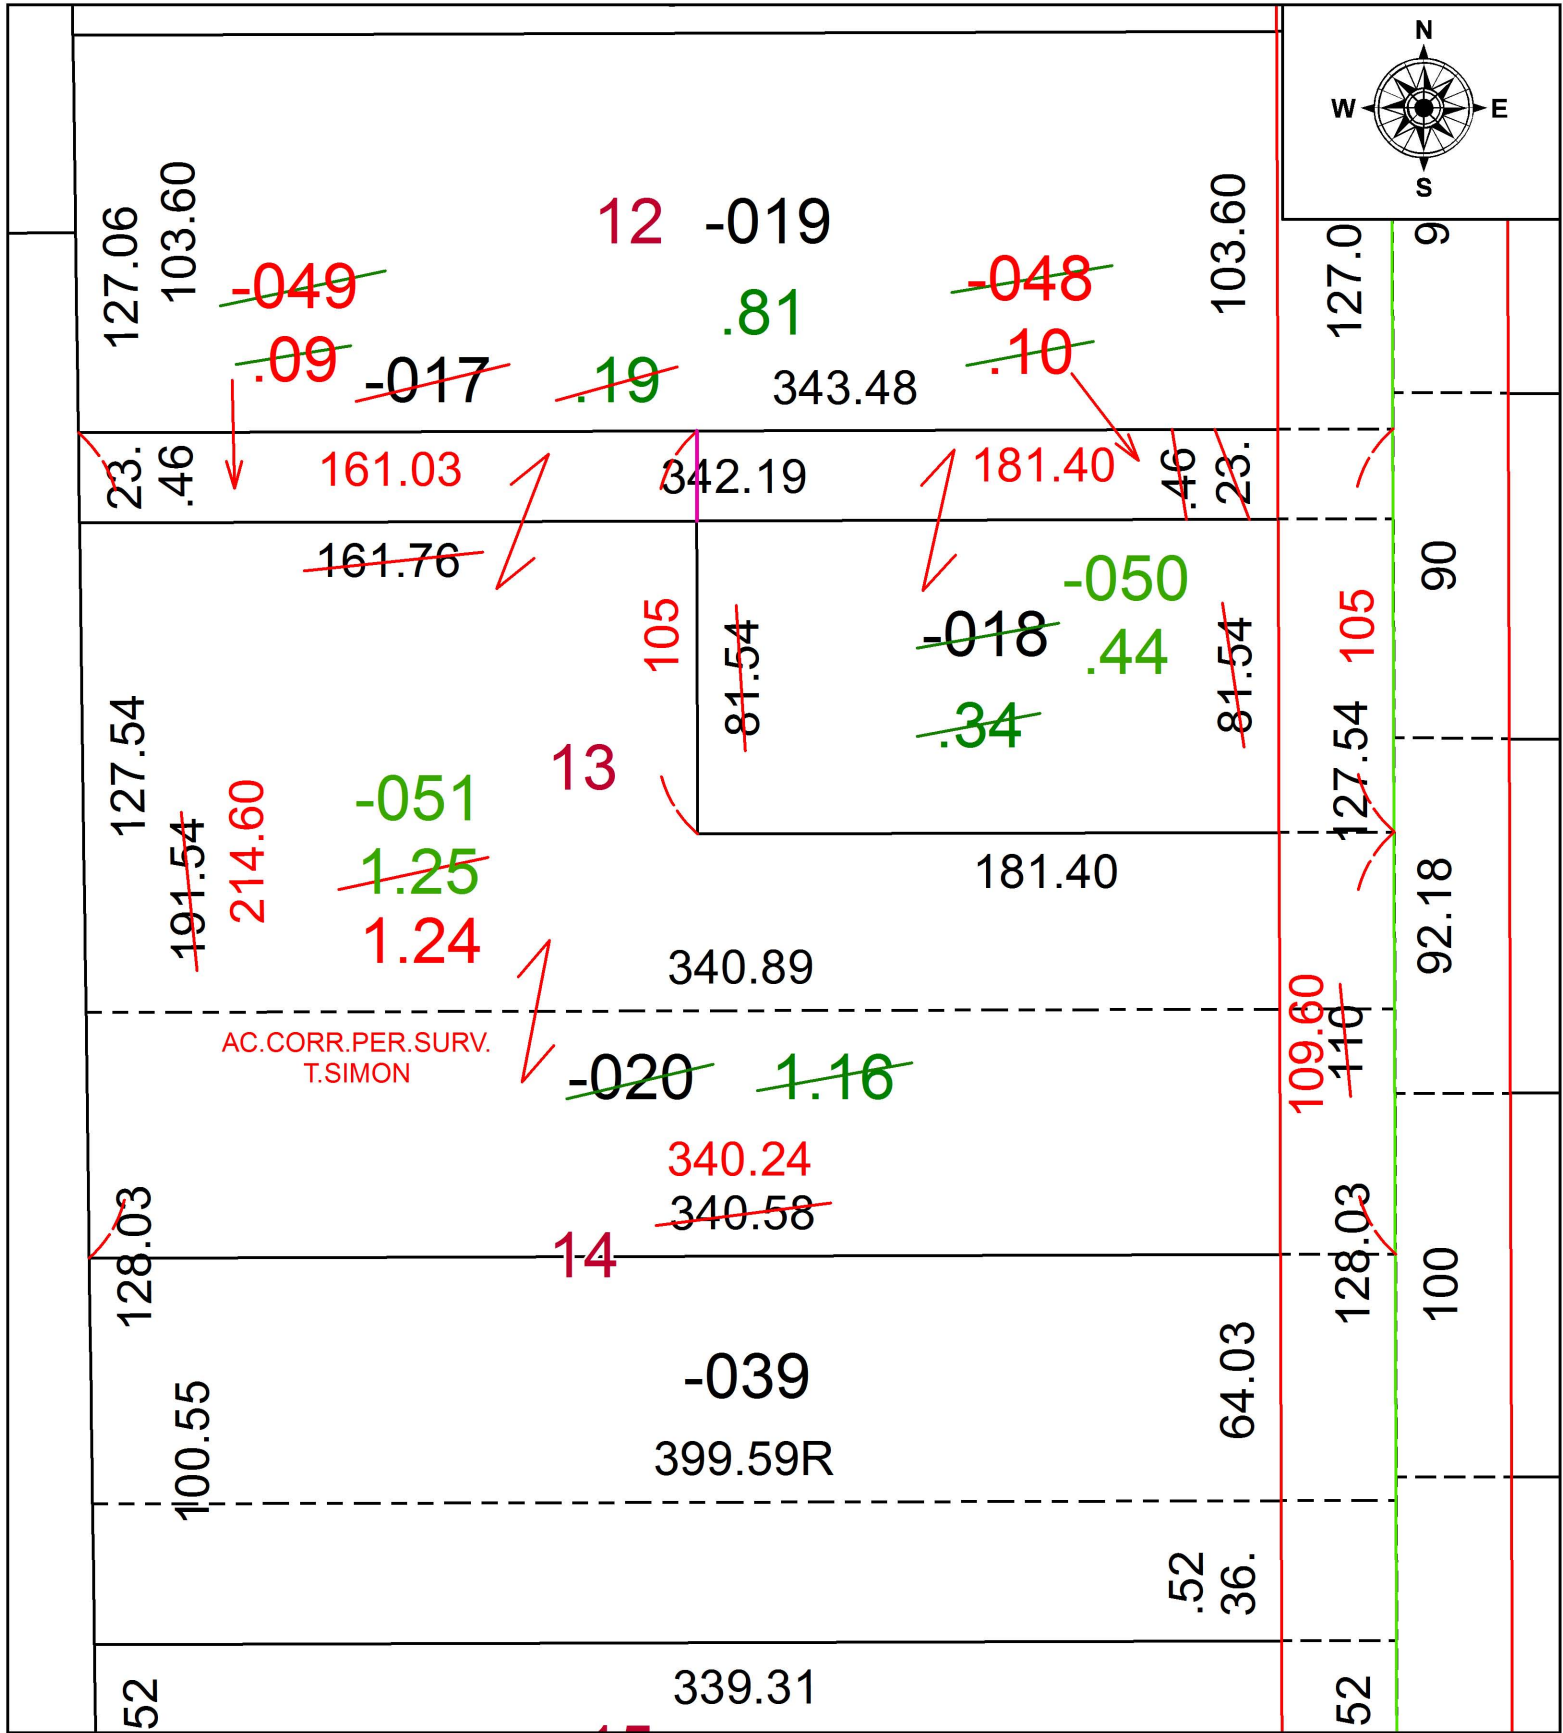

**SPLITS/DEEDS PROCESSED**  
 LORAIN COUNTY TAX MAP DEPARTMENT  
 226 MIDDLE AVE. ELYRIA, OH

SURVEYED BY: THOMAS A. SIMON  
 CLOSURE: 1:149,447  
 MAP PAGE(S): 7-00-021  
 APPROVED BY: RRM DATE: 2-10-20  
 SCALE: 1" = 50 PRIOR INSTRUMENT: 20110385879