
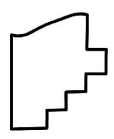
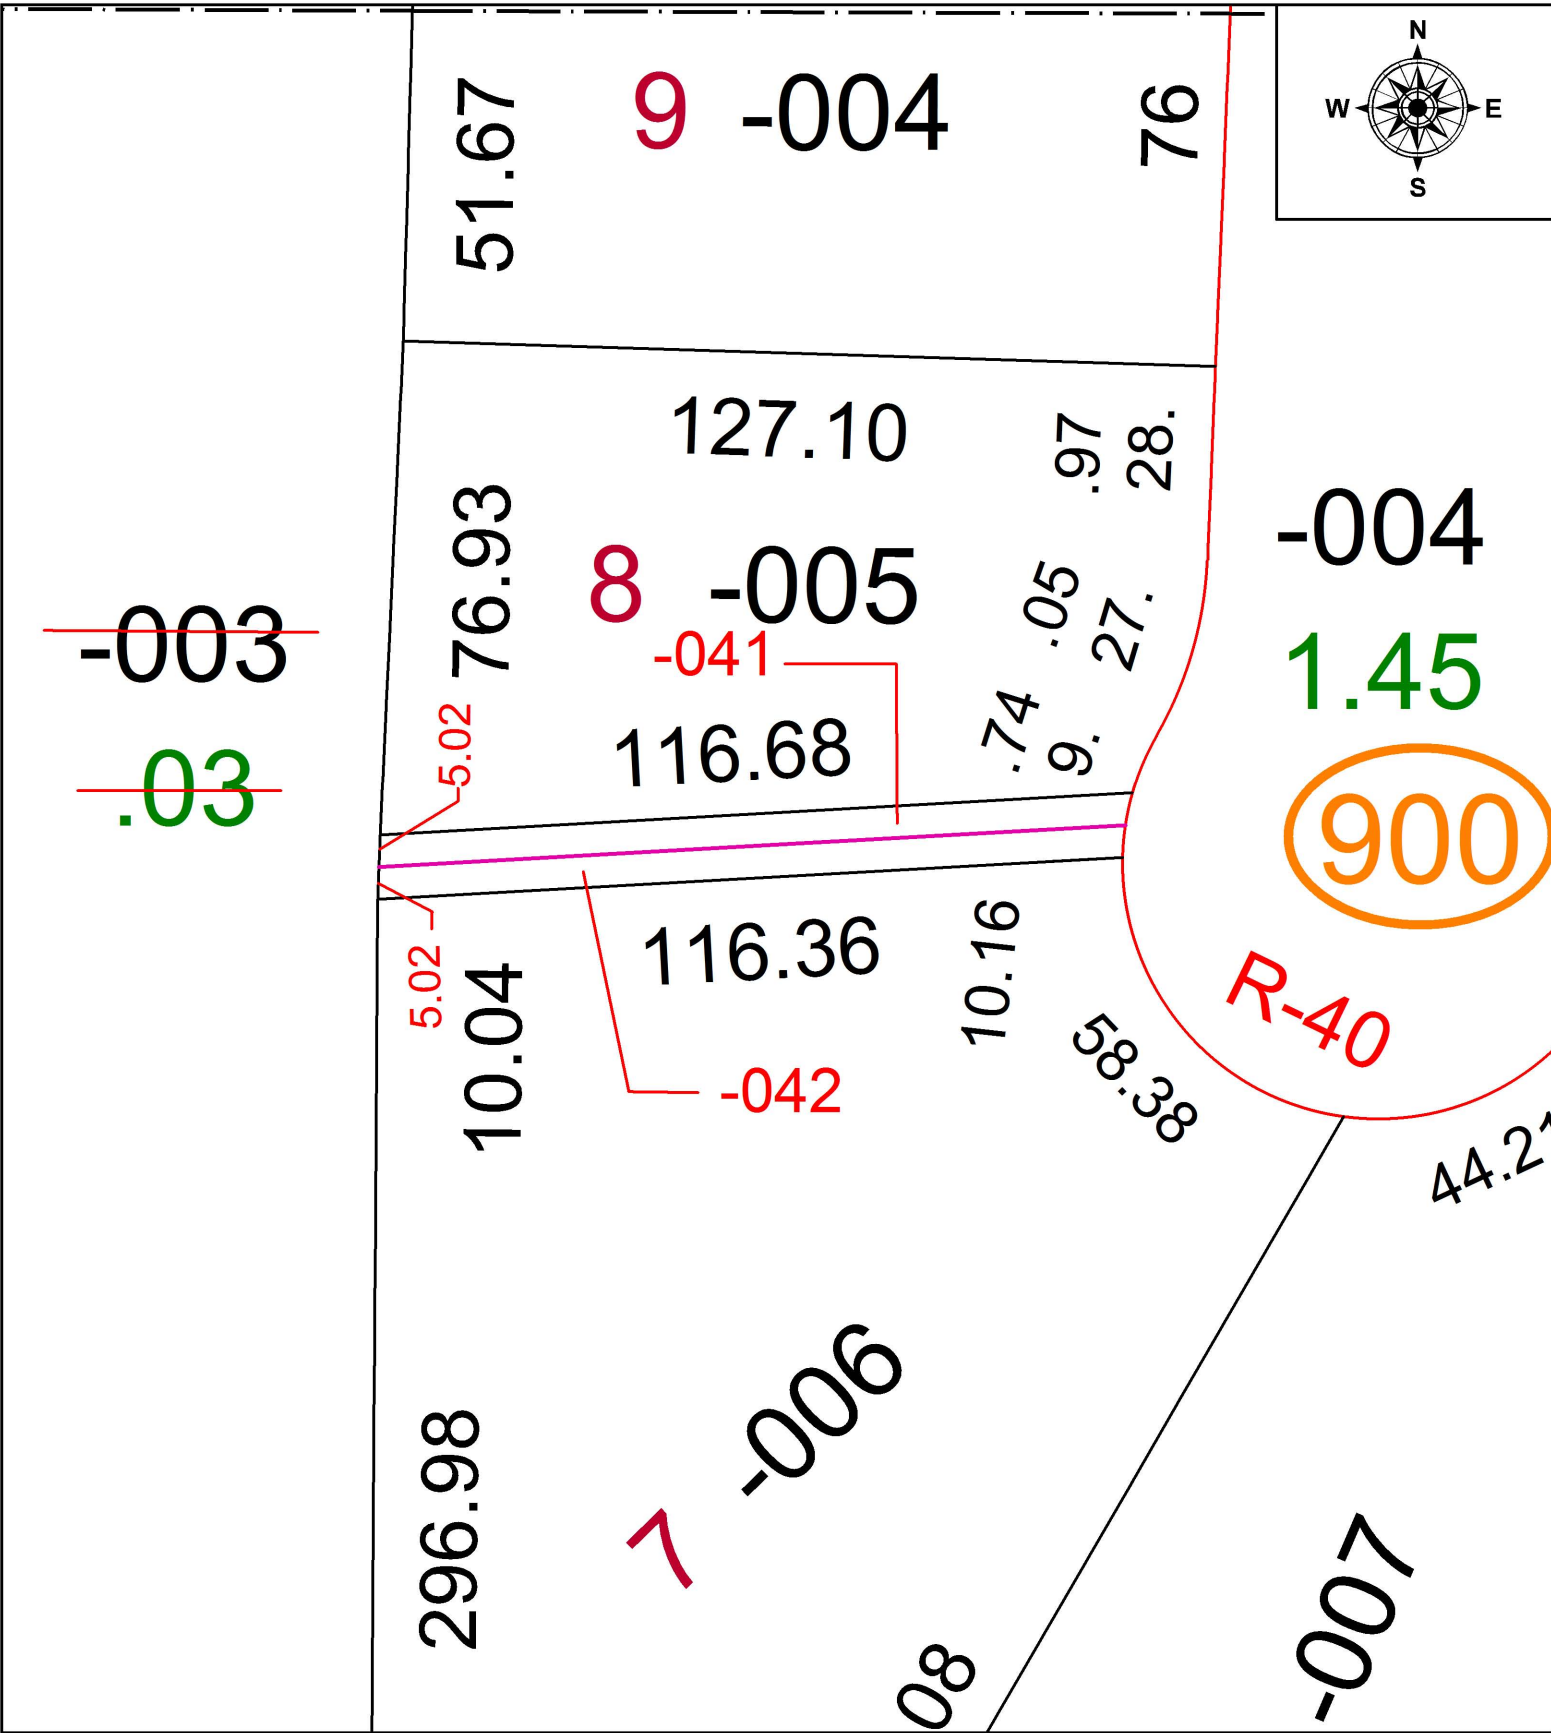


PARENT PARCEL: 05-00-038-900-003 VAC. PER ORD.# O-19-14

CHILD PARCEL: 05-00-038-101-041 & -042

STARTING POINT: "WALK" IN WOODHILL ACRES 1 PV. 20 PG.15A

19-04091-V

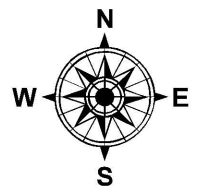

SPLITS/DEEDS PROCESSED
LORAIN COUNTY TAX MAP DEPARTMENT
226 MIDDLE AVE. ELYRIA, OH

SURVEYED BY: NA
CLOSURE: NA
MAP PAGE(S): 05-00-038
APPROVED BY: TJS DATE: 5/21/19
SCALE: 1" = 30' PRIOR INSTRUMENT: PV. 20 PG. 15A