


PARENT PARCEL: 05-00-051-000-019, -027, 05-00-070-000-001



CHILD PARCEL: 05-00-051-000-034 THRU -036, 05-00-070-000-001

STARTING POINT: INTERSECTION OF C/L OF OBERLIN RD. AND C/L OF ALBRECHT RD.

20-04091

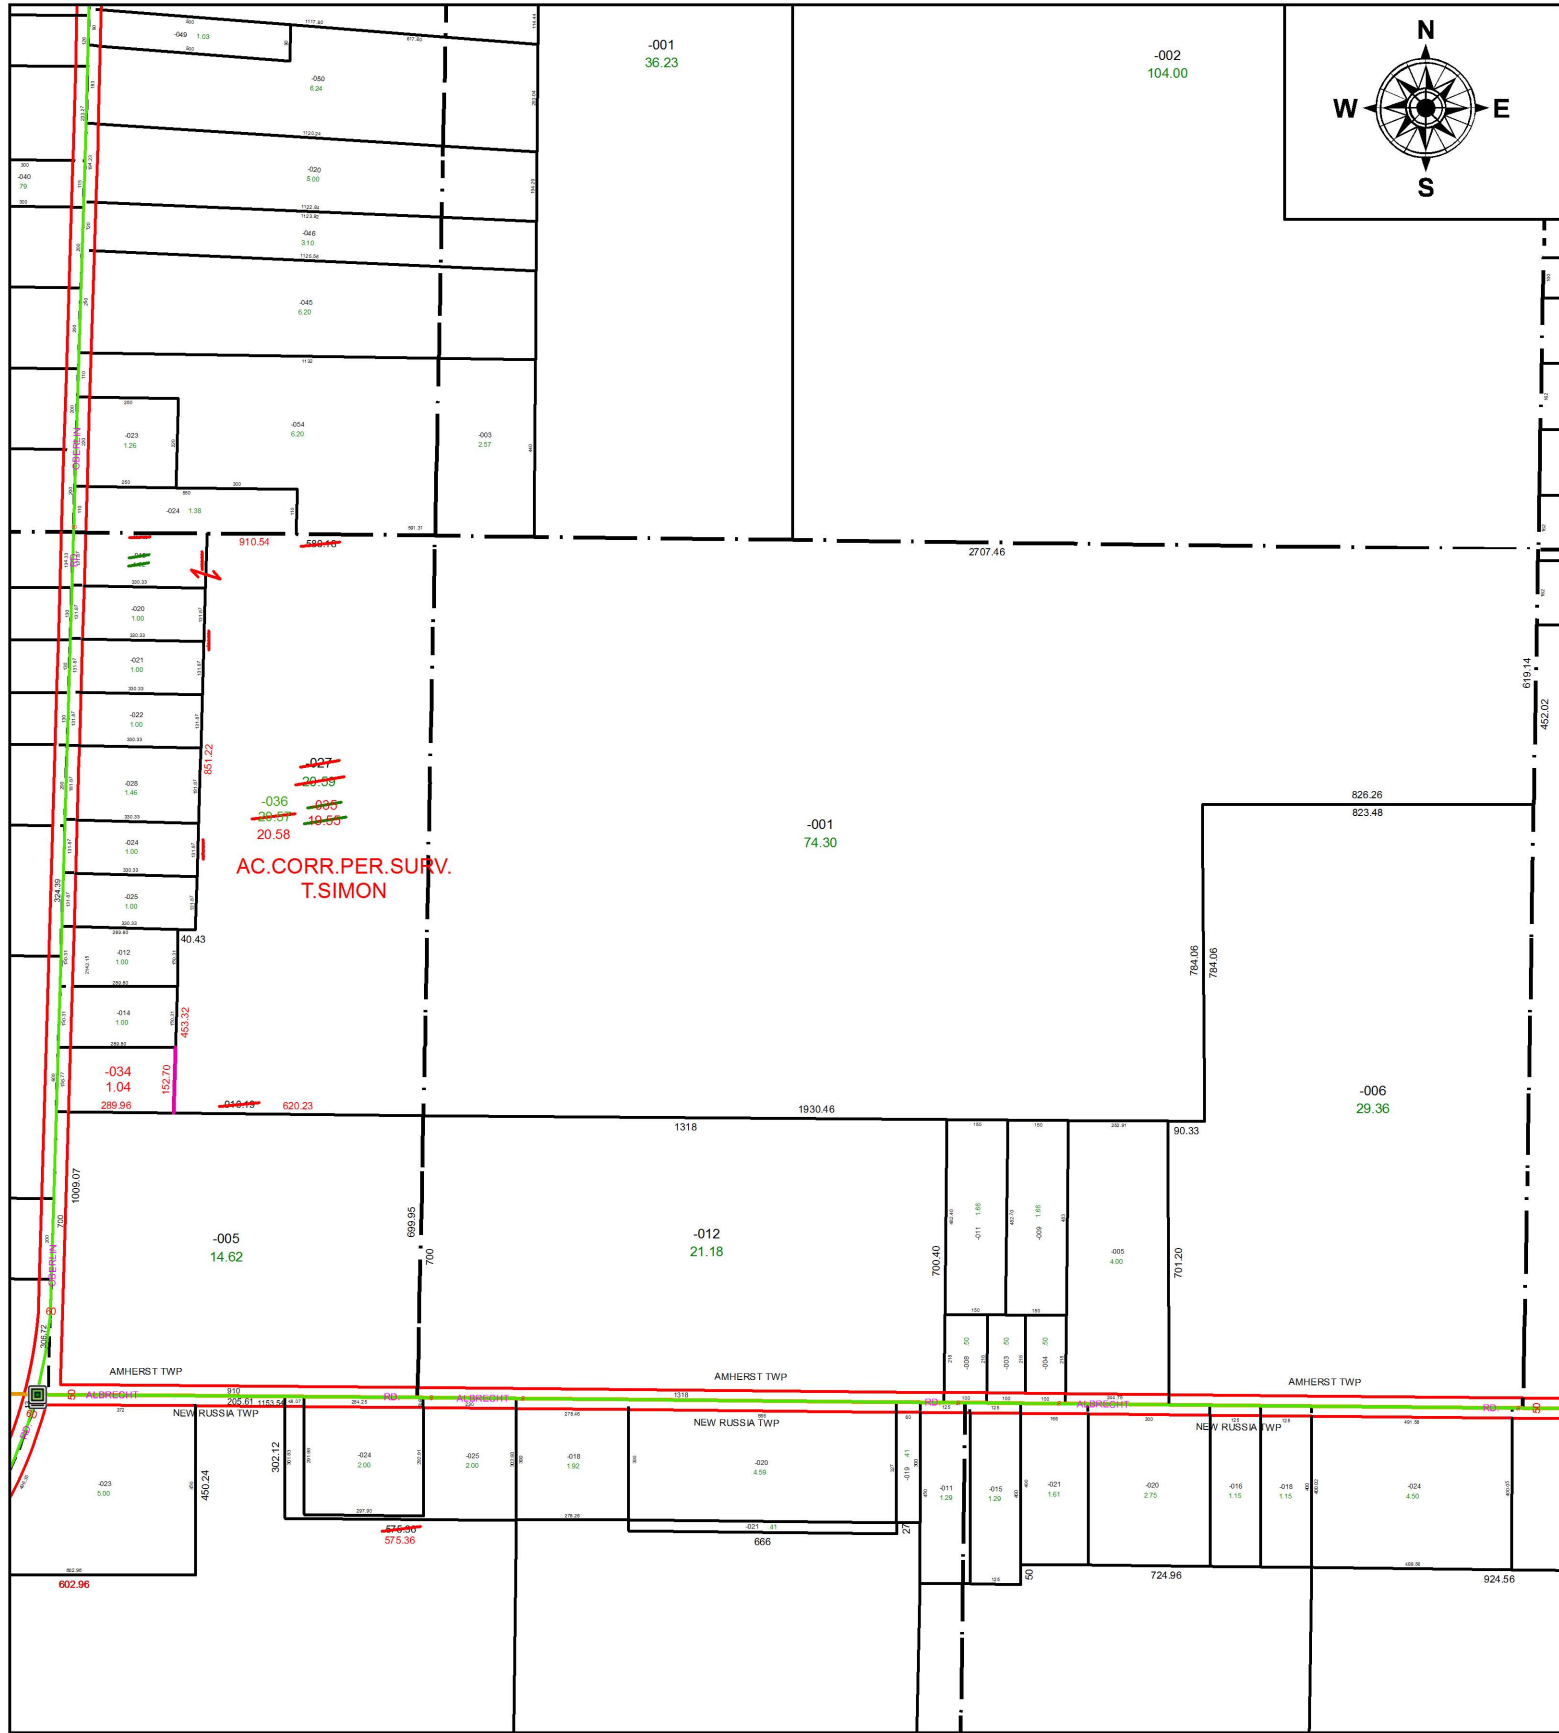

AC. CORR. PER SURV.  
T. SIMON

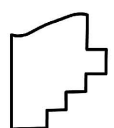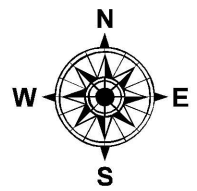

**SPLITS/DEEDS PROCESSED**  
 LORAIN COUNTY TAX MAP DEPARTMENT  
 226 MIDDLE AVE. ELYRIA, OH

SURVEYED BY: THOMAS A. SIMON  
 CLOSURE: 1: 227,474  
 MAP PAGE(S): 5-00-051  
 APPROVED BY: RRM DATE: 2-28-20  
 SCALE: 1" = 475 PRIOR INSTRUMENT: 20070190193