


PARENT PARCEL: 20-05-016-102-010, -015, 20-05-017-103-002, -025, -026, 20-05-018-000-008, -009

CHILD PARCEL: 20-05-016-102-019, -020, 20-05-017-103-002, -025, -030, 20-05-018-000-008, -009

STARTING POINT: NORTHWEST CORNER OF O.L.17 TR.5

20-04095

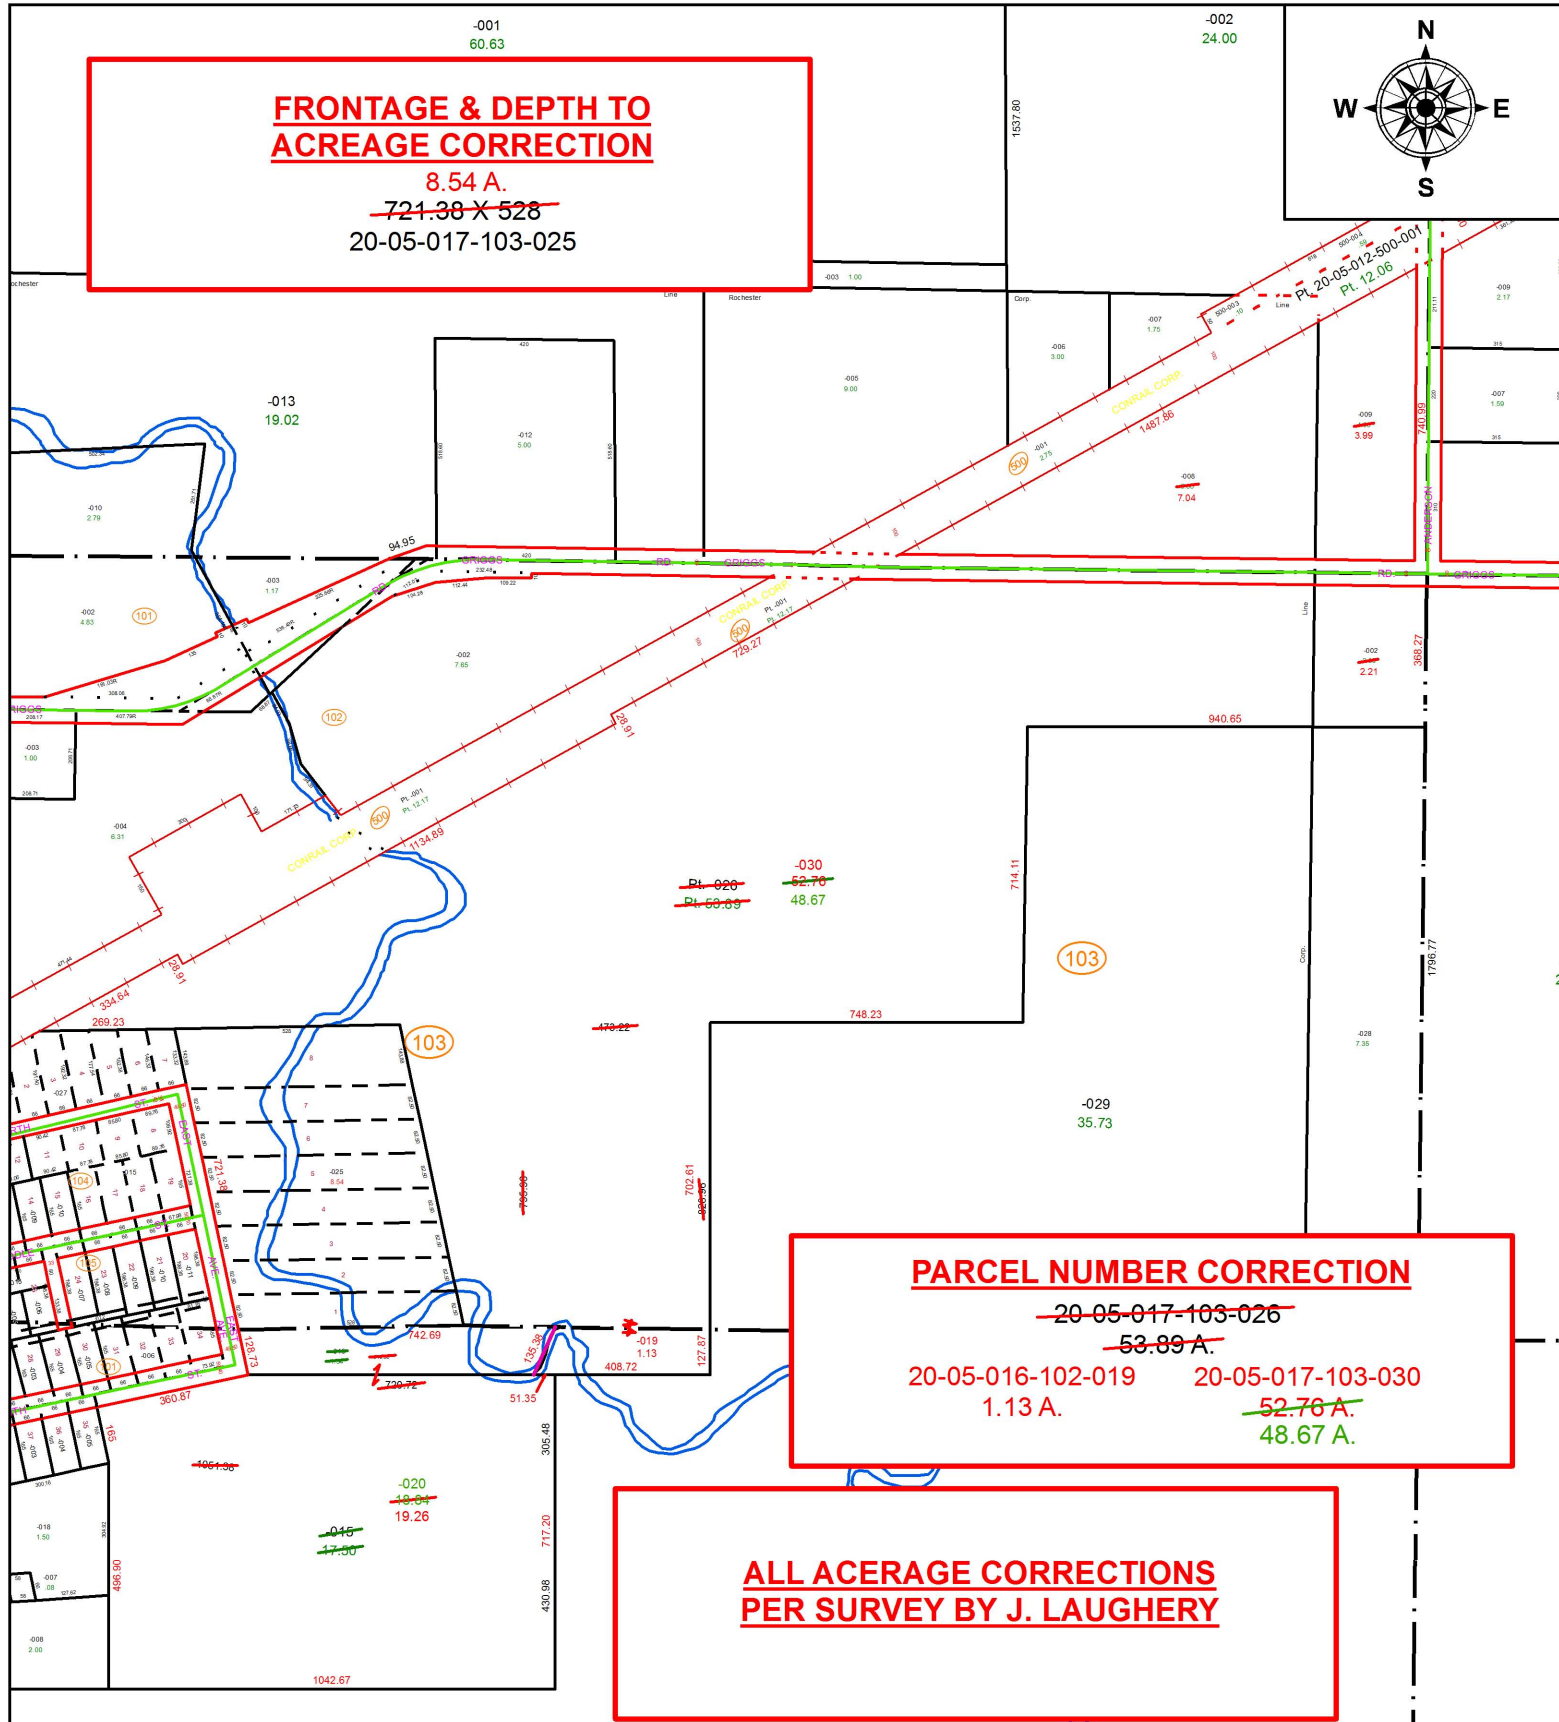

SPLITS/DEEDS PROCESSED
 LORAIN COUNTY TAX MAP DEPARTMENT
 226 MIDDLE AVE. ELYRIA, OH

SURVEYED BY: JASON K. LAUGHERY
 CLOSURE: 1:868,619
 MAP PAGE(S): 20-05-017
 APPROVED BY: RRM DATE: 3-2-20
 SCALE: 1" = 450 PRIOR INSTRUMENT: 20150547506