
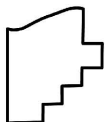


PARENT PARCEL: 15-00-012-000-015, -016

CHILD PARCEL: 15-00-011-000-043, -044, 15-00-012-000-027 THRU -029, 15-00-013-000-027

STARTING POINT: INTERSECTION OF C/L OF BIGGS RD. AND C/L OF INDIAN HOLLOW RD.

20-04096

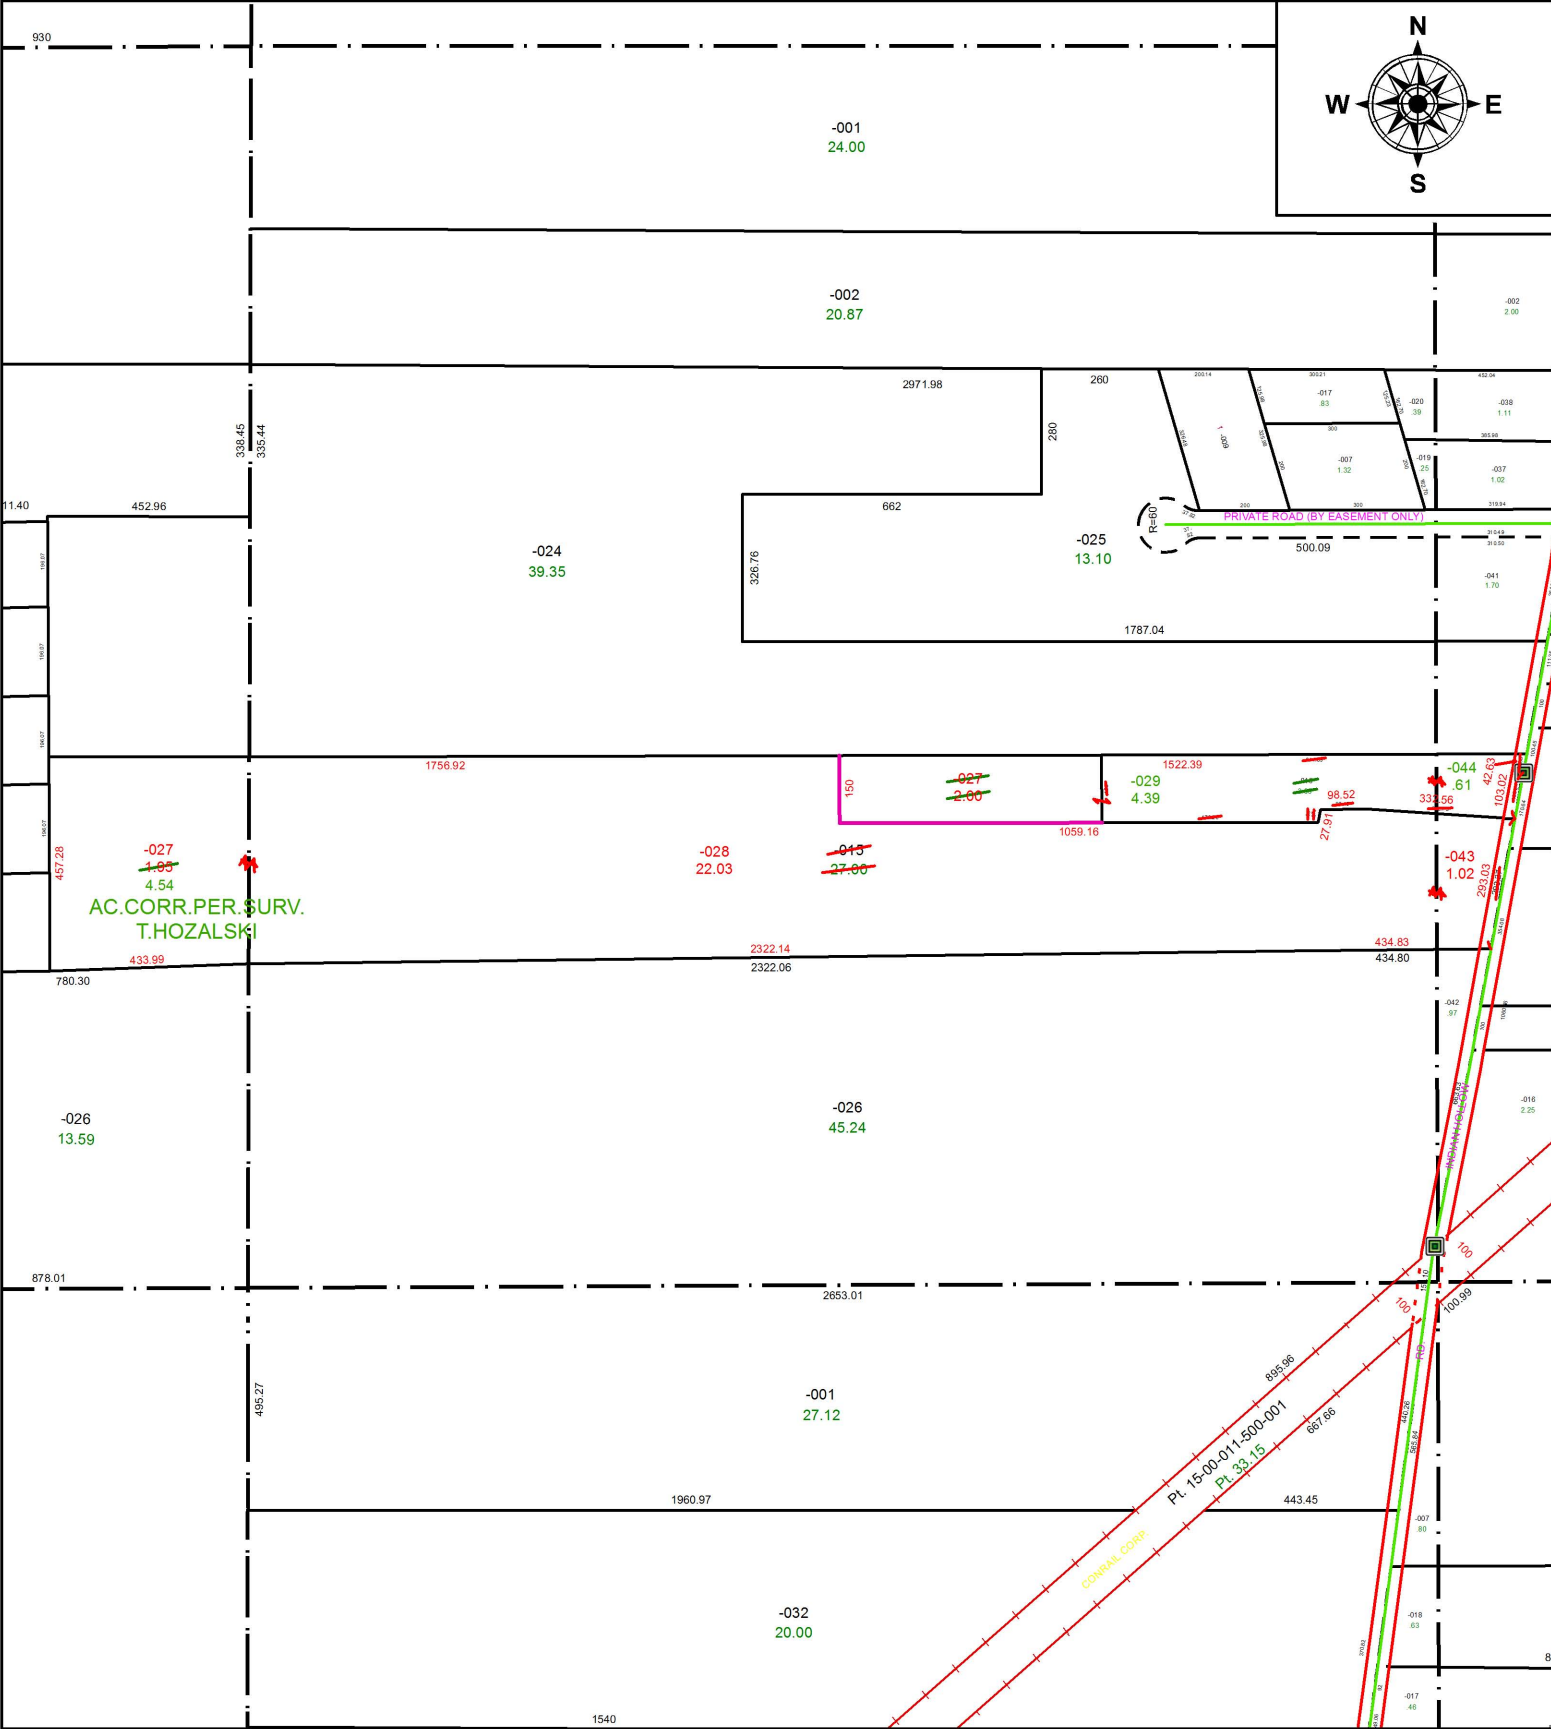

**SPLITS/DEEDS PROCESSED**  
 LORAIN COUNTY TAX MAP DEPARTMENT  
 226 MIDDLE AVE. ELYRIA, OH

**SURVEYED BY:** TIMOTHY D. HOZALSKI  
**CLOSURE:** 1:448,588  
**MAP PAGE(S):** 15-00-012  
**APPROVED BY:** RRM **DATE:** 3-3-20  
**SCALE:** 1" = 425 **PRIOR INSTRUMENT:** 20190734115