
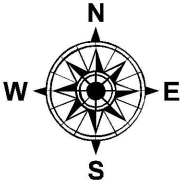


PARENT PARCEL: 05-00-021-103-097
 CHILD PARCEL: 05-00-021-103-177, -178
 STARTING POINT: INTERSECTION OF C/L OF COOPER FOSTER PARK RD. AND C/L OF KOLBE RD.

20-04099

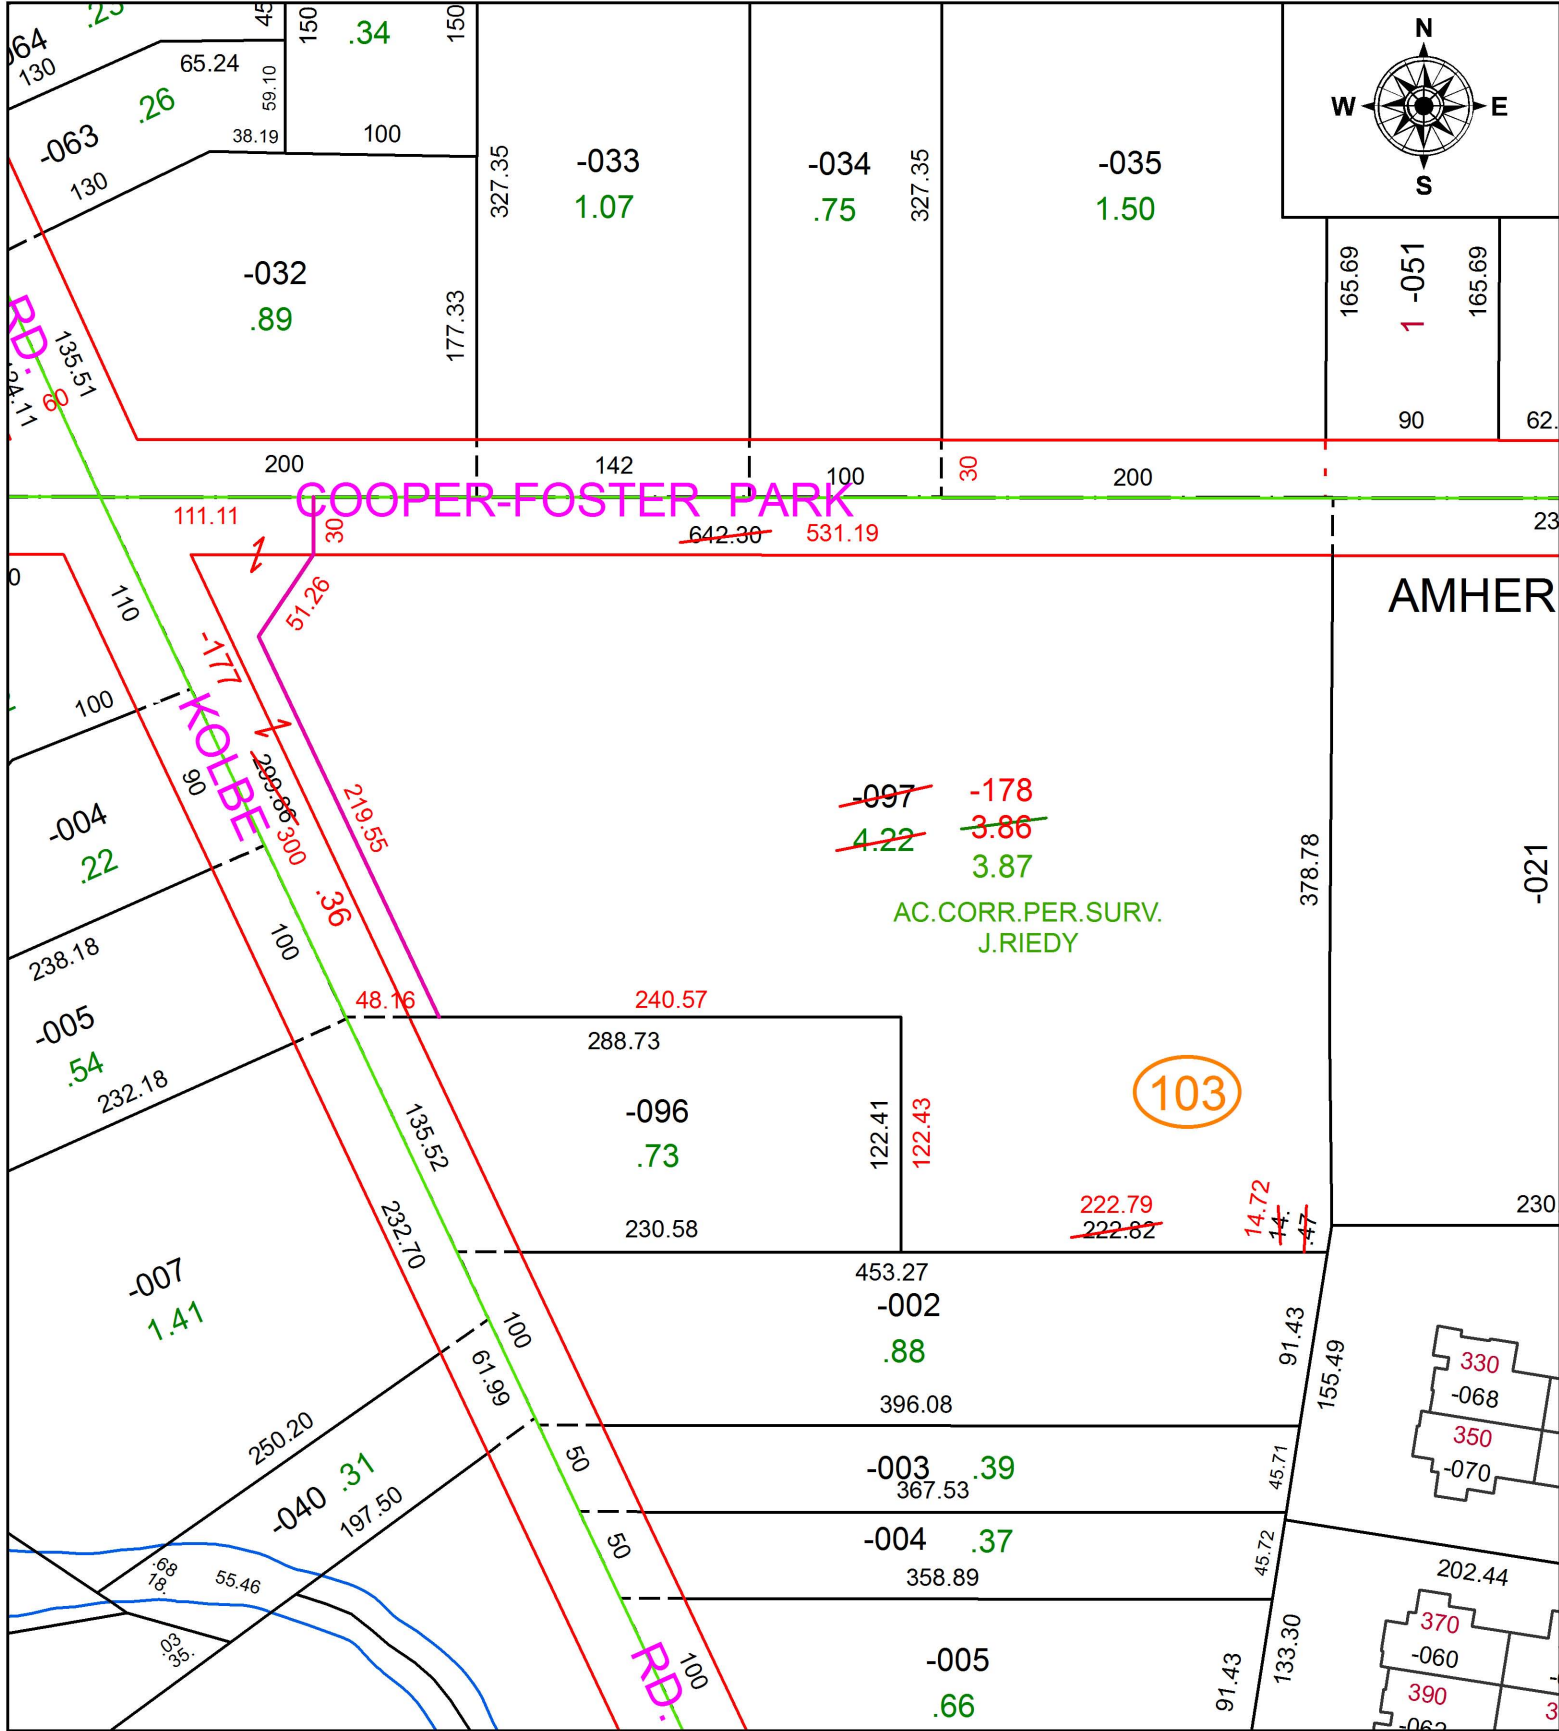


COOPER-FOSTER PARK

KOLBE RD.

KOLBE RD.

AC. CORR. PER. SURV. J. RIEDY

103

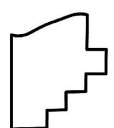

SPLITS/DEEDS PROCESSED
 LORAIN COUNTY TAX MAP DEPARTMENT
 226 MIDDLE AVE. ELYRIA, OH

SURVEYED BY: JOSHUA S. RIEDY
 CLOSURE: 1:94,856
 MAP PAGE(S): 5-00-021
 APPROVED BY: RRM DATE: 3-3-20
 SCALE: 1" = 100 PRIOR INSTRUMENT: 20190727436