
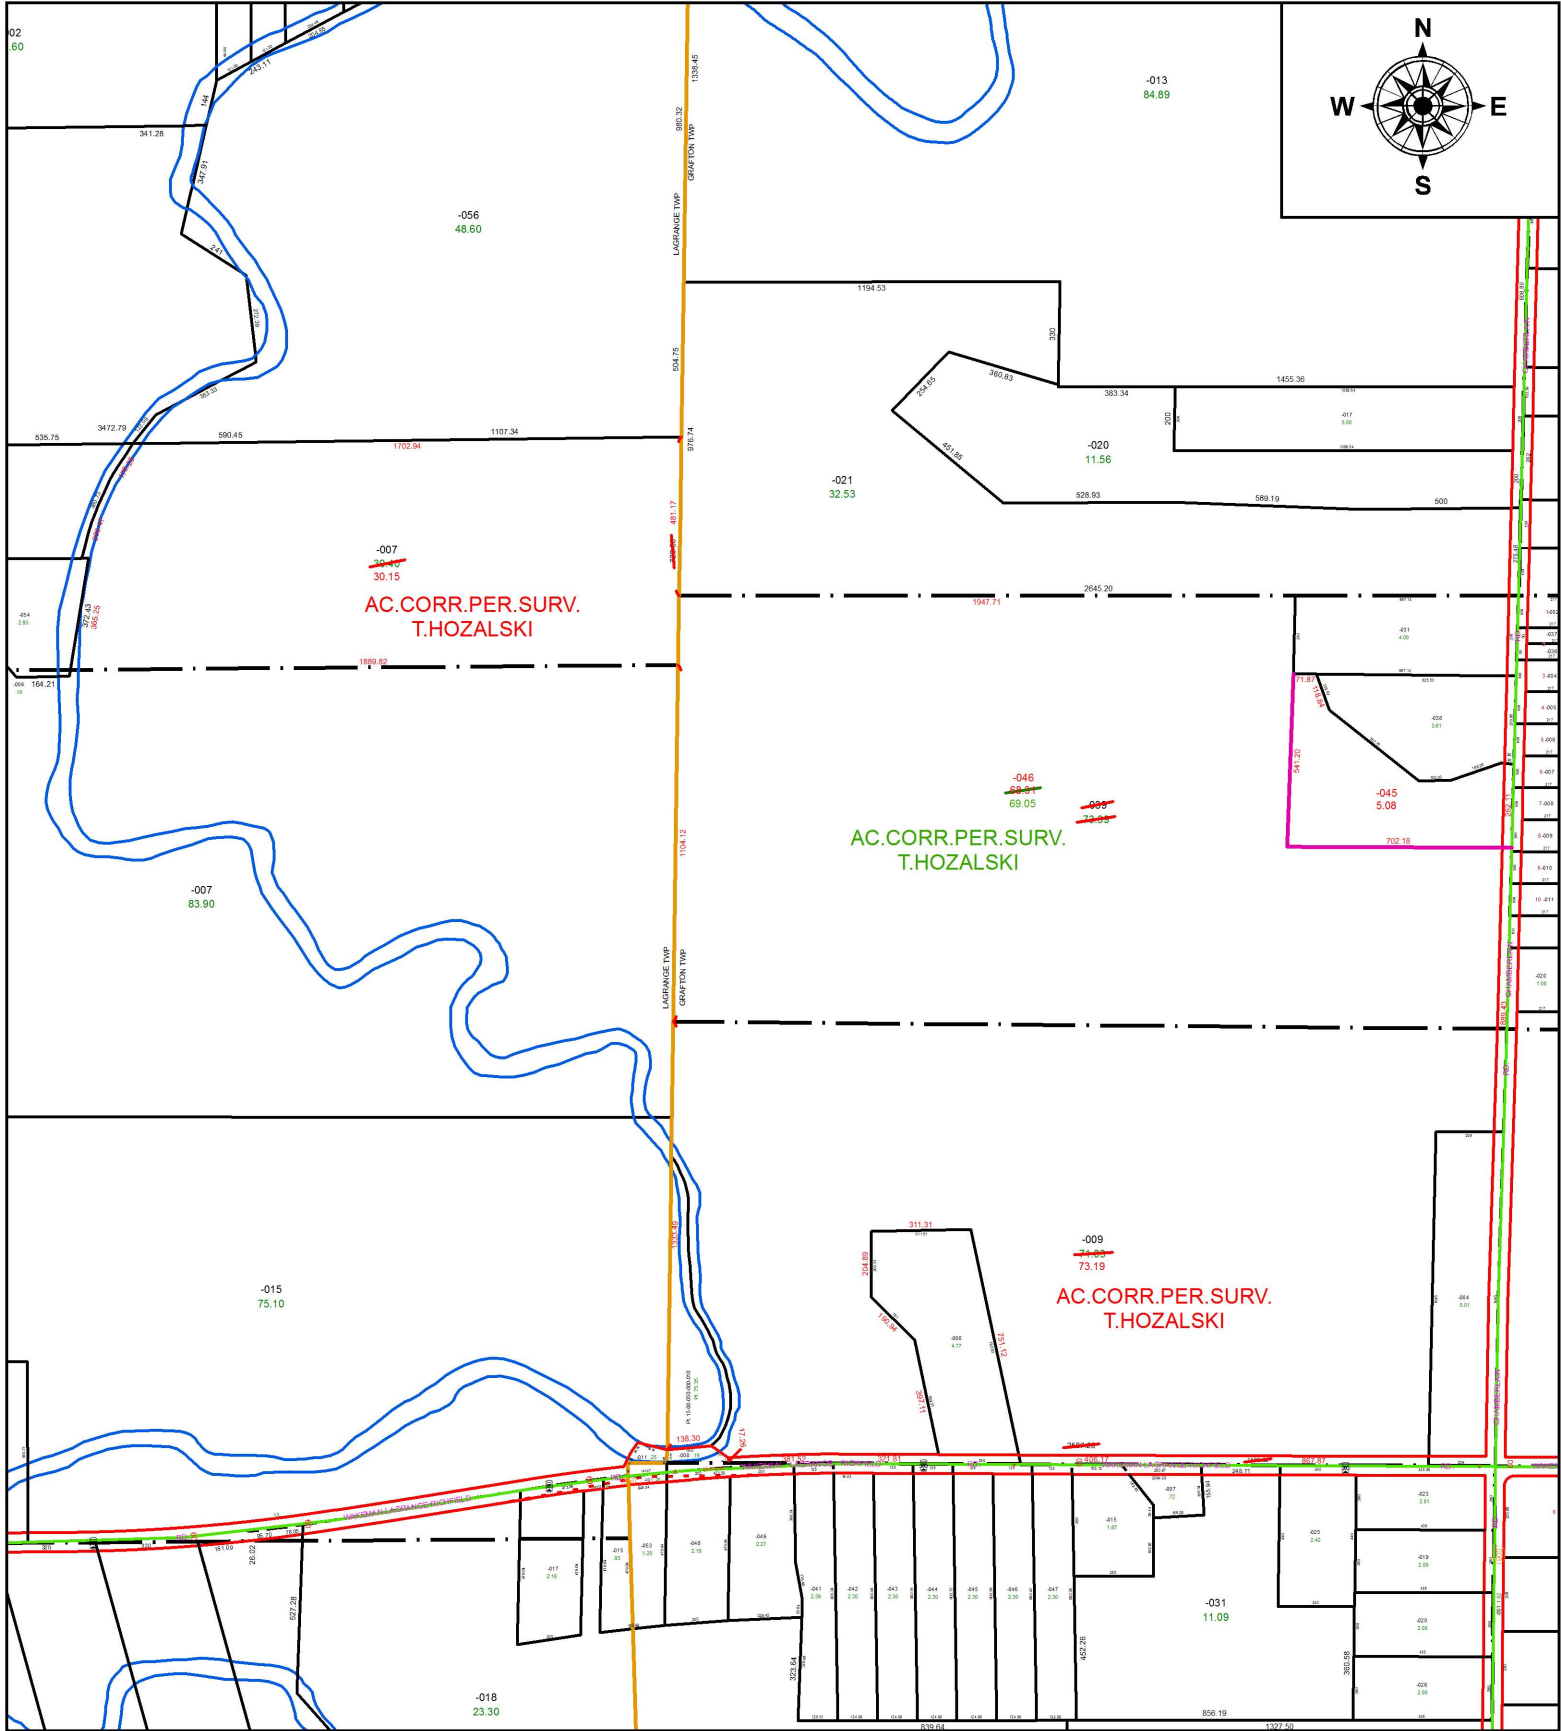


PARENT PARCEL: 15-00-031-000-007, 16-00-041-000-039, 16-00-042-000-009
CHILD PARCEL: 15-00-031-000-007, 16-00-041-000-045, -046, 16-00-042-000-009
STARTING POINT: NORTHEAST CORNER OF O.L.41

20-04107

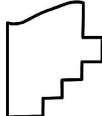

 **SPLITS/DEEDS PROCESSED**
LORAIN COUNTY TAX MAP DEPARTMENT
226 MIDDLE AVE. ELYRIA, OH

SURVEYED BY: TIMOTHY D. HOZALSKI
CLOSURE: 1:260,929
MAP PAGE(S): 16-00-041
APPROVED BY: RRM **DATE:** 3-24-20
SCALE: 1" = 600 **PRIOR INSTRUMENT:** 20180667112