




PARENT PARCEL: 12-00-004-000-002 & -043, 12-00-017-000-001, -005, -011, &

PARENT PARCEL: & 12-00-018-000-013

CHILD PARCEL: 12-00-017-000-013 & -014

STARTING POINT: NAIL SET, INT. CL OF SNELL RD. & CL OF BOONE RD.

20-04109

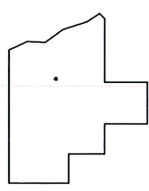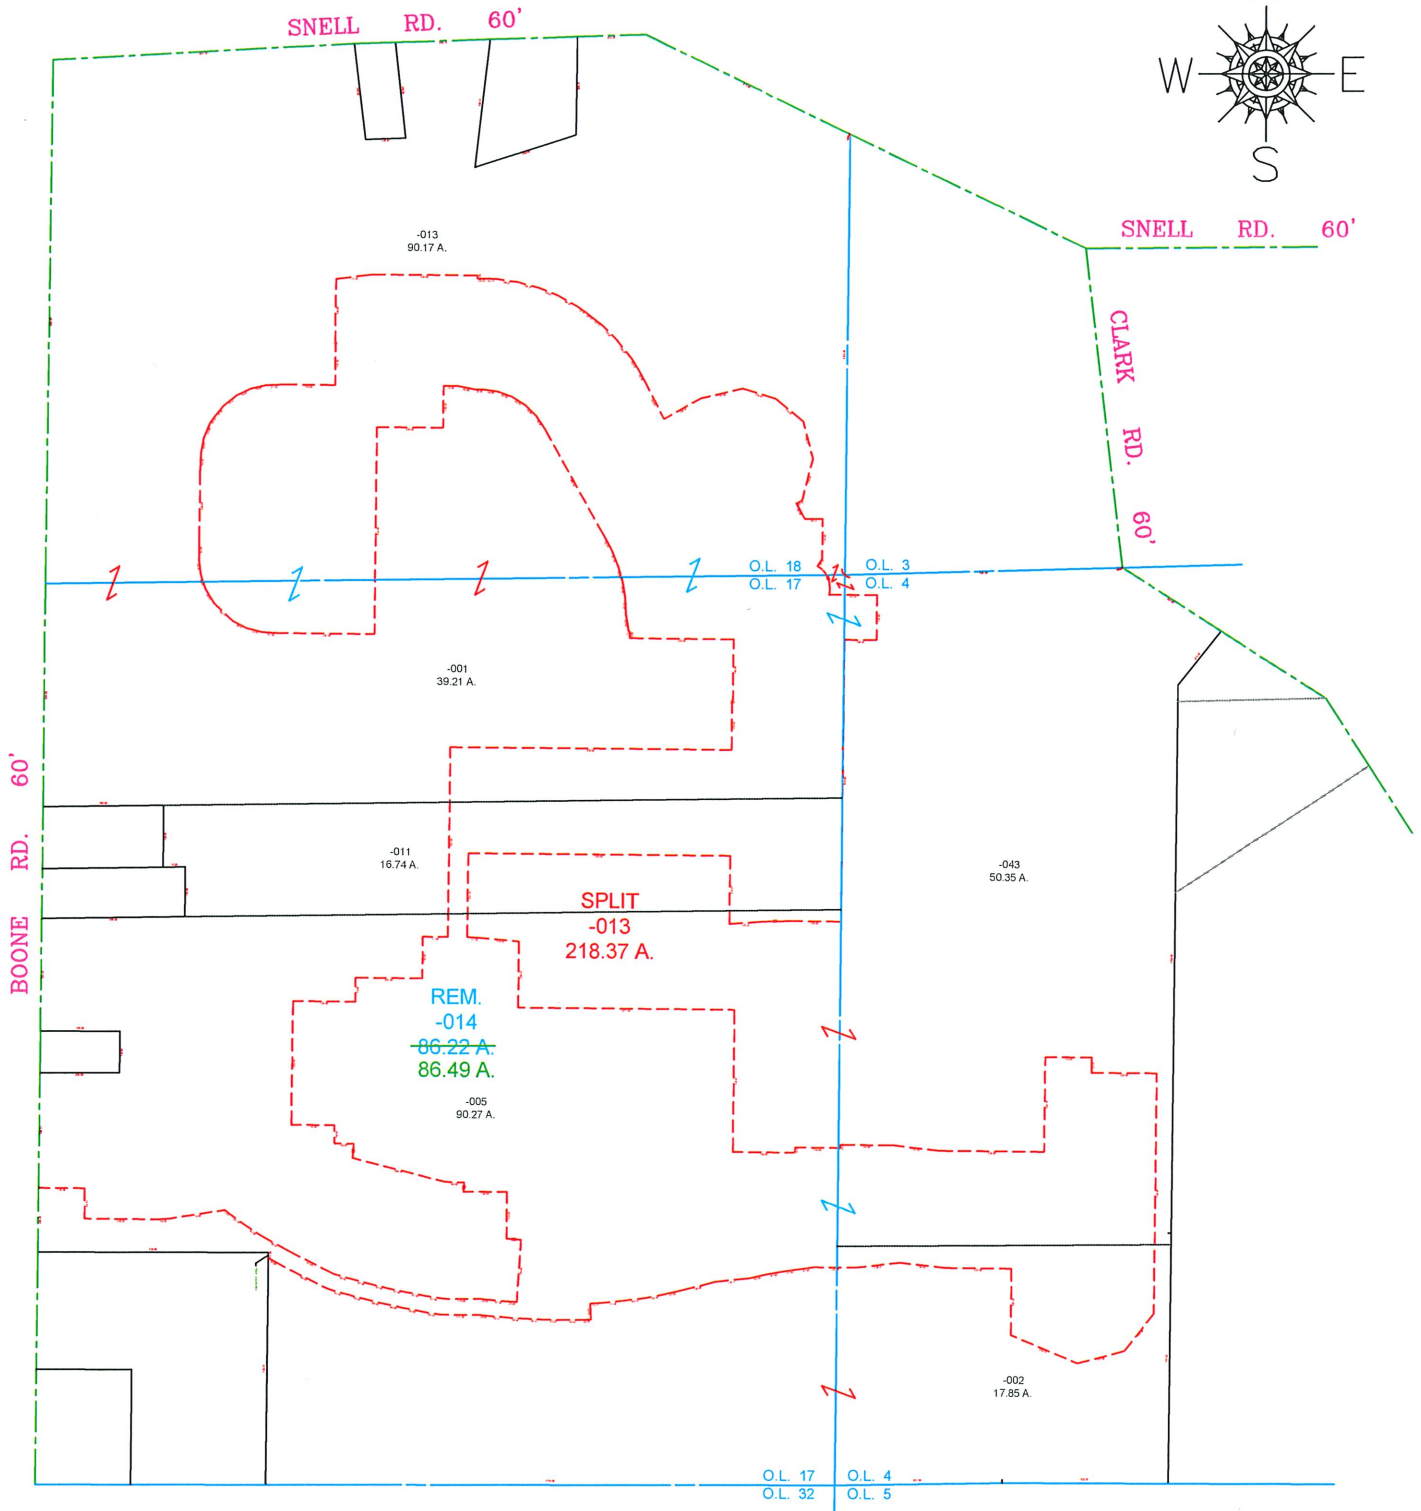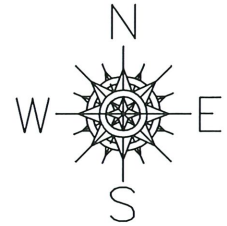

SPLITS/DEEDS PROCESSED

LORAIN COUNTY TAX MAP DEPARTMENT
226 MIDDLE AVE. ELYRIA, OHIO

SURVEYED BY: M. ACKERMAN

CLOSURE: 0.01 : 10,000

MAP PAGE(S): 12-00-004, -017, -018

APPROVED BY: TJS DATE: 3/24/2020

SCALE: 1" = 600' PRIOR INSTRUMENT: DV XXXX/XXX