
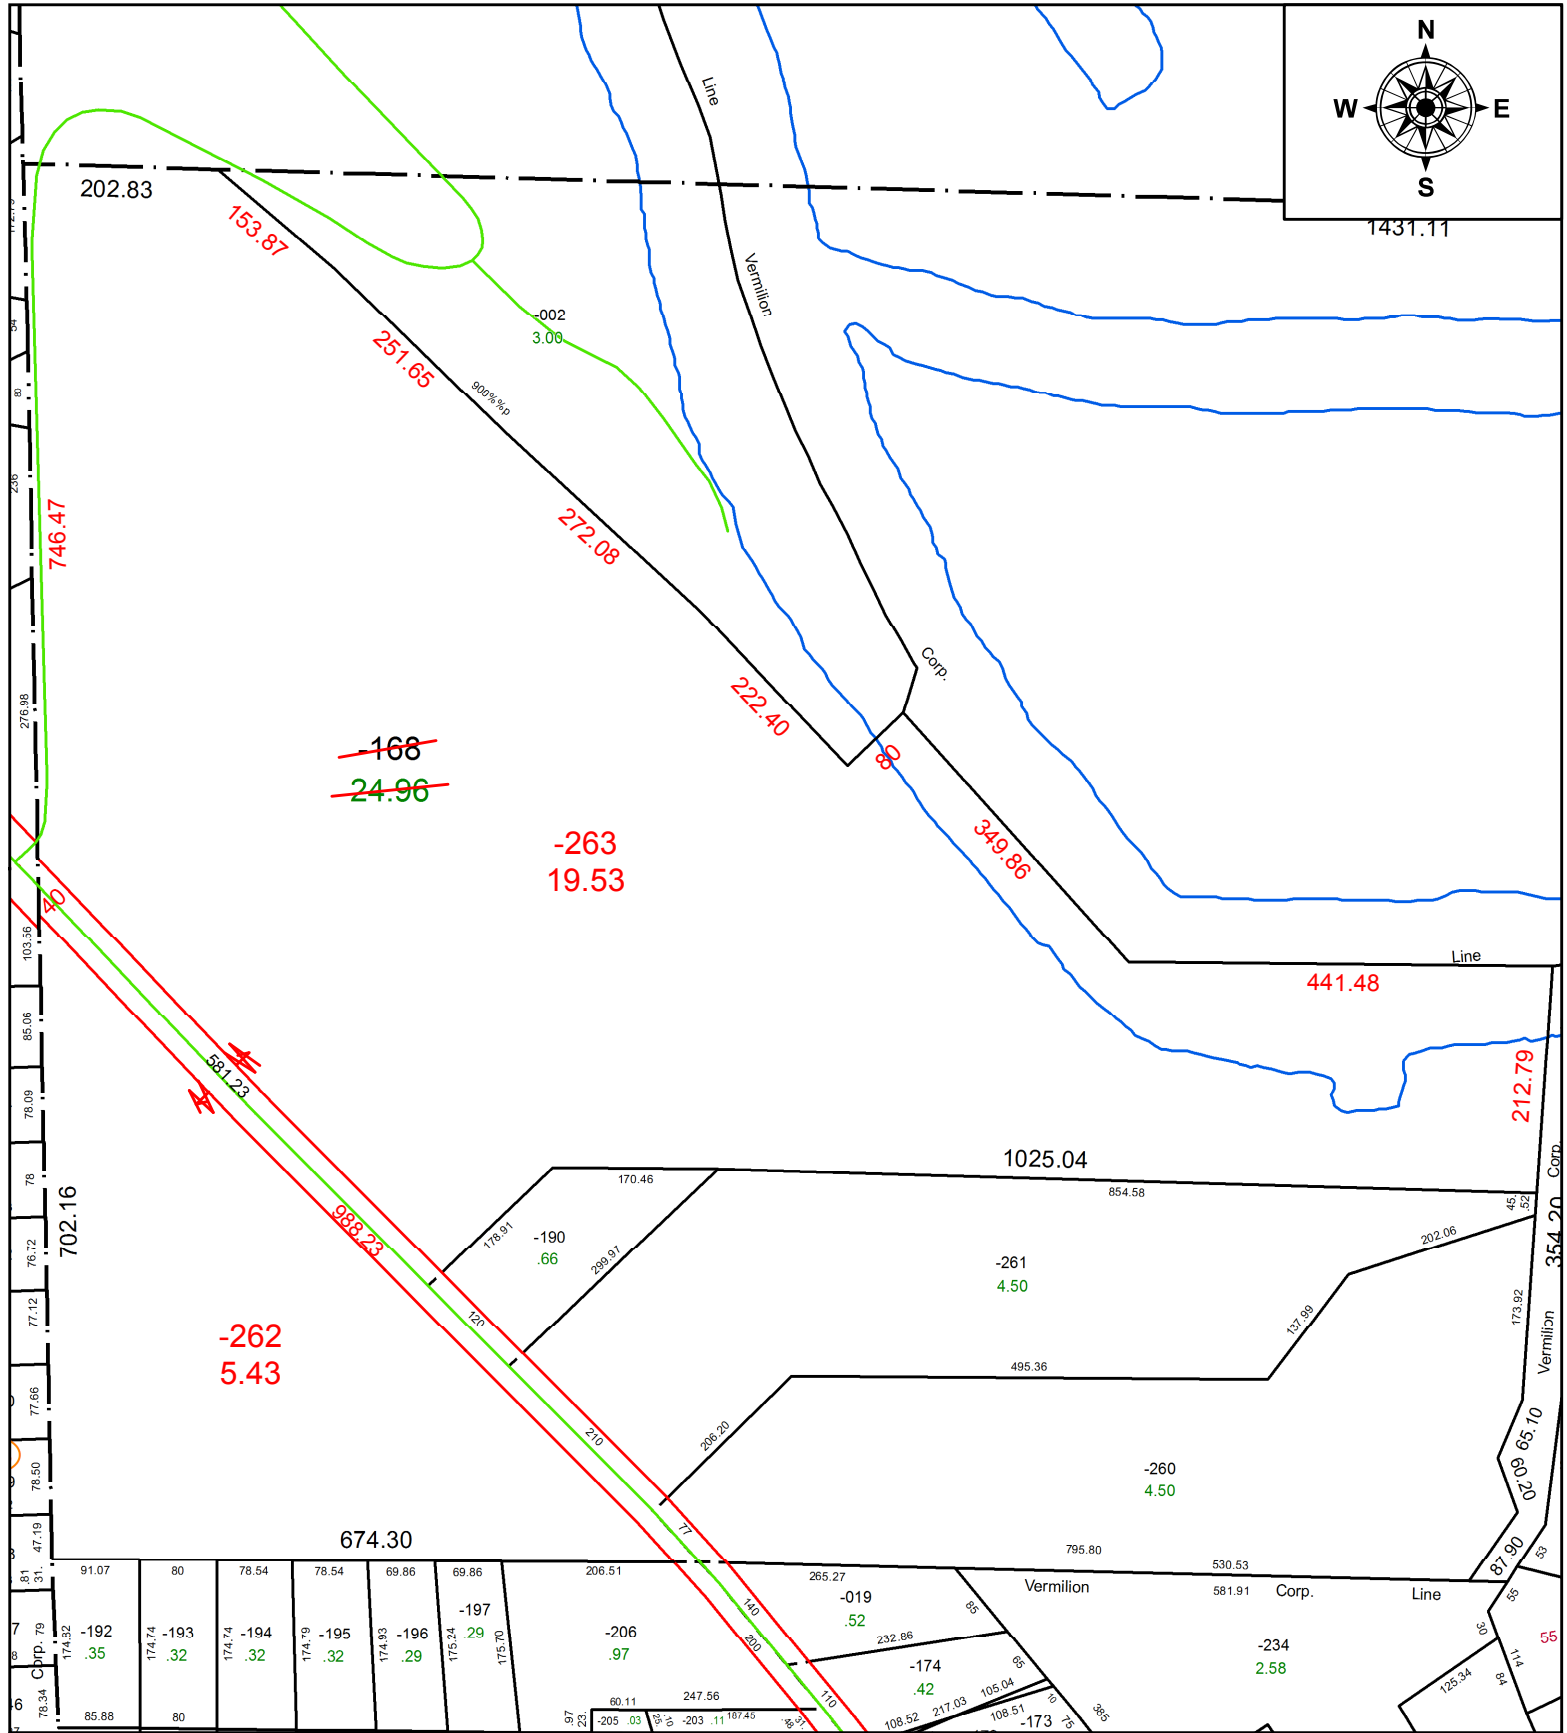


PARENT PARCEL: 01-00-017-000-168
 CHILD PARCEL: 01-00-017-000-262, -263
 STARTING POINT: INTERSECTION OF C/L OF WEST RIVER RD. AND EAST LINE OF O.L. 27 GORE STRIP

20-04112

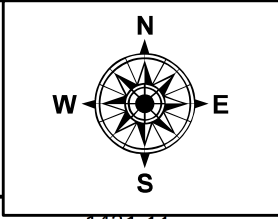

SPLITS/DEEDS PROCESSED
 LORAIN COUNTY TAX MAP DEPARTMENT
 226 MIDDLE AVE. ELYRIA, OH

SURVEYED BY: NORMAN R, HURA
 CLOSURE: 1:133,107
 MAP PAGE(S): 1-00-017
 APPROVED BY: RRM DATE: 4-2-20
 SCALE: 1" = 200 PRIOR INSTRUMENT: 20040006416