
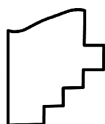


PARENT PARCEL: 05-00-097-104-006

CHILD PARCEL: 05-00-097-104-007, -008

STARTING POINT: SOUTHEAST CORNER OF O.L.97

20-04114

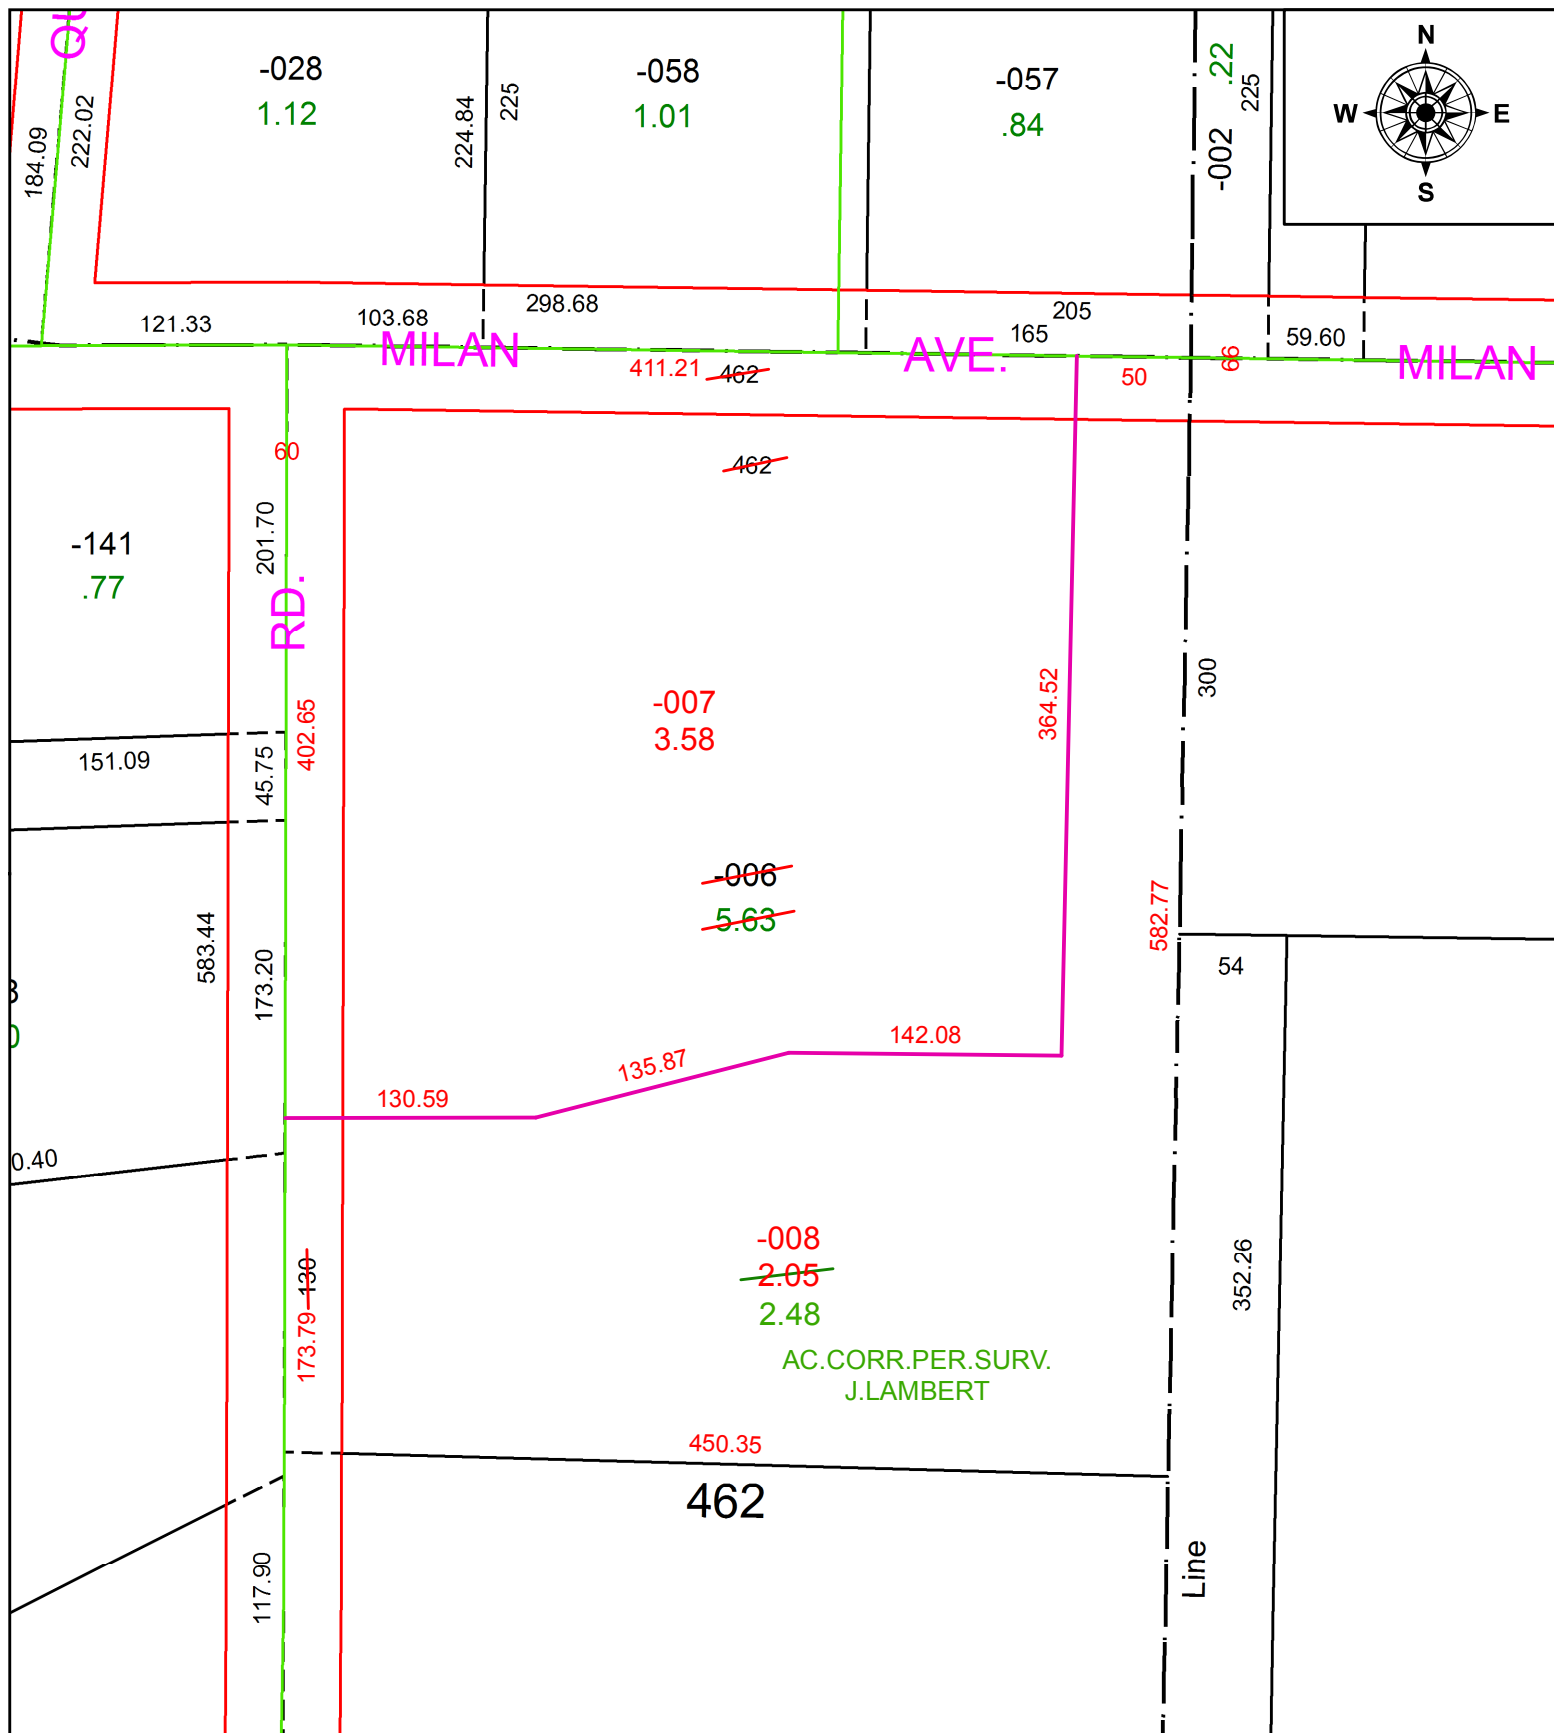

**SPLITS/DEEDS PROCESSED**  
 LORAIN COUNTY TAX MAP DEPARTMENT  
 226 MIDDLE AVE. ELYRIA, OH

SURVEYED BY: JOSHUA C. LAMBERT

CLOSURE: 1:436,431

MAP PAGE(S): 5-00-097

APPROVED BY: RRM DATE: 4-6-20

SCALE: 1" = 100 PRIOR INSTRUMENT: 20180670813