


PARENT PARCEL: 09-00-043-000-017

CHILD PARCEL:

STARTING POINT: INTERSECTION OF C/L OF PYLE SOUTH AMHERST RD. AND C/L OF GARFIELD RD.

19-04115-A

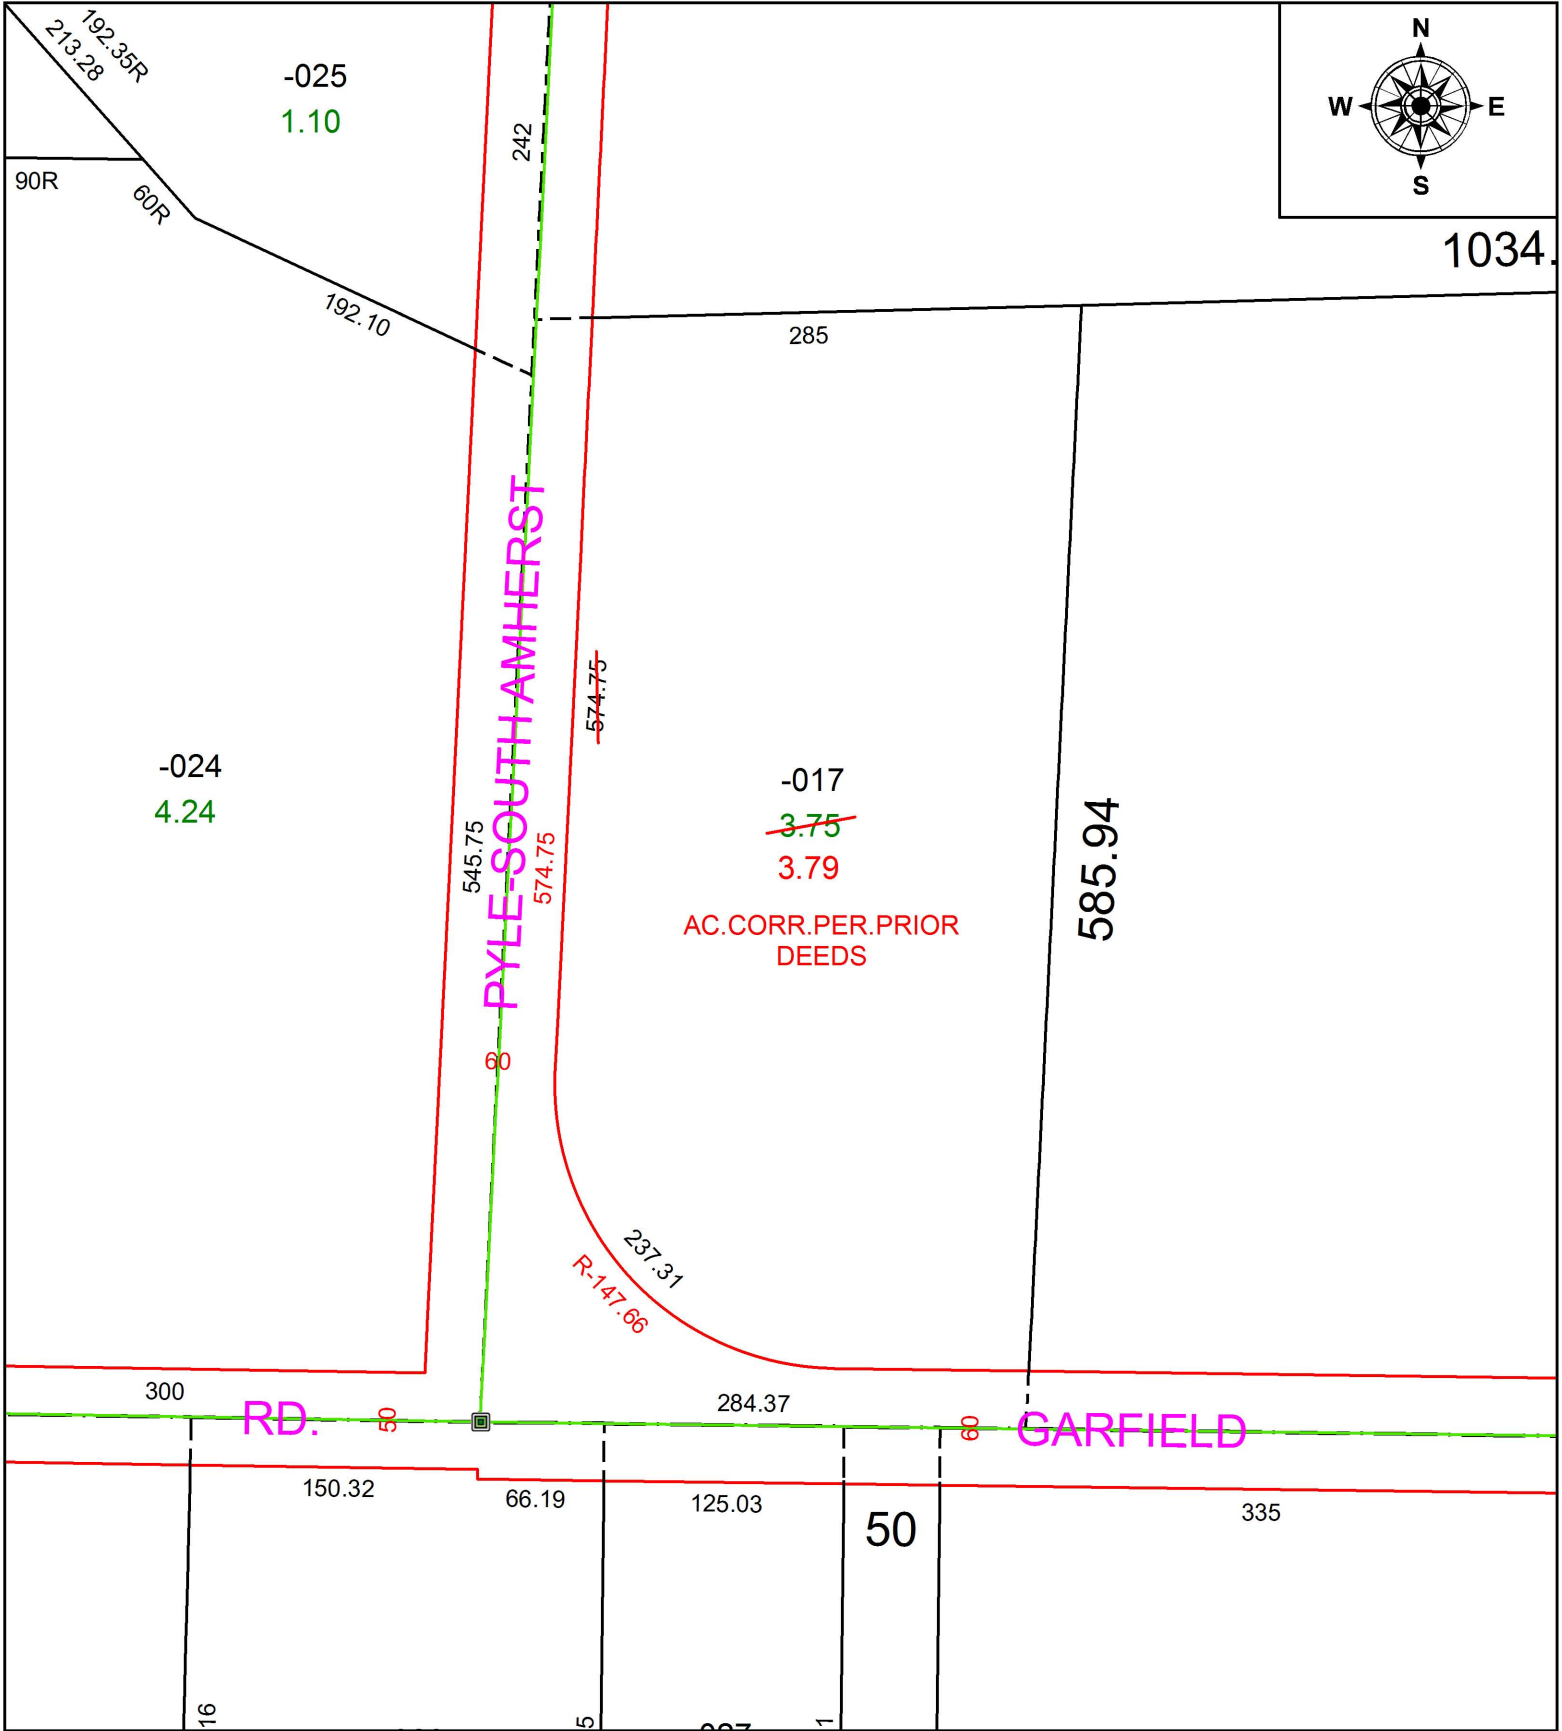

SPLITS/DEEDS PROCESSED
 LORAIN COUNTY TAX MAP DEPARTMENT
 226 MIDDLE AVE. ELYRIA, OH

SURVEYED BY: _____ N/A
 CLOSURE: 1:49,303
 MAP PAGE(S): 9-00-043
 APPROVED BY: RRM DATE: 6-11-19
 SCALE: 1" = 100 PRIOR INSTRUMENT: DV 1087/798