



PARENT PARCEL: 06-26-014-101-006

CHILD PARCEL:

STARTING POINT: SOUTHEAST CORNER OF S/L 18 IN A.D. HOWES ADDITION

19-04119-D

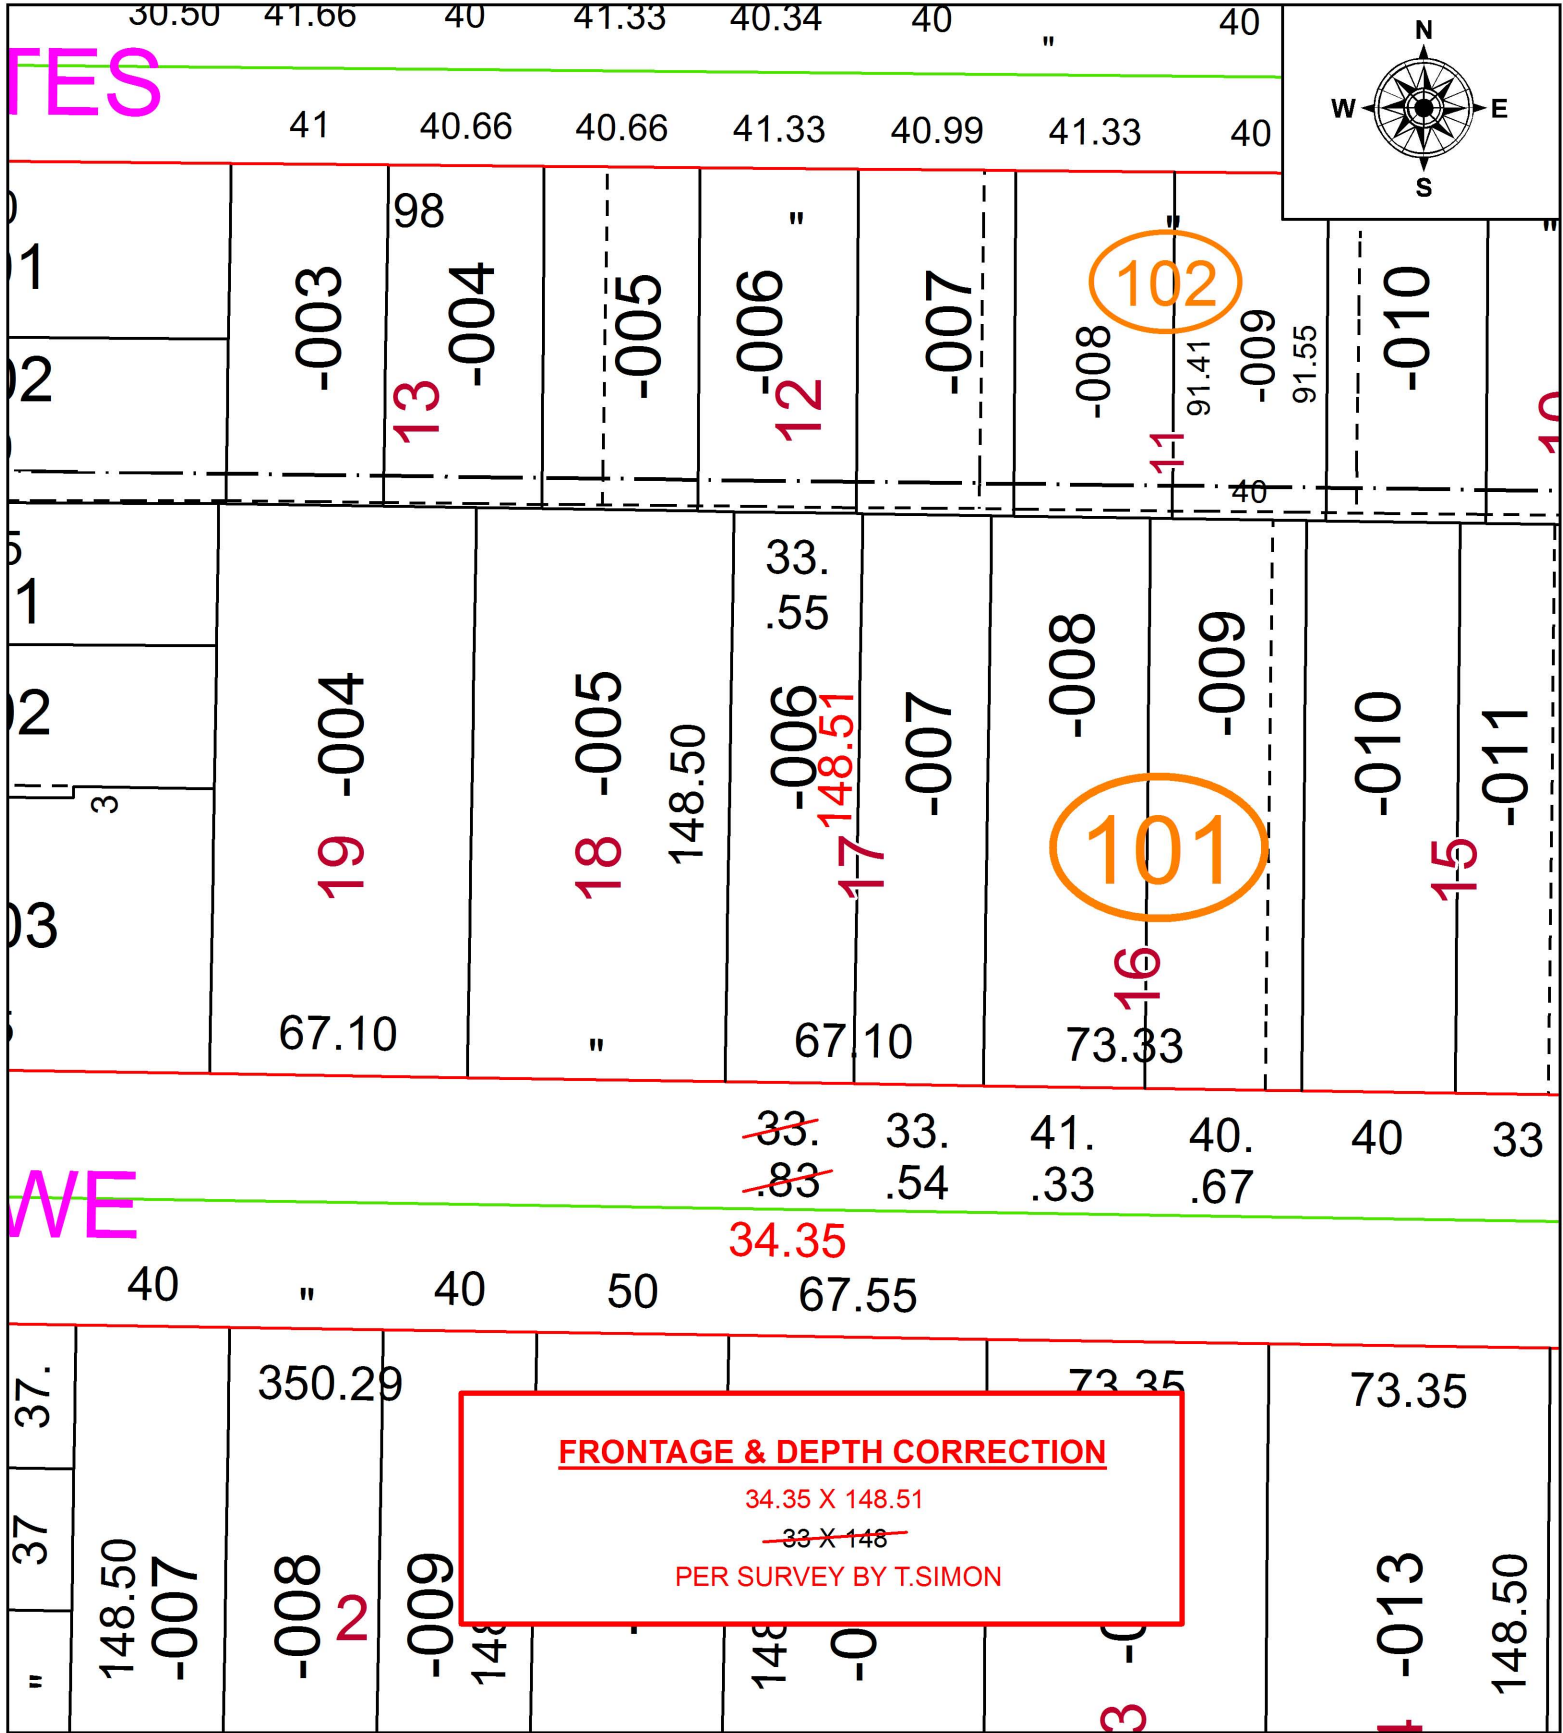

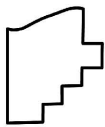 **SPLITS/DEEDS PROCESSED**
 LORAIN COUNTY TAX MAP DEPARTMENT
 226 MIDDLE AVE. ELYRIA, OH

SURVEYED BY: THOMAS A. SIMON
 CLOSURE: 1:95,220
 MAP PAGE(S): 6-26-014
 APPROVED BY: RRM DATE: 6-19-19
 SCALE: 1" = 50 PRIOR INSTRUMENT: 20180679834