
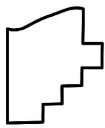


PARENT PARCEL: 06-25-022-108-057, -060, -061

CHILD PARCEL: 06-25-022-108-063

19-04122-C

STARTING POINT: NORTHEAST CORNER OF S/L 3 BLK 62 IN CITY FARMS ALLOTMENT

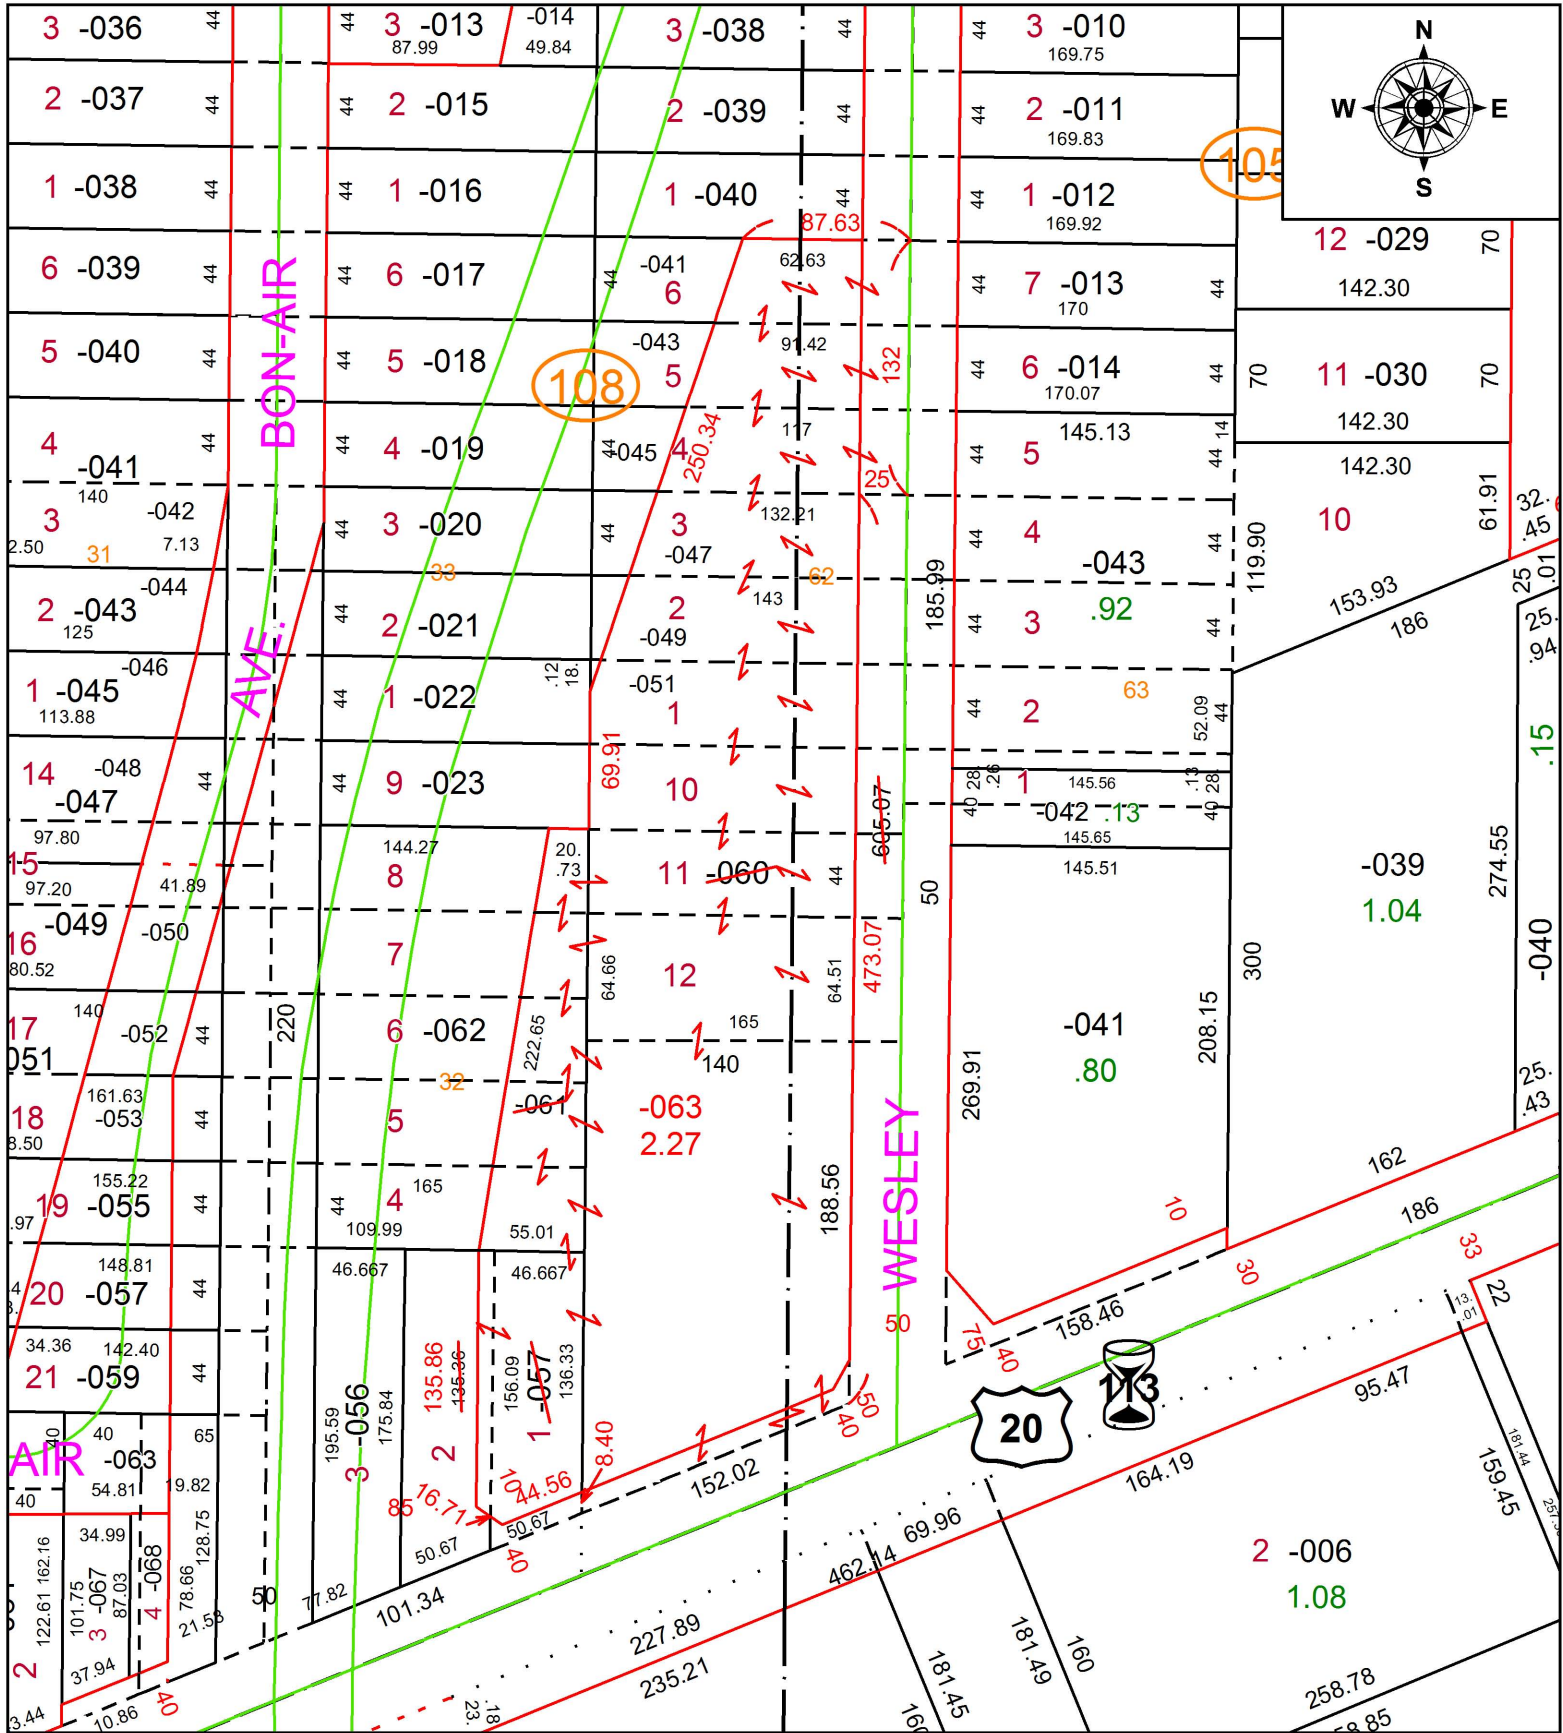

SPLITS/DEEDS PROCESSED
 LORAIN COUNTY TAX MAP DEPARTMENT
 226 MIDDLE AVE. ELYRIA, OH

SURVEYED BY: EDWARD E. NORTHROP

CLOSURE: 1:207,282

MAP PAGE(S): 6-25-022

APPROVED BY: RRM DATE: 6-21-19

SCALE: 1" = 100 PRIOR INSTRUMENT: OR 1377/615