
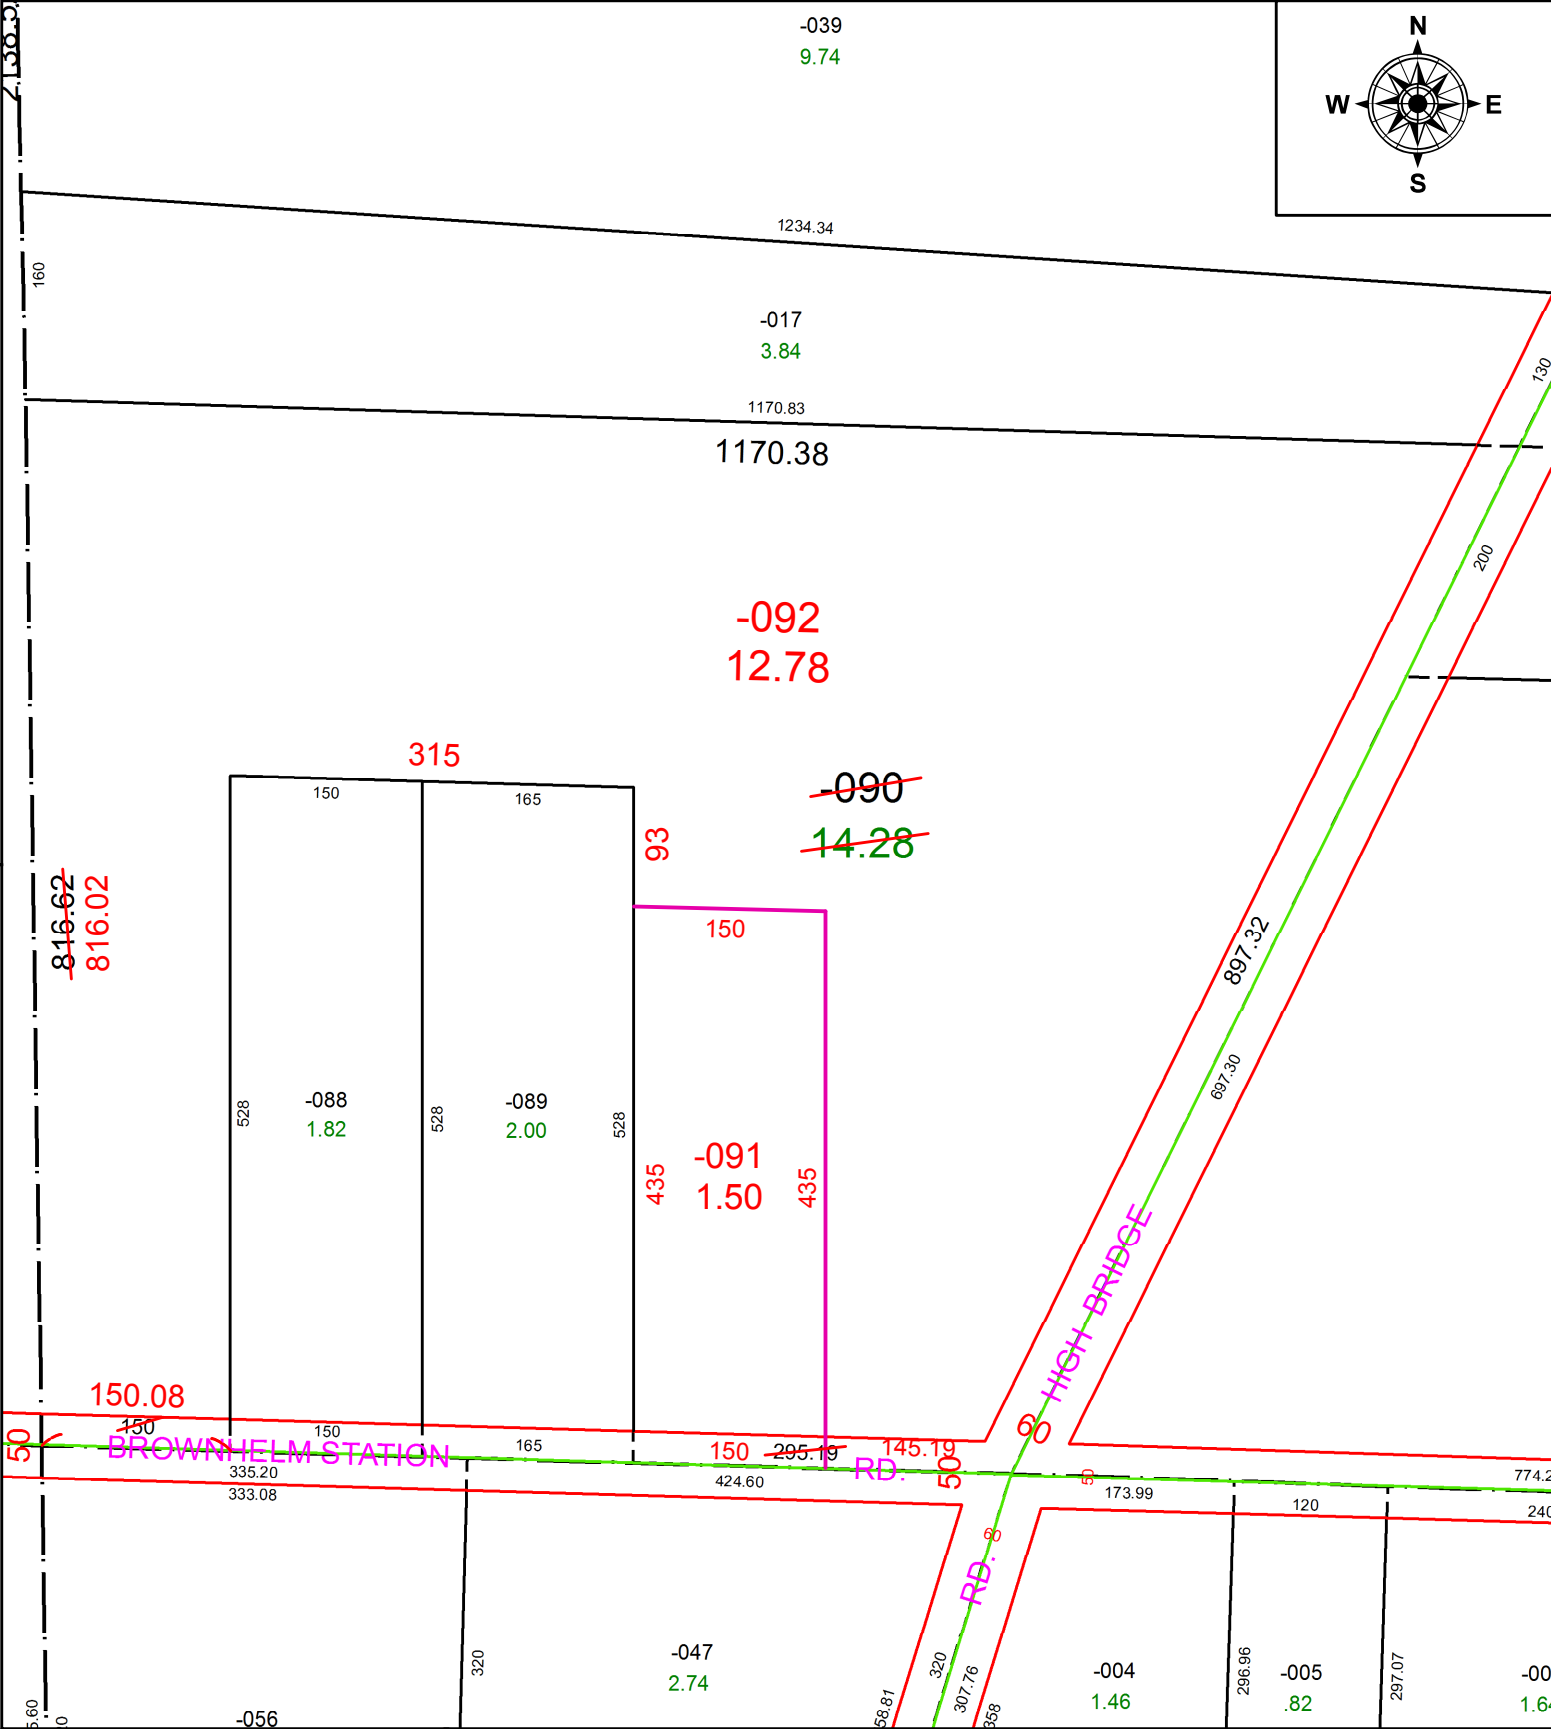



PARENT PARCEL: 01-00-015-000-090

CHILD PARCEL: 01-00-015-000-091, -092

STARTING POINT: SOUTHWEST CORNER OF O.L.15

20-04123

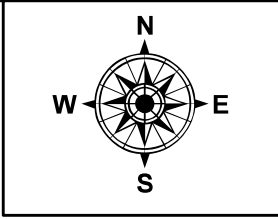

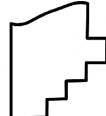 **SPLITS/DEEDS PROCESSED**
LORAIN COUNTY TAX MAP DEPARTMENT
226 MIDDLE AVE. ELYRIA, OH

SURVEYED BY: ALEX E. MARKS
CLOSURE: 1:978,664
MAP PAGE(S): 1-00-015
APPROVED BY: RRM **DATE:** 5-18-20
SCALE: 1" = 150 **PRIOR INSTRUMENT:** 20140530248