
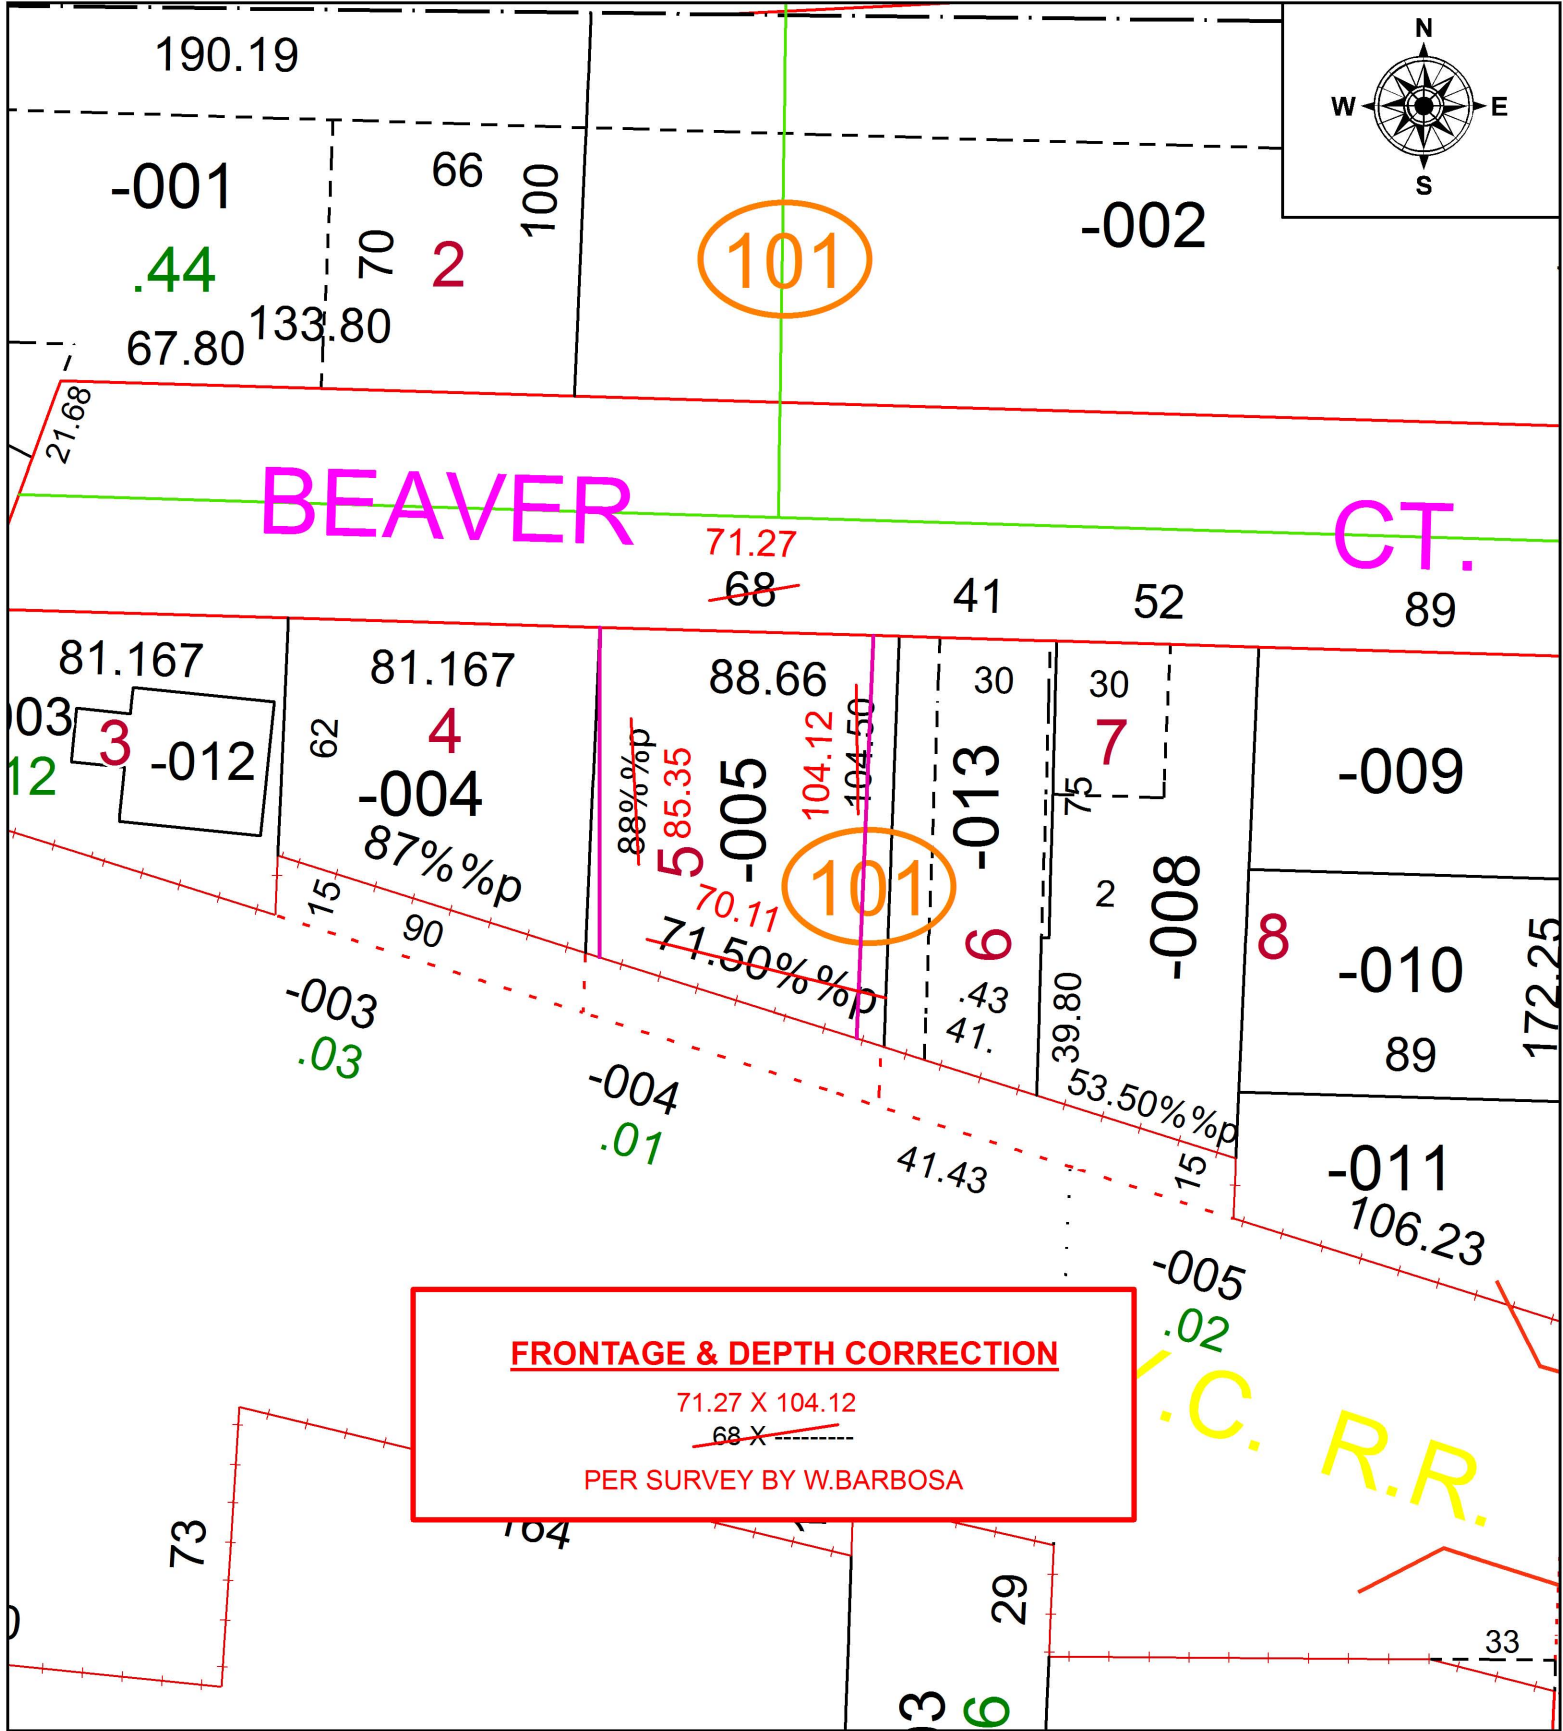


PARENT PARCEL: 05-00-024-101-005

CHILD PARCEL:

STARTING POINT: NORTHWEST CORNER OF S/L 5 IN VILLAGE PLAT OF AMHERST

19-04130-C

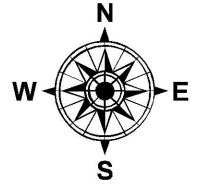

FRONTAGE & DEPTH CORRECTION
 71.27 X 104.12
~~68 X 104.12~~
 PER SURVEY BY W.BARBOSA



SPLITS/DEEDS PROCESSED
 LORAIN COUNTY TAX MAP DEPARTMENT
 226 MIDDLE AVE. ELYRIA, OH

SURVEYED BY: WILFREDO BARBOSA
 CLOSURE: 1:37,588
 MAP PAGE(S): 5-00-024
 APPROVED BY: RRM DATE: 7-1-19
 SCALE: 1" = 50' PRIOR INSTRUMENT: 20190716104