
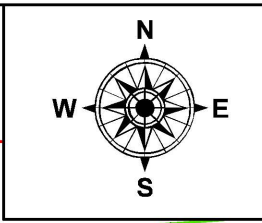


PARENT PARCEL: 04-00-018-141-003, -004, -005

CHILD PARCEL: 04-00-018-141-014

STARTING POINT: INTERSECTION OF C/L OF AVON CENTER RD. AND SOUTH LINE OF LAKE SHORE ELECTRIC RAILWAY


19-04136-C

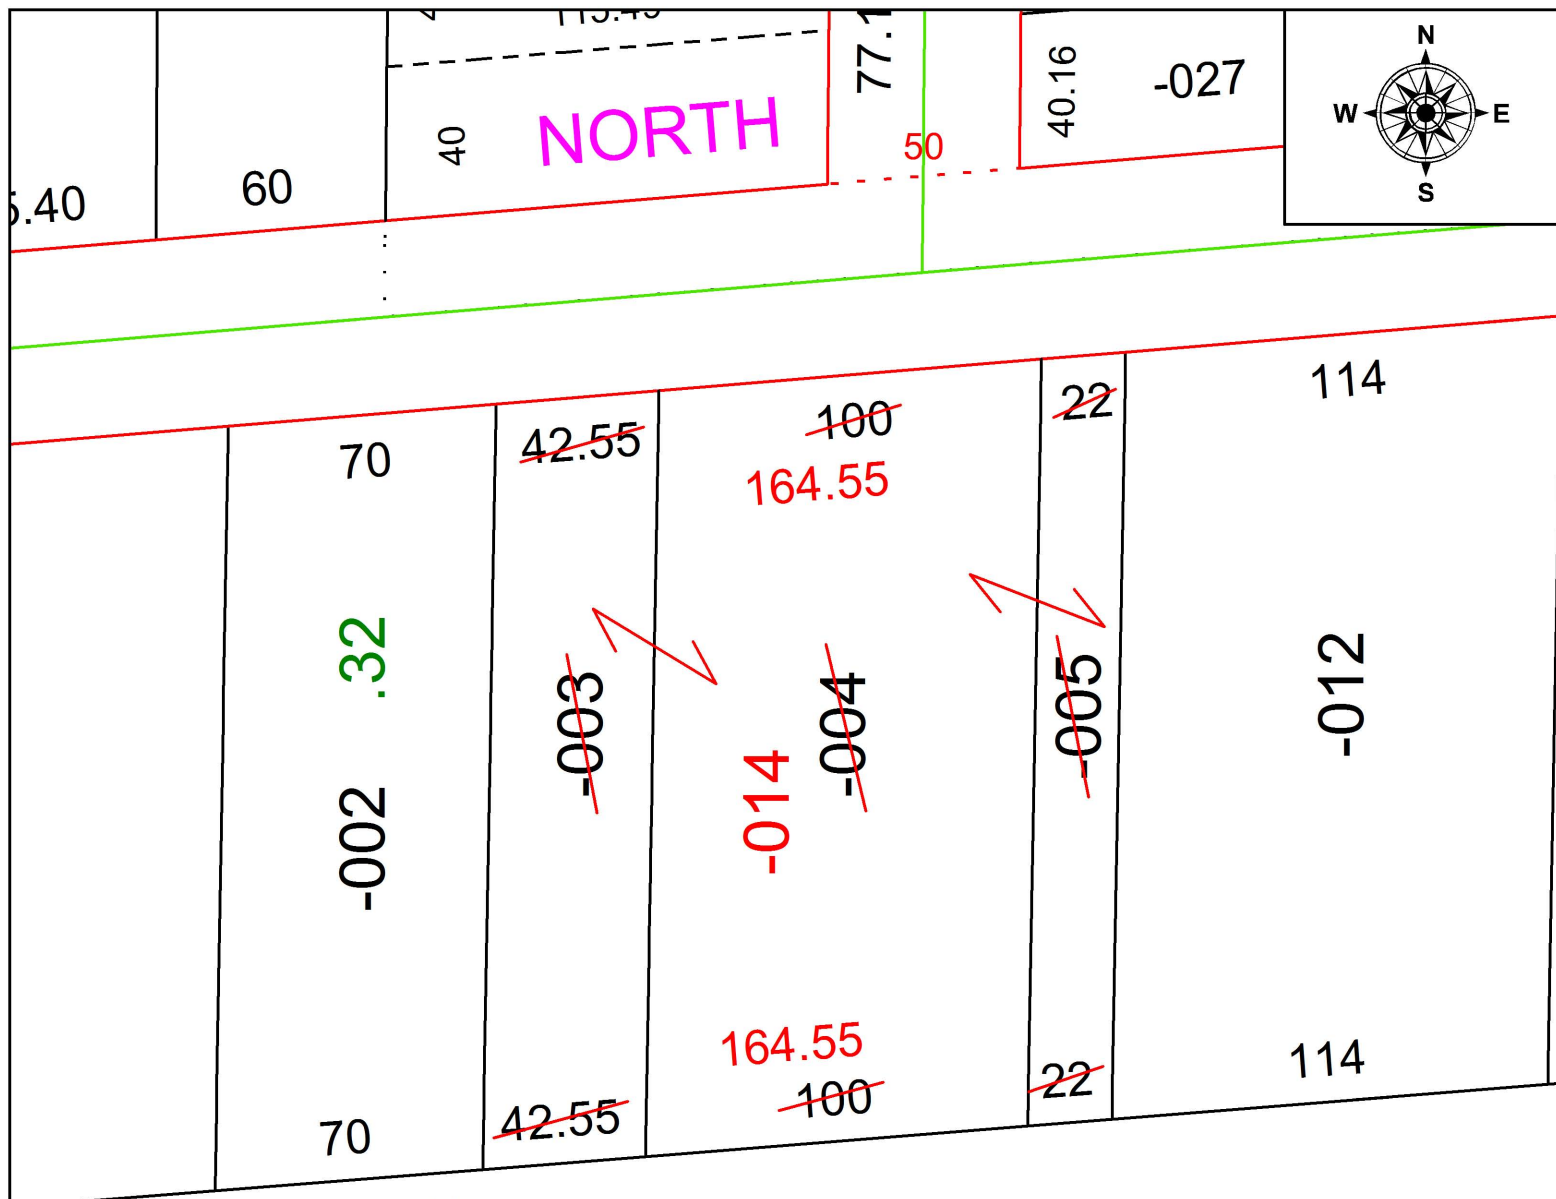

**COMBINATION**

~~04-00-018-141-003~~ ~~04-00-018-141-004~~ ~~04-00-018-141-005~~  
~~42.50 X 200~~      ~~100 X 200~~      ~~22 X 200~~

04-00-018-141-014  
164.55 X 200

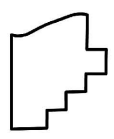

**SPLITS/DEEDS PROCESSED**  
LORAIN COUNTY TAX MAP DEPARTMENT  
226 MIDDLE AVE. ELYRIA, OH

SURVEYED BY: \_\_\_\_\_ N/A  
CLOSURE: 1:2147483648  
MAP PAGE(S): 4-00-018  
APPROVED BY: RRM DATE: 7-8-19  
SCALE: 1" = 50' PRIOR INSTRUMENT: N/A