


PARENT PARCEL: 01-00-075-000-023, -024, -036

CHILD PARCEL: 01-00-075-000-041 THRU -043

STARTING POINT: INTERSECTION OF C/L OF GIFFORD RD. AND SOUTH LINE OF O.L.75


20-04139

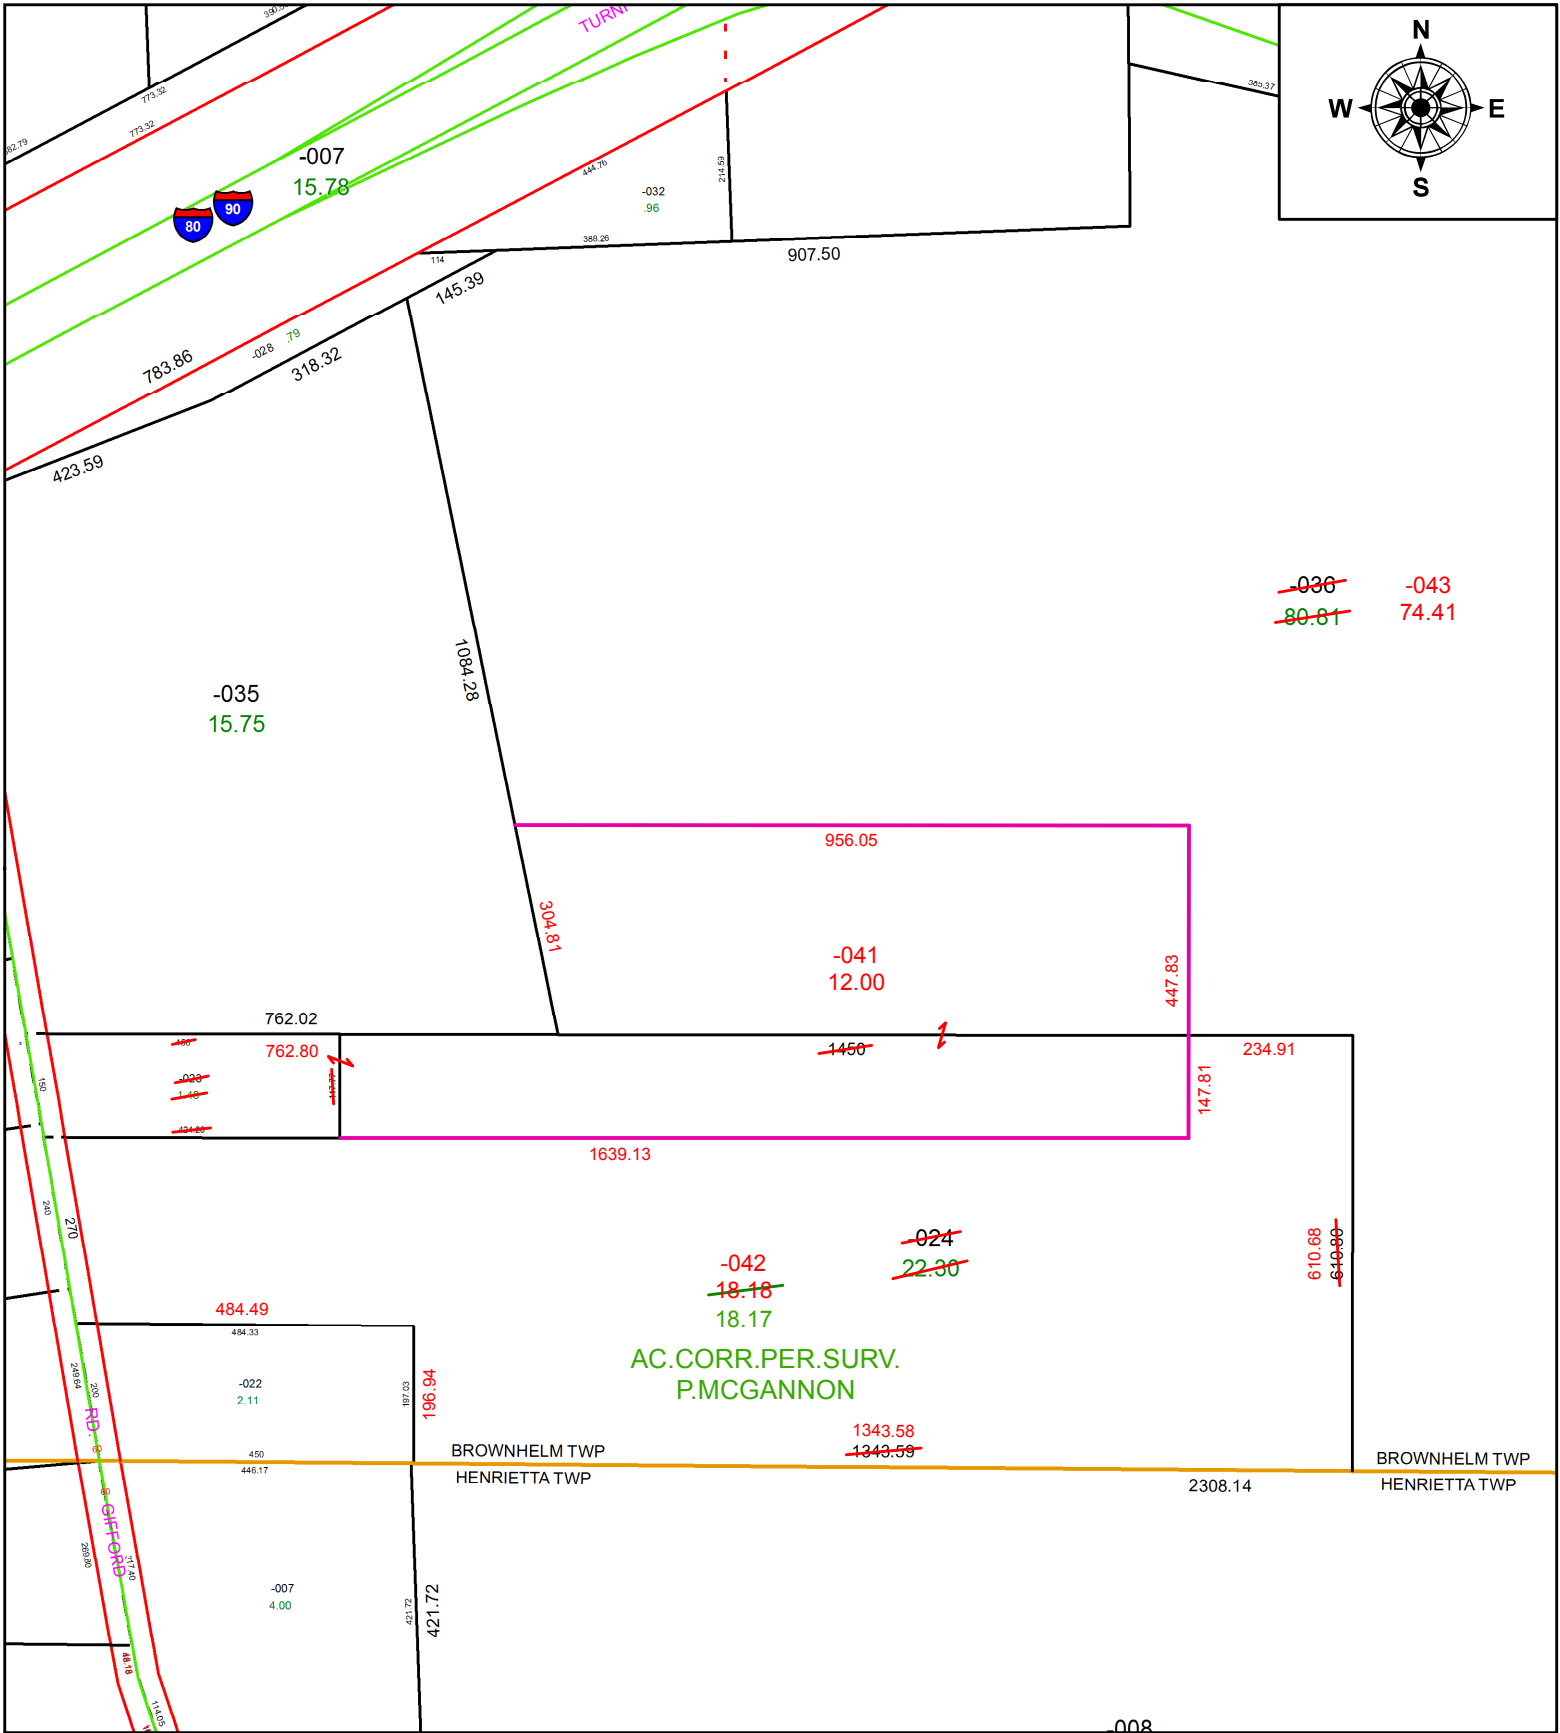

AC. CORR. PER. SURV.  
P. MCGANNON

BROWNHELM TWP  
HENRIETTA TWP

BROWNHELM TWP  
HENRIETTA TWP

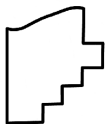

**SPLITS/DEEDS PROCESSED**  
LORAIN COUNTY TAX MAP DEPARTMENT  
226 MIDDLE AVE. ELYRIA, OH

SURVEYED BY: PATRICK A. MCGANNON

CLOSURE: 1:195,338

MAP PAGE(S): 1-00-075

APPROVED BY: RRM DATE: 6-19-20

SCALE: 1" = 275 PRIOR INSTRUMENT: 19980514640