


PARENT PARCEL: 04-00-003-103-047, 04-00-010-114-051

CHILD PARCEL: 04-00-003-103-079 THRU -082, 04-00-010-114-053 THRU -056

STARTING POINT: INTERSECTION OF SOUTH LINE OF SEC. 3 AND WEST LINE OF N. LONG RD.

20-04141

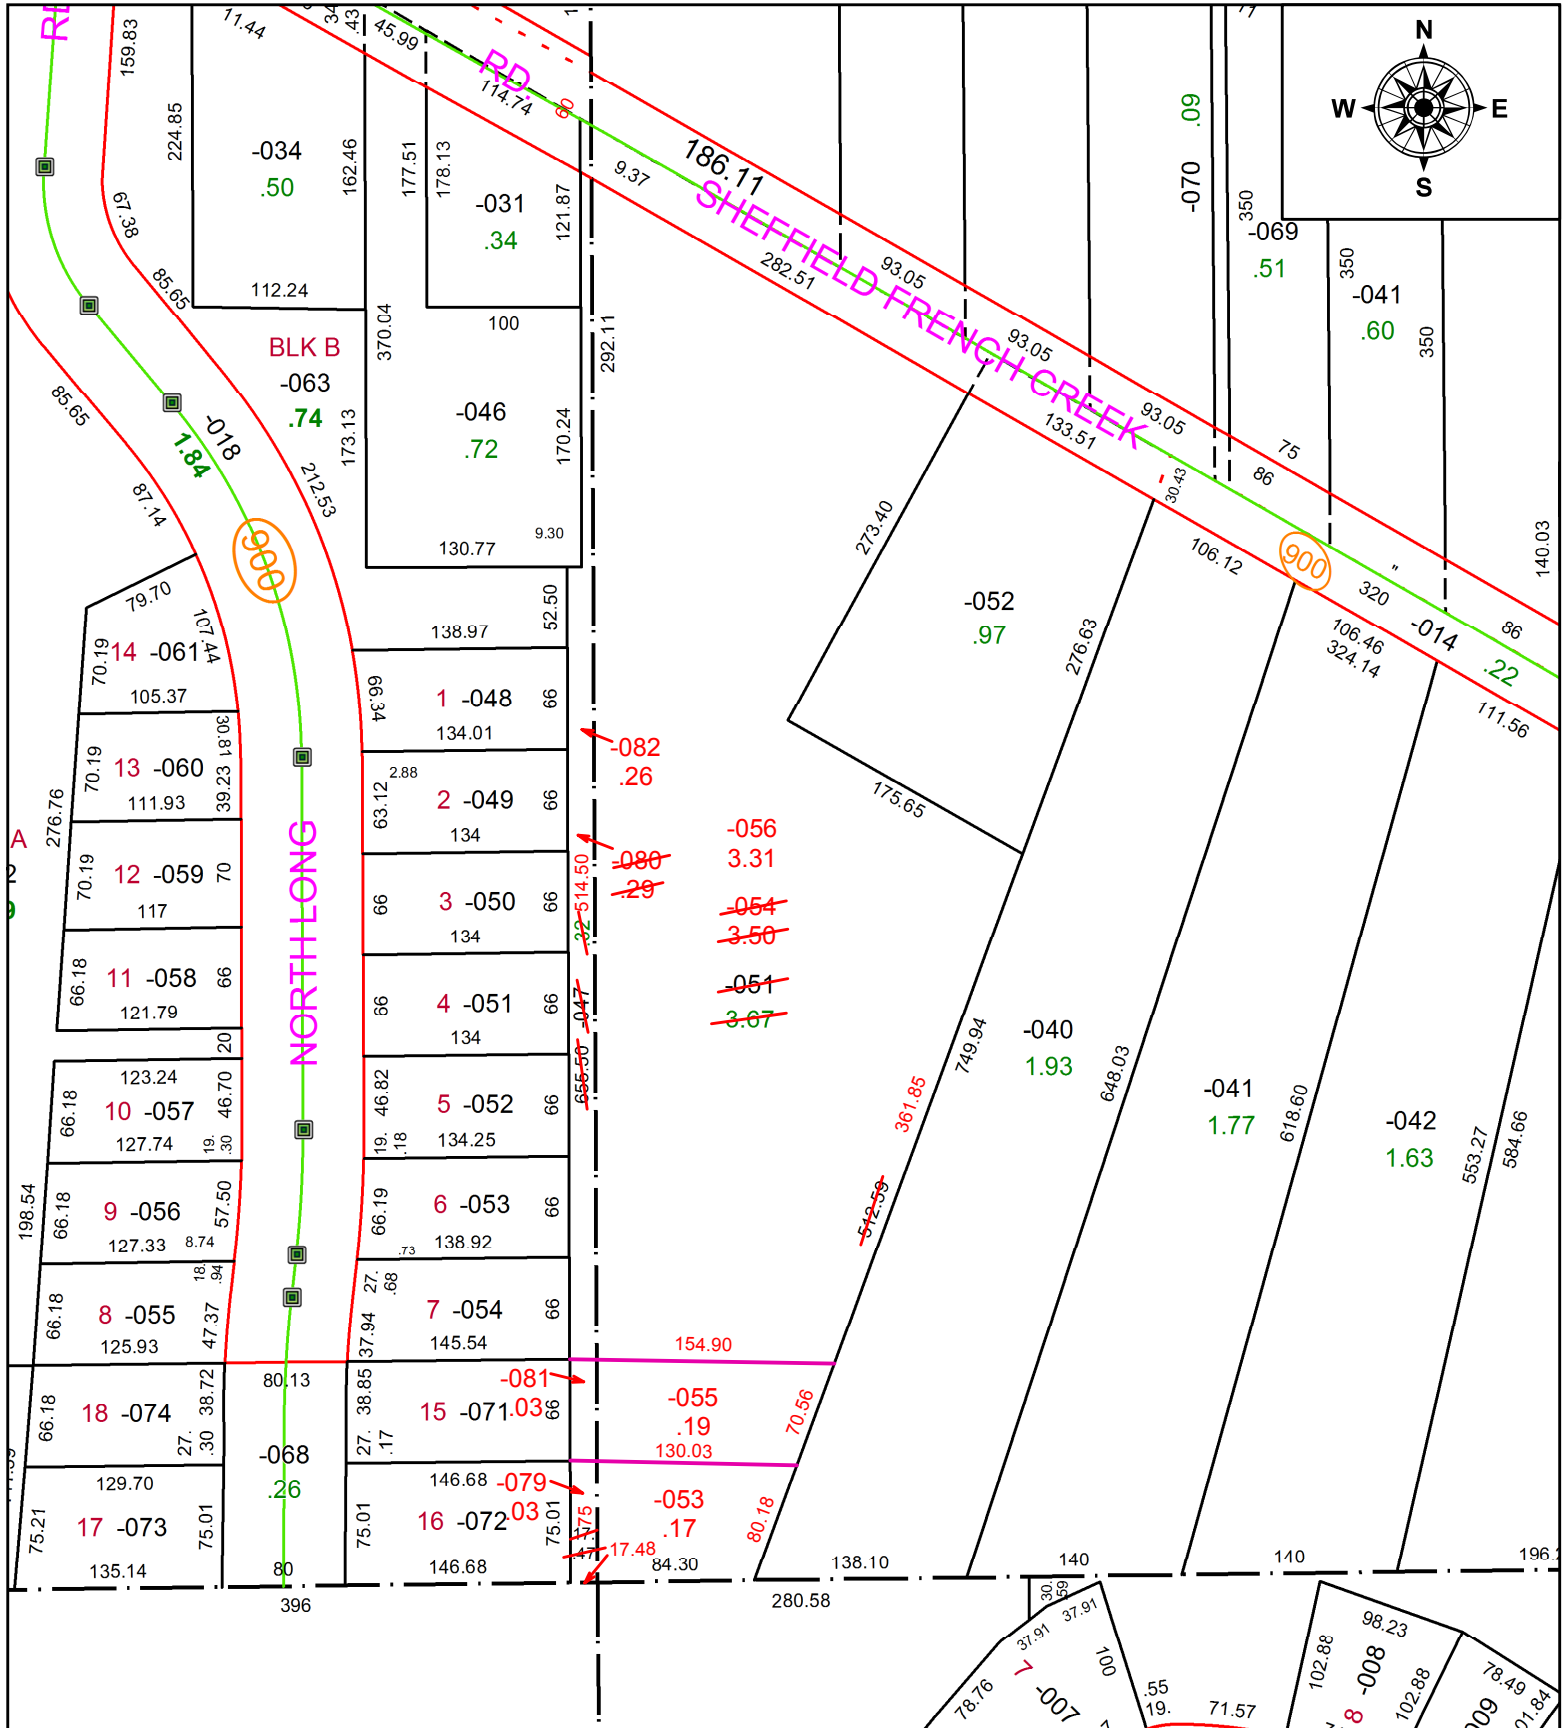

SPLITS/DEEDS PROCESSED
 LORAIN COUNTY TAX MAP DEPARTMENT
 226 MIDDLE AVE. ELYRIA, OH

SURVEYED BY: JAMES T. SAYLER
CLOSURE: 1:37,949
MAP PAGE(S): 4-00-010
APPROVED BY: RRM **DATE:** 6-25-20
SCALE: 1" = 125 **PRIOR INSTRUMENT:** 20160602605