


PARENT PARCEL: 18-00-021-104-015, -016

CHILD PARCEL:


STARTING POINT: INTERSECTION OF NORTH LINE OF CLAY ST. AND EAST LINE OF N. MAIN ST.

19-04144-C

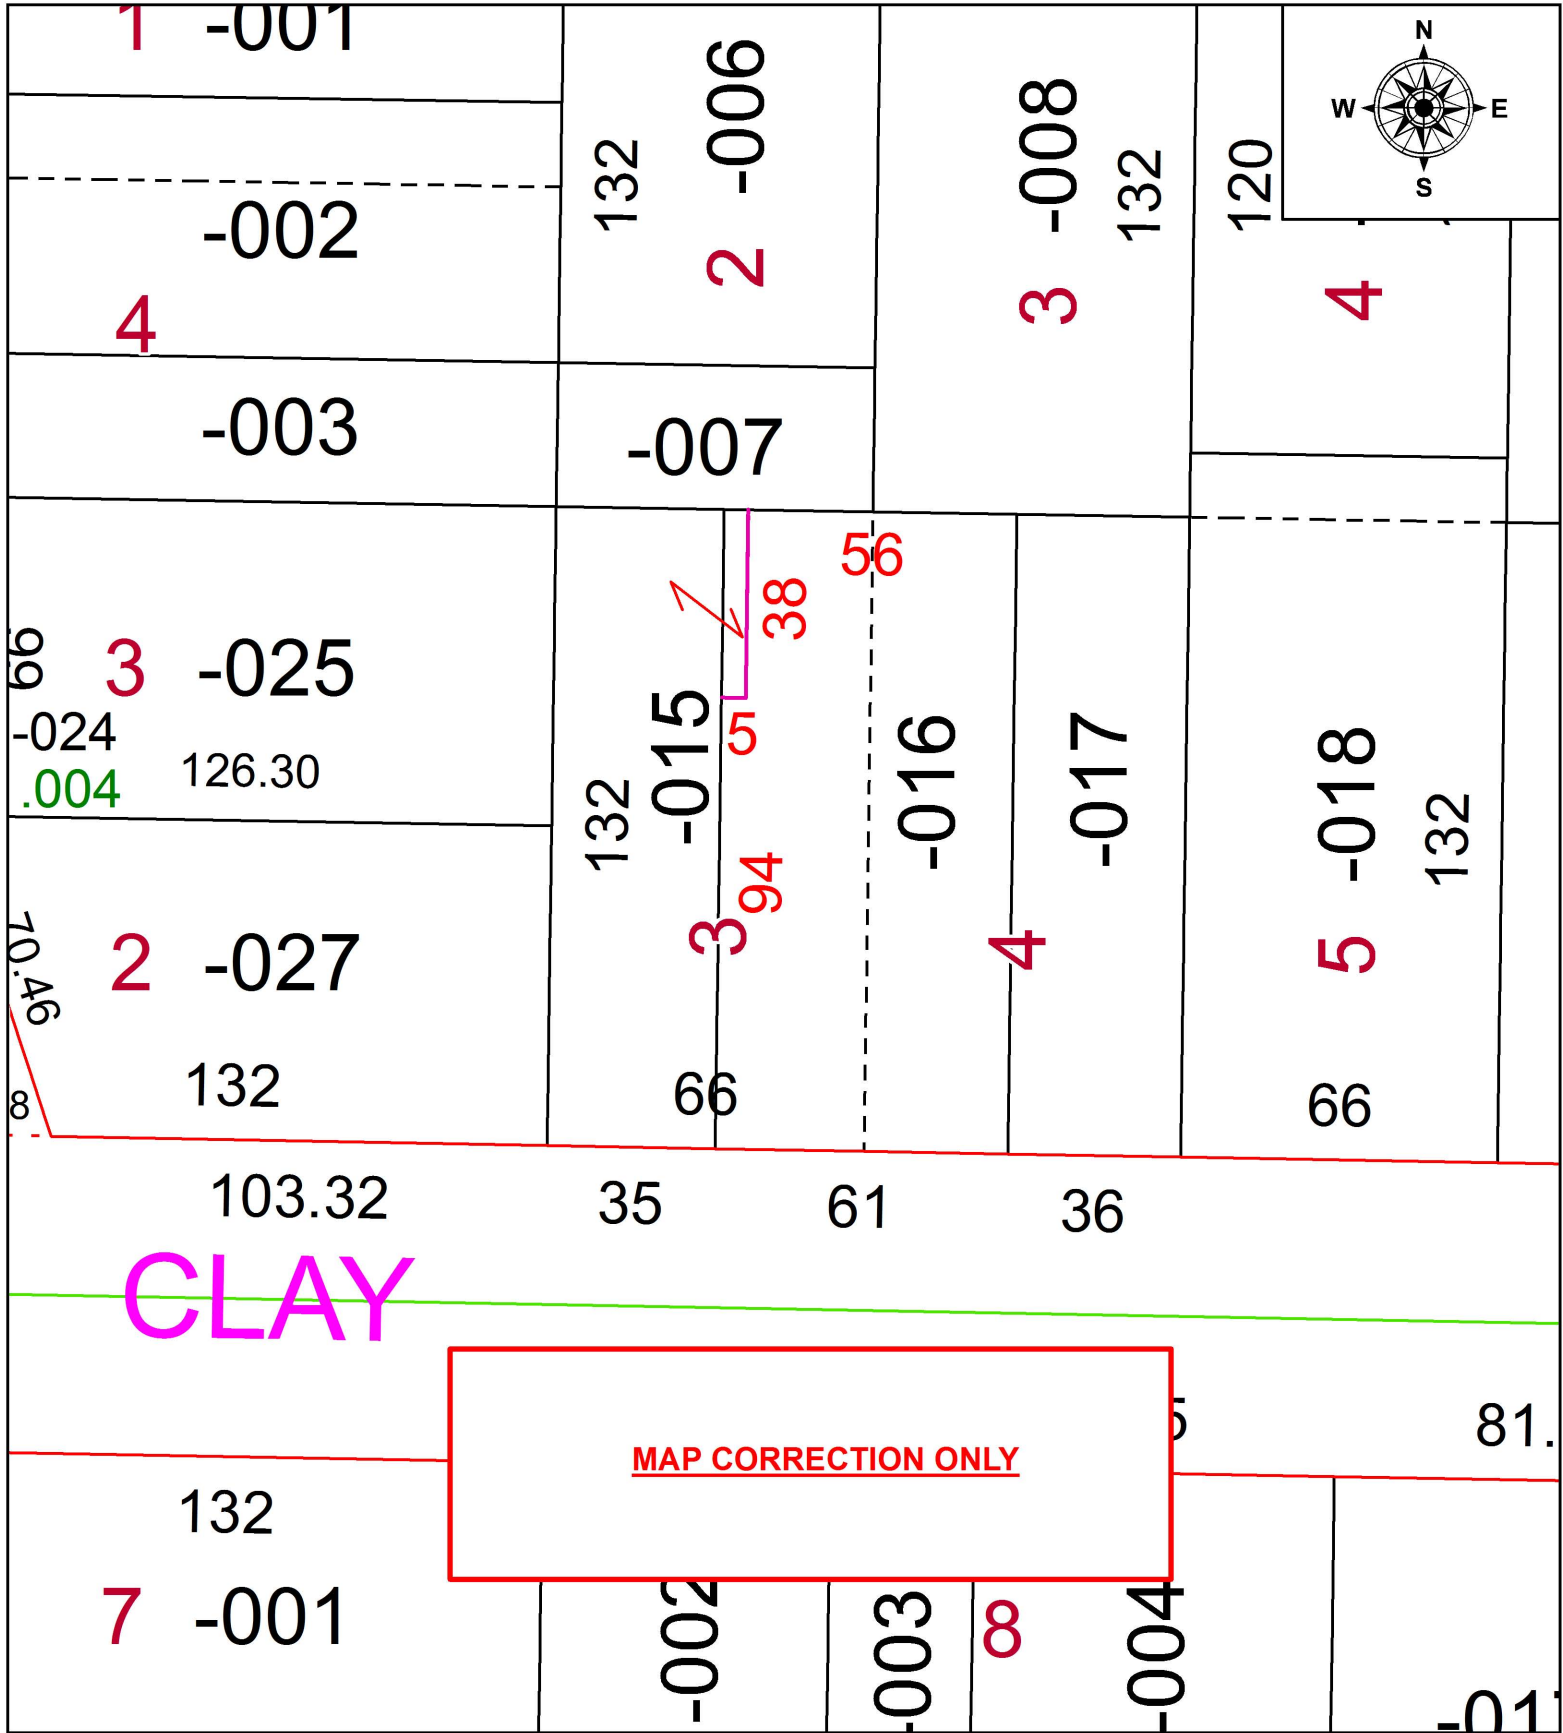

CLAY

MAP CORRECTION ONLY

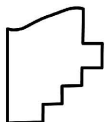

SPLITS/DEEDS PROCESSED
LORAIN COUNTY TAX MAP DEPARTMENT
226 MIDDLE AVE. ELYRIA, OH

SURVEYED BY:	N/A
CLOSURE:	N/A
MAP PAGE(S):	18-00-021
APPROVED BY:	RRM DATE: 7-16-19
SCALE:	1" = 40' PRIOR INSTRUMENT: 20190720680