
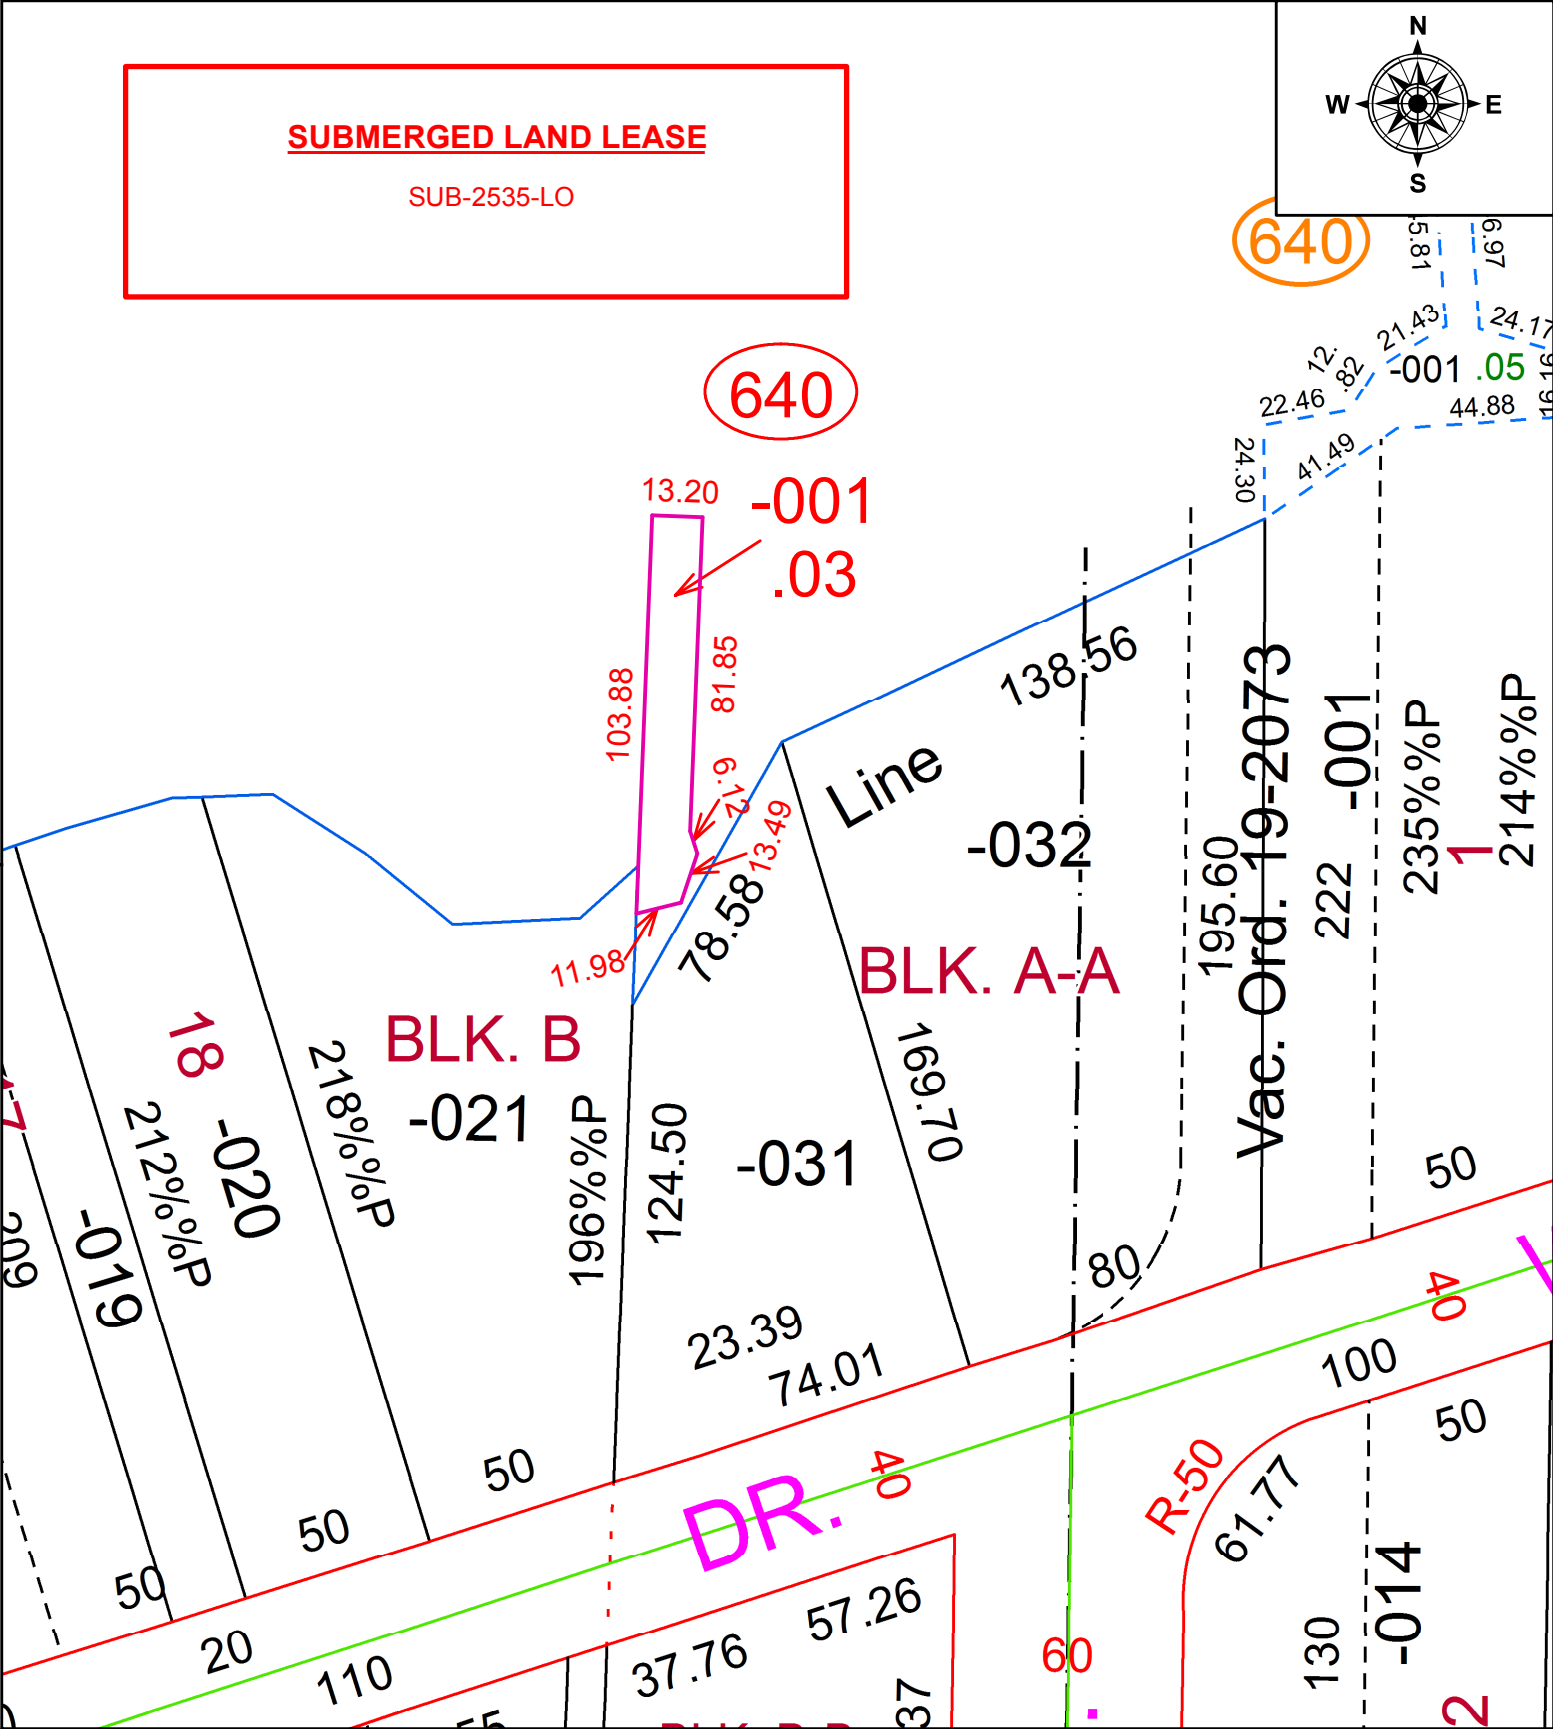
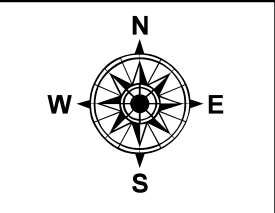


PARENT PARCEL: ADD TO DUP.
CHILD PARCEL: 03-00-034-640-001
STARTING POINT: INTERSECTION OF NORTH LINE OF EDGEWATER DR. AND WEST LINE OF BLOCK A-A

20-04146

SUBMERGED LAND LEASE
SUB-2535-LO

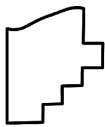


SPLITS/DEEDS PROCESSED
LORAIN COUNTY TAX MAP DEPARTMENT
226 MIDDLE AVE. ELYRIA, OH

SURVEYED BY: M.G. HURA
CLOSURE: 1:10,223
MAP PAGE(S): 3-00-034
APPROVED BY: RRM DATE: 7-9-20
SCALE: 1" = 50' PRIOR INSTRUMENT: 20140493960