


PARENT PARCEL: 04-00-015-109-023, -073

CHILD PARCEL: 04-00-015-109-171, -172

STARTING POINT: INTERSECTION OF C/L OF CENTER RD, AND SOUTH LINE OF SEC. 15

20-04149

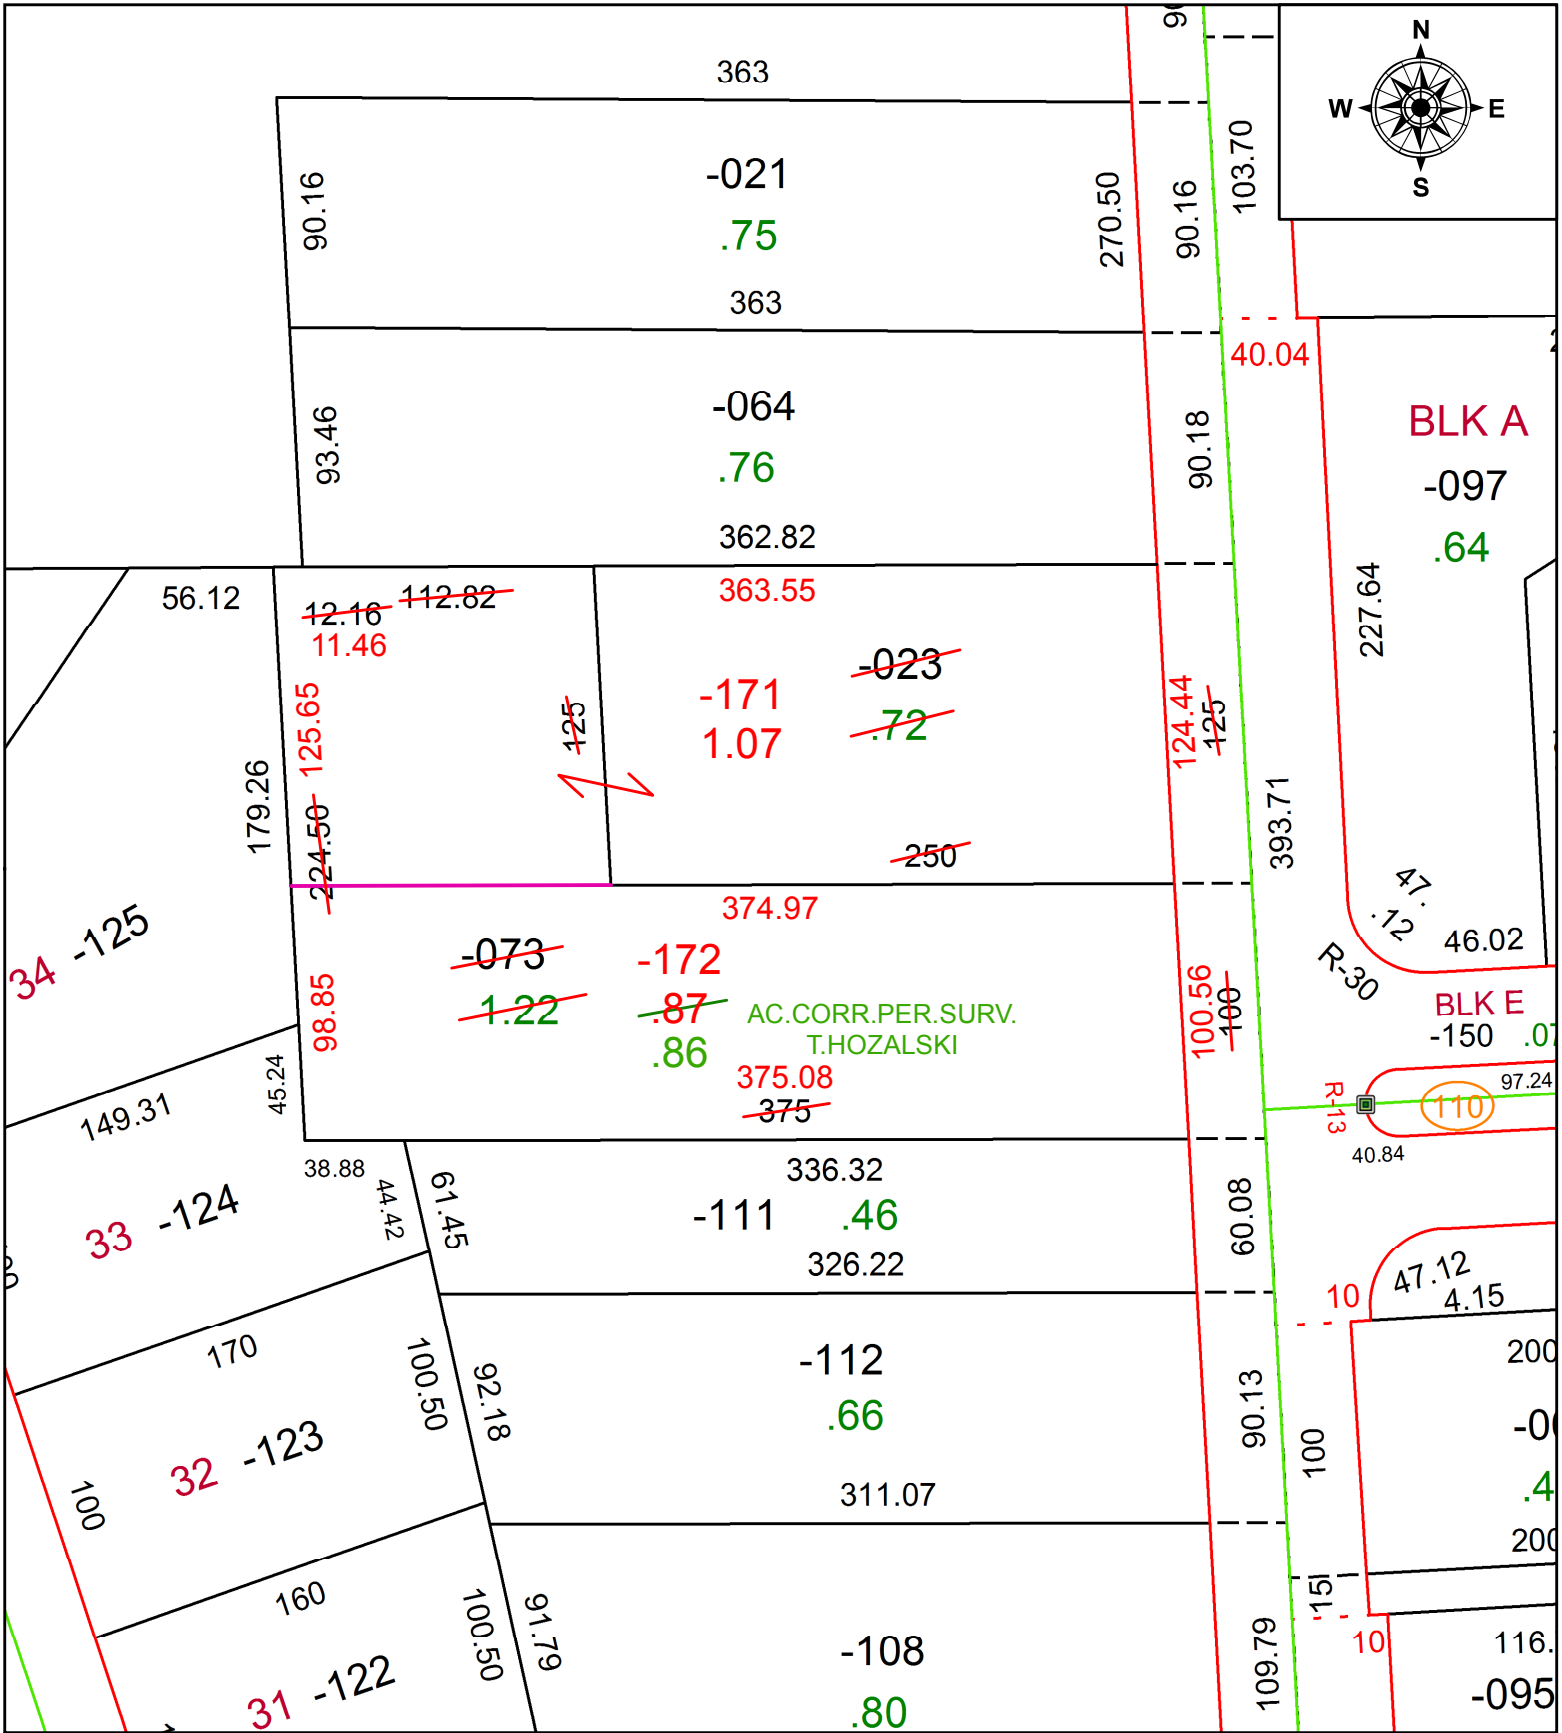

**SPLITS/DEEDS PROCESSED**  
 LORAIN COUNTY TAX MAP DEPARTMENT  
 226 MIDDLE AVE. ELYRIA, OH

SURVEYED BY: TIMOTHY D. HOZALSKI

CLOSURE: 1:149,502

MAP PAGE(S): 4-00-015

APPROVED BY: RRM DATE: 7-15-20

SCALE: 1" = 75 PRIOR INSTRUMENT: 20200751398