
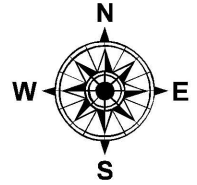


PARENT PARCEL: 04-00-018-183-014

CHILD PARCEL: 04-00-018-183-030, -031


STARTING POINT: INTERSECTION OF C/L OF AVON BELDEN RD. AND NORTH LINE OF BELDEN PARK SUB. NO.2

19-04151-C

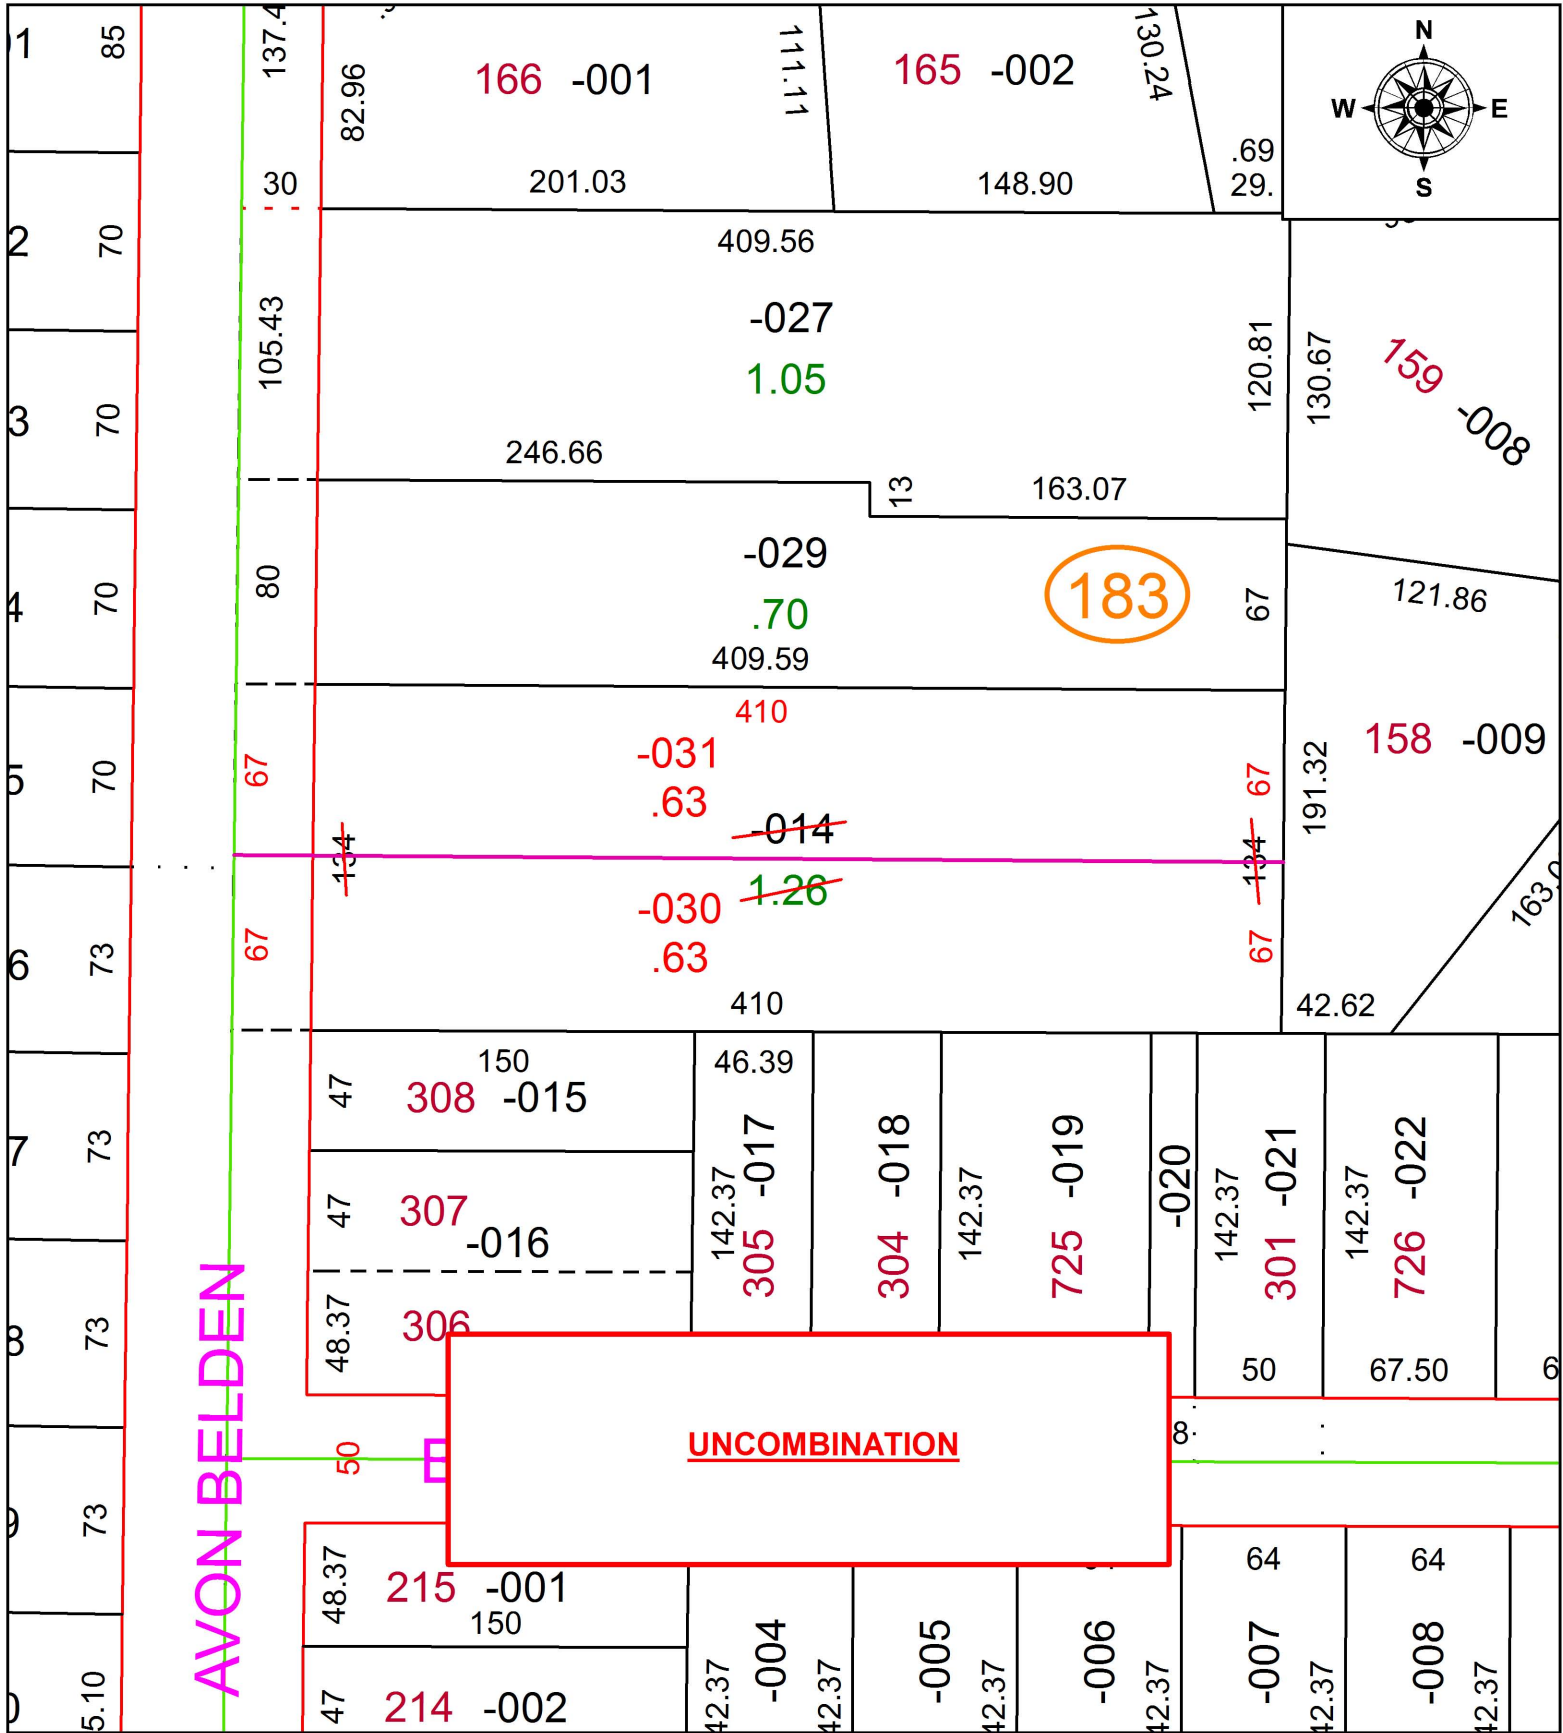

AVON BELDEN

**UNCOMBINATION**

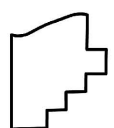

**SPLITS/DEEDS PROCESSED**  
 LORAIN COUNTY TAX MAP DEPARTMENT  
 226 MIDDLE AVE. ELYRIA, OH

SURVEYED BY: J.W. WARDEN  
 CLOSURE: 1:2147483648  
 MAP PAGE(S): 4-00-018  
 APPROVED BY: RRM DATE: 7-22-19  
 SCALE: 1" = 75' PRIOR INSTRUMENT: 20040045082