


PARENT PARCEL: 12-00-093-000-004

CHILD PARCEL:

STARTING POINT: NORTHEAST CORNER OF O.L.93

19-04153-A

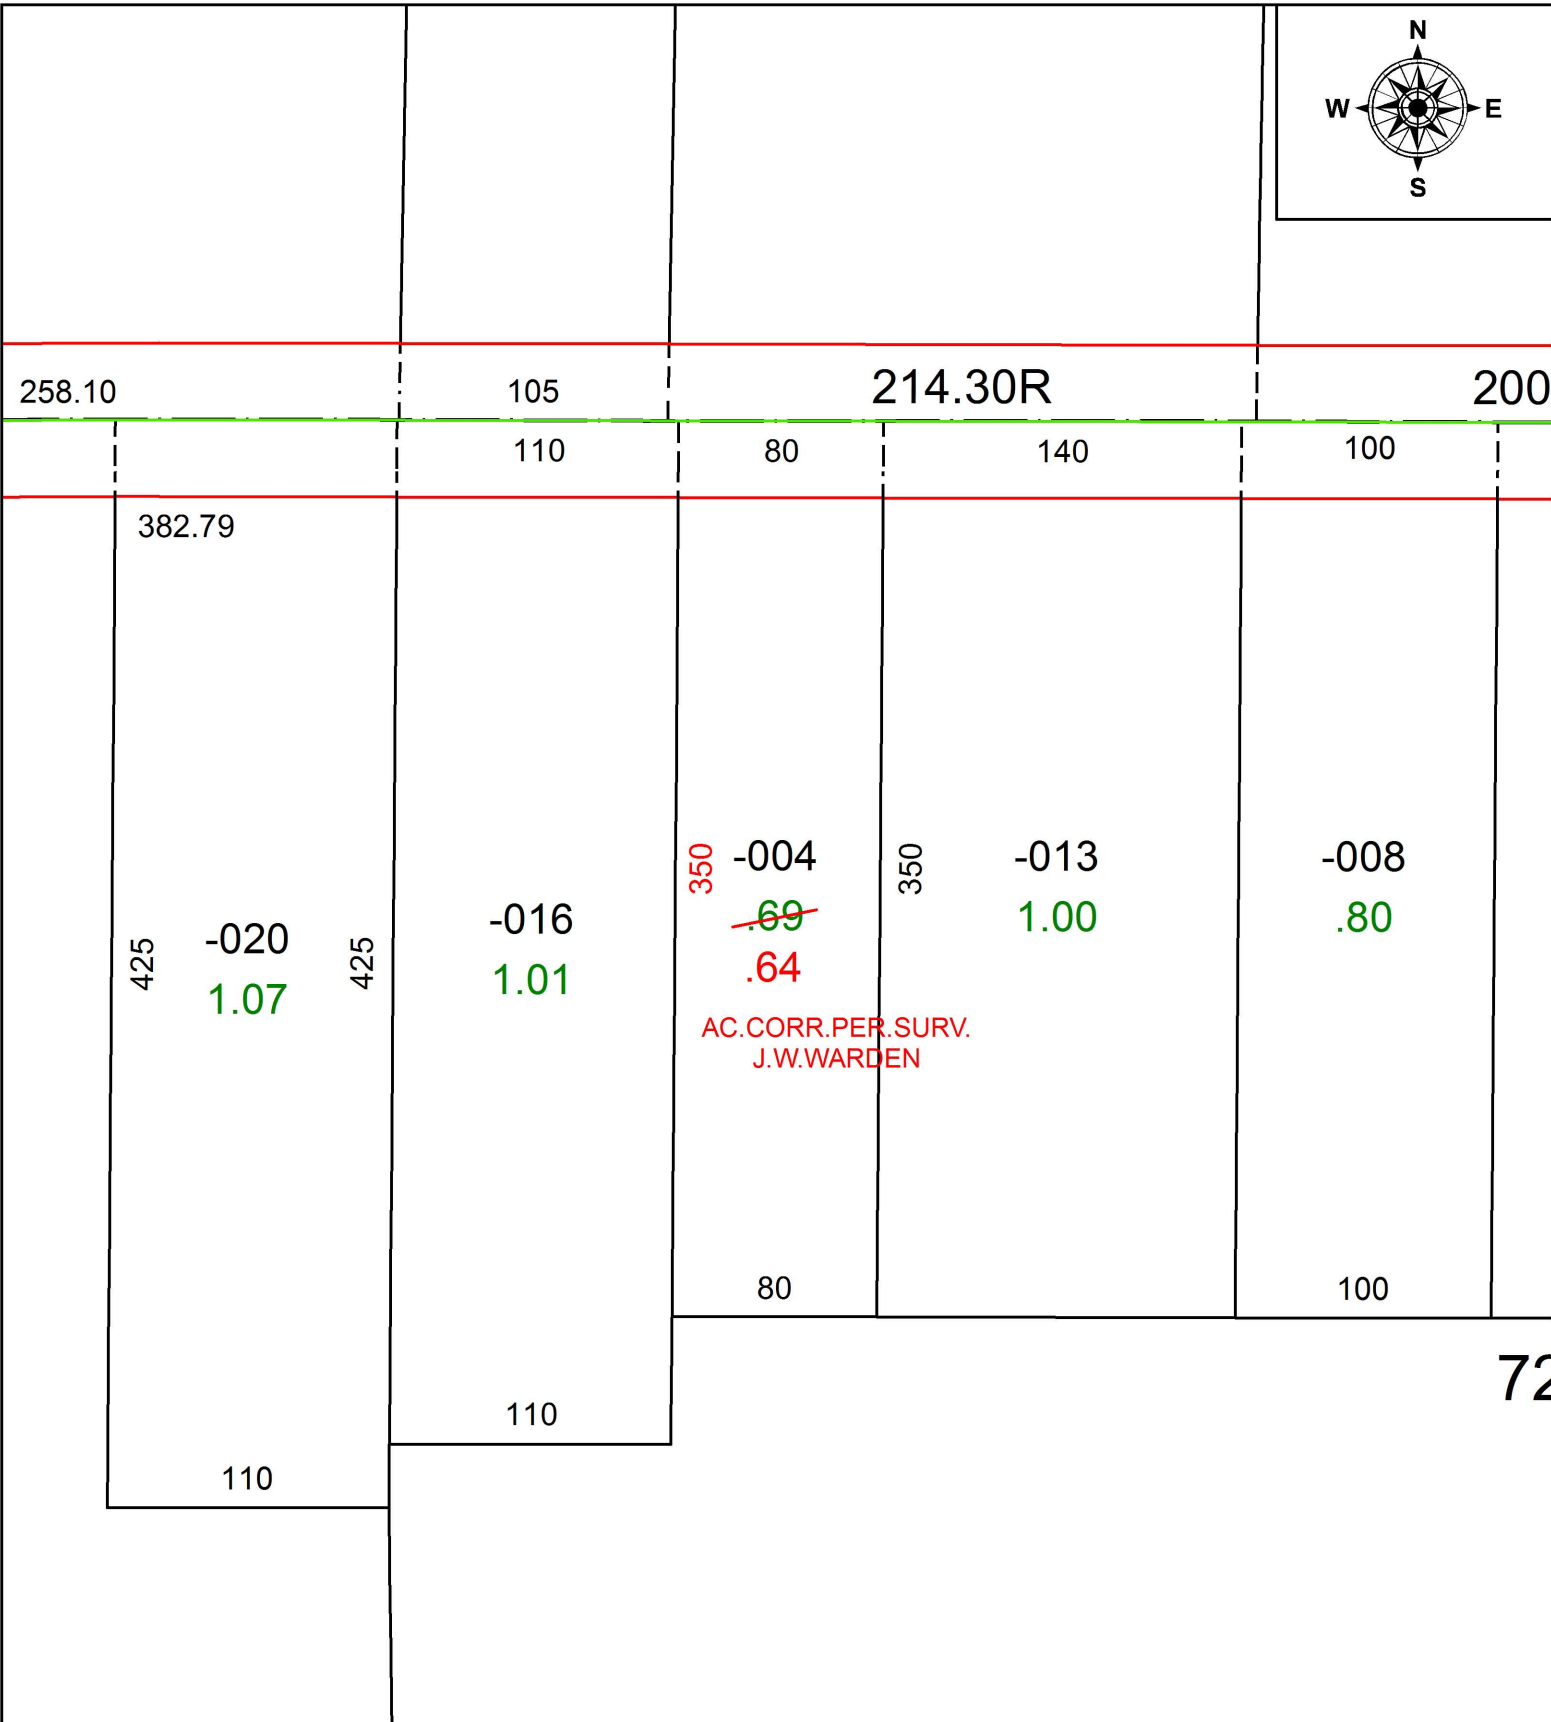

SPLITS/DEEDS PROCESSED
 LORAIN COUNTY TAX MAP DEPARTMENT
 226 MIDDLE AVE. ELYRIA, OH

SURVEYED BY: J.W. WARDEN
 CLOSURE: 1:2147483648
 MAP PAGE(S): 12-00-093
 APPROVED BY: RRM DATE: 7-23-19
 SCALE: 1" = 75' PRIOR INSTRUMENT: DV 1341/605